

MAP
OF
LEMON MINE

Property of
CAMBRIA IRON Co.

July 28-1897 A. L. Brown
M. J. Thayer
Mining Eng.

Scale - 400' = 1 inch -
April 18 - 1903.

BLAIR

COUNTY.

JOHN CUMMINS WARRANT.

KUNKLE WARRANT.
SHOENBERGER HEIRS.

GEORGE JOHN WARRANT.

THOMAS JACKSON.
IMPROVEMENT.

ADAM GLASS.
Now CAMBRIA STEEL Co.

THOMAS BOND WARRANT.

JAMES KINNEER WARRANT.

CAMBRIA

COUNTY.


JOHN TAYLOR WARRANT.

ROBERT GRAY WARRANT.

JOHN LEMON TRACT.
WILLIAM KINNIER WARRANT.

DRAWER No.
SHEET "

JOHN GARY WARRANT.

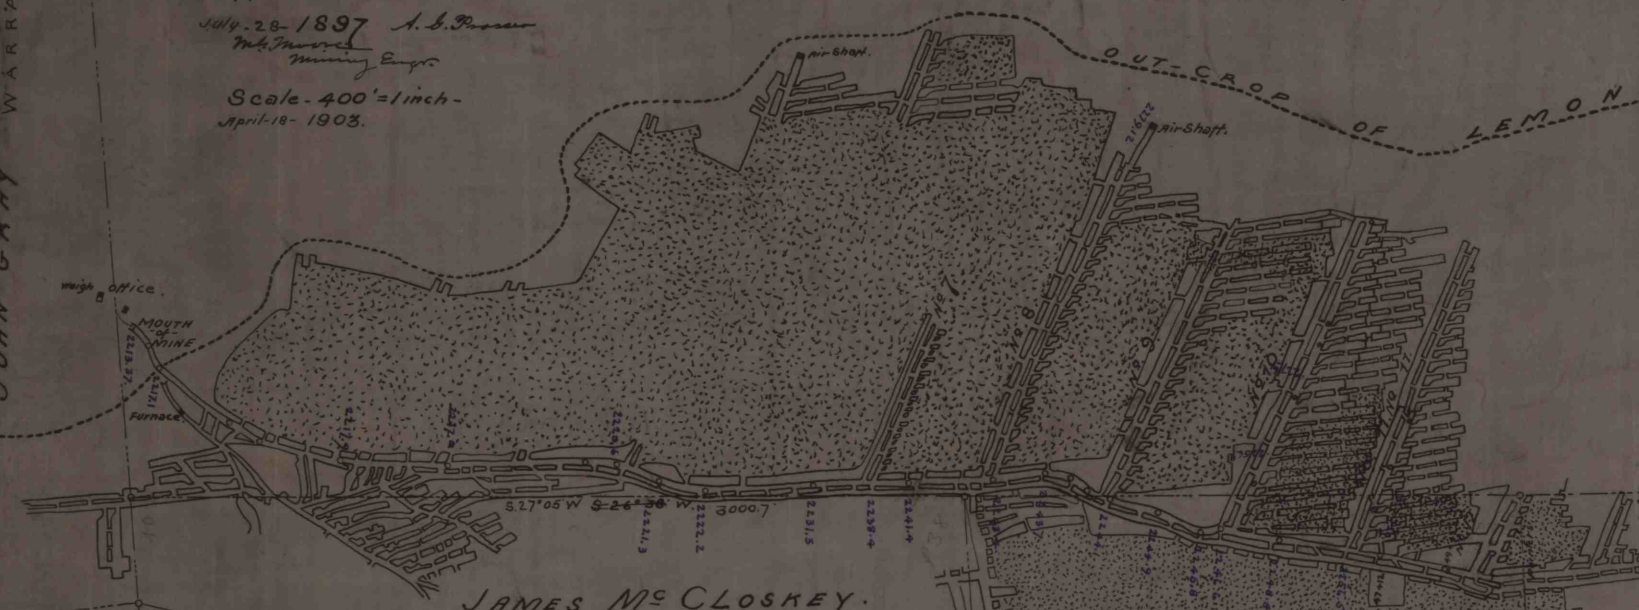

JAMES McCLOSKEY.

GEORGE W. PATTERSON

JAMES McCLOSKEY.