


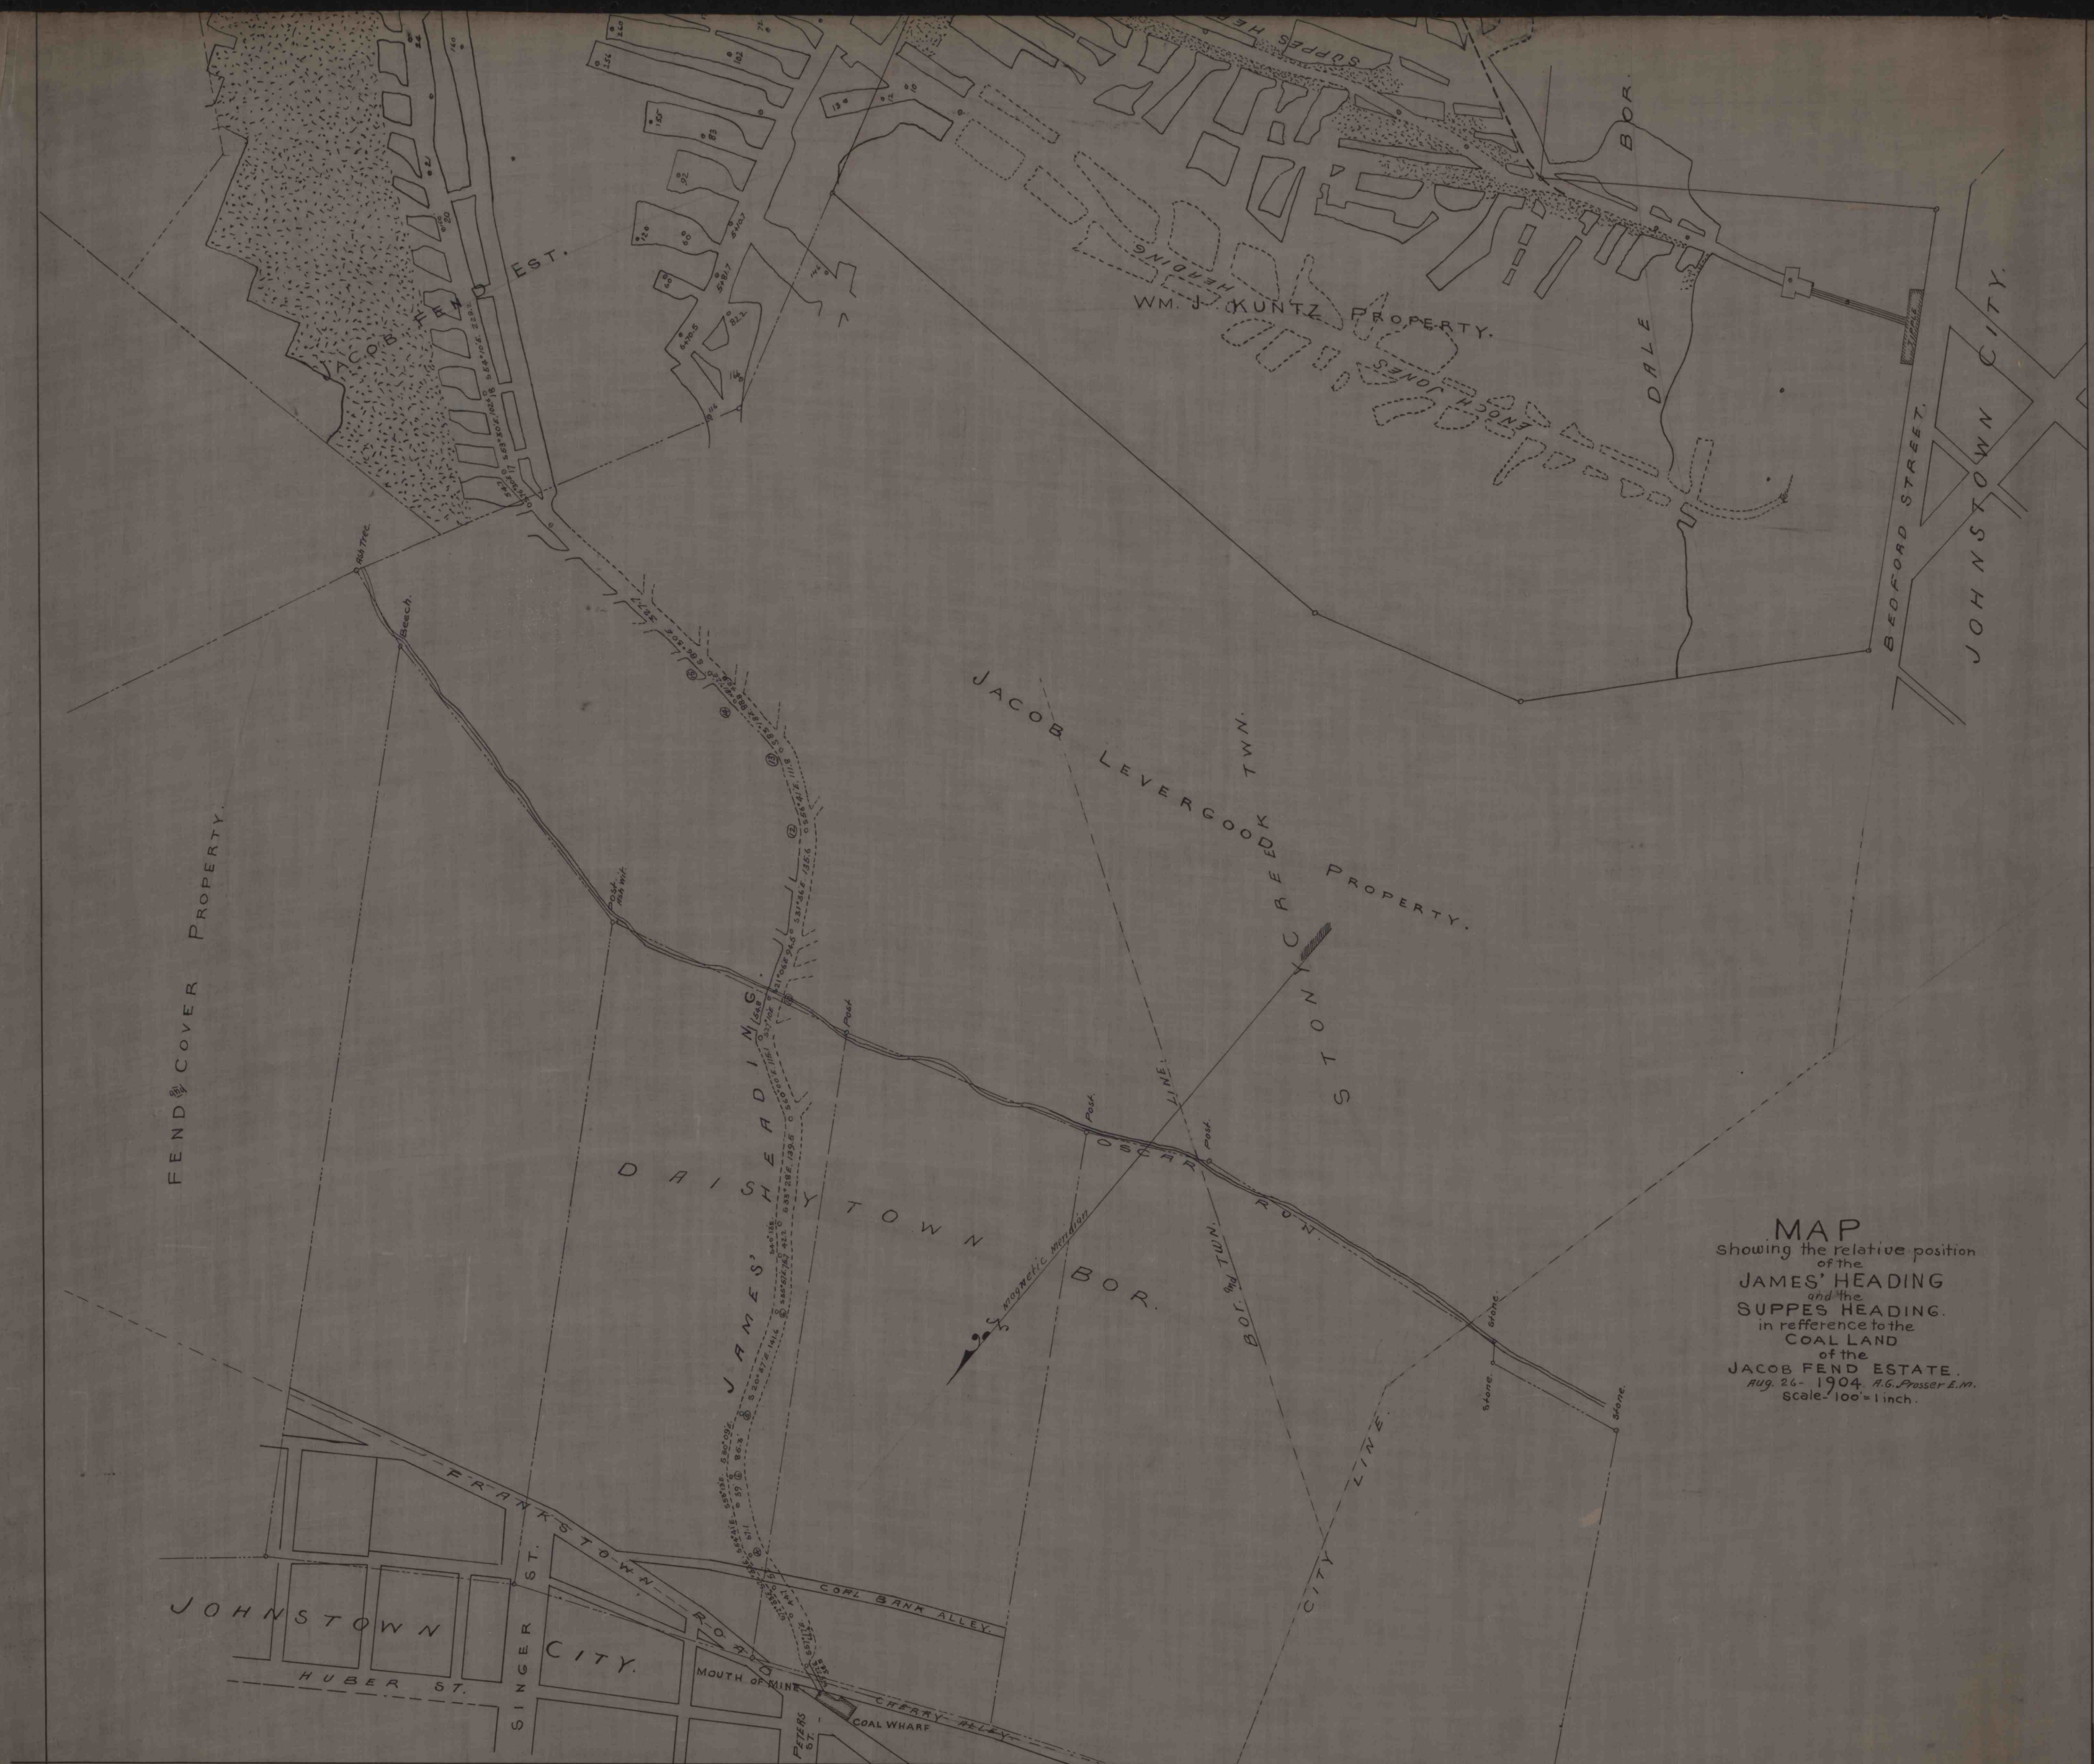

MAP
showing the relative position
of the
JAMES' HEADING
and the
SUPPES HEADING.
in reference to the
COAL LAND
of the
JACOB FEND ESTATE.
Aug. 26- 1904. H.G. Prasser E.M.
Scale- 100' = 1 inch.