


Jacob Fend Estate.

N 78° 15' E
927.5

W. J. KUNTZ

Formerly

CAMBRIA IRON COMPANY.

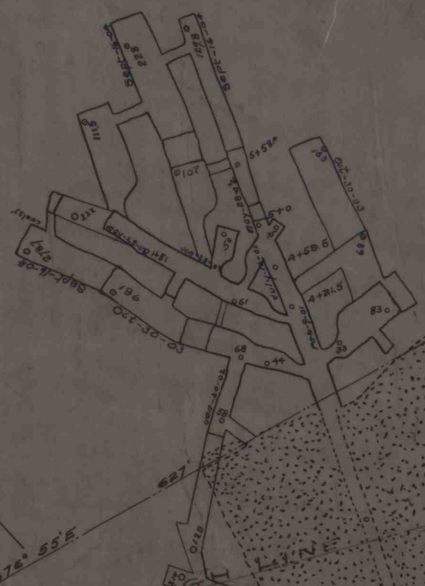

DALE BOROUGH LINE

S 73° 20' E 1320' stone

S 58° 55' E 296' 2'

MAP
of
A. ADAIR'S MINE
SITUATED ON
GEORGETOWN
TOWARD
MAY 28-1902
SCALE
1" = 100'

S. A. G. - B