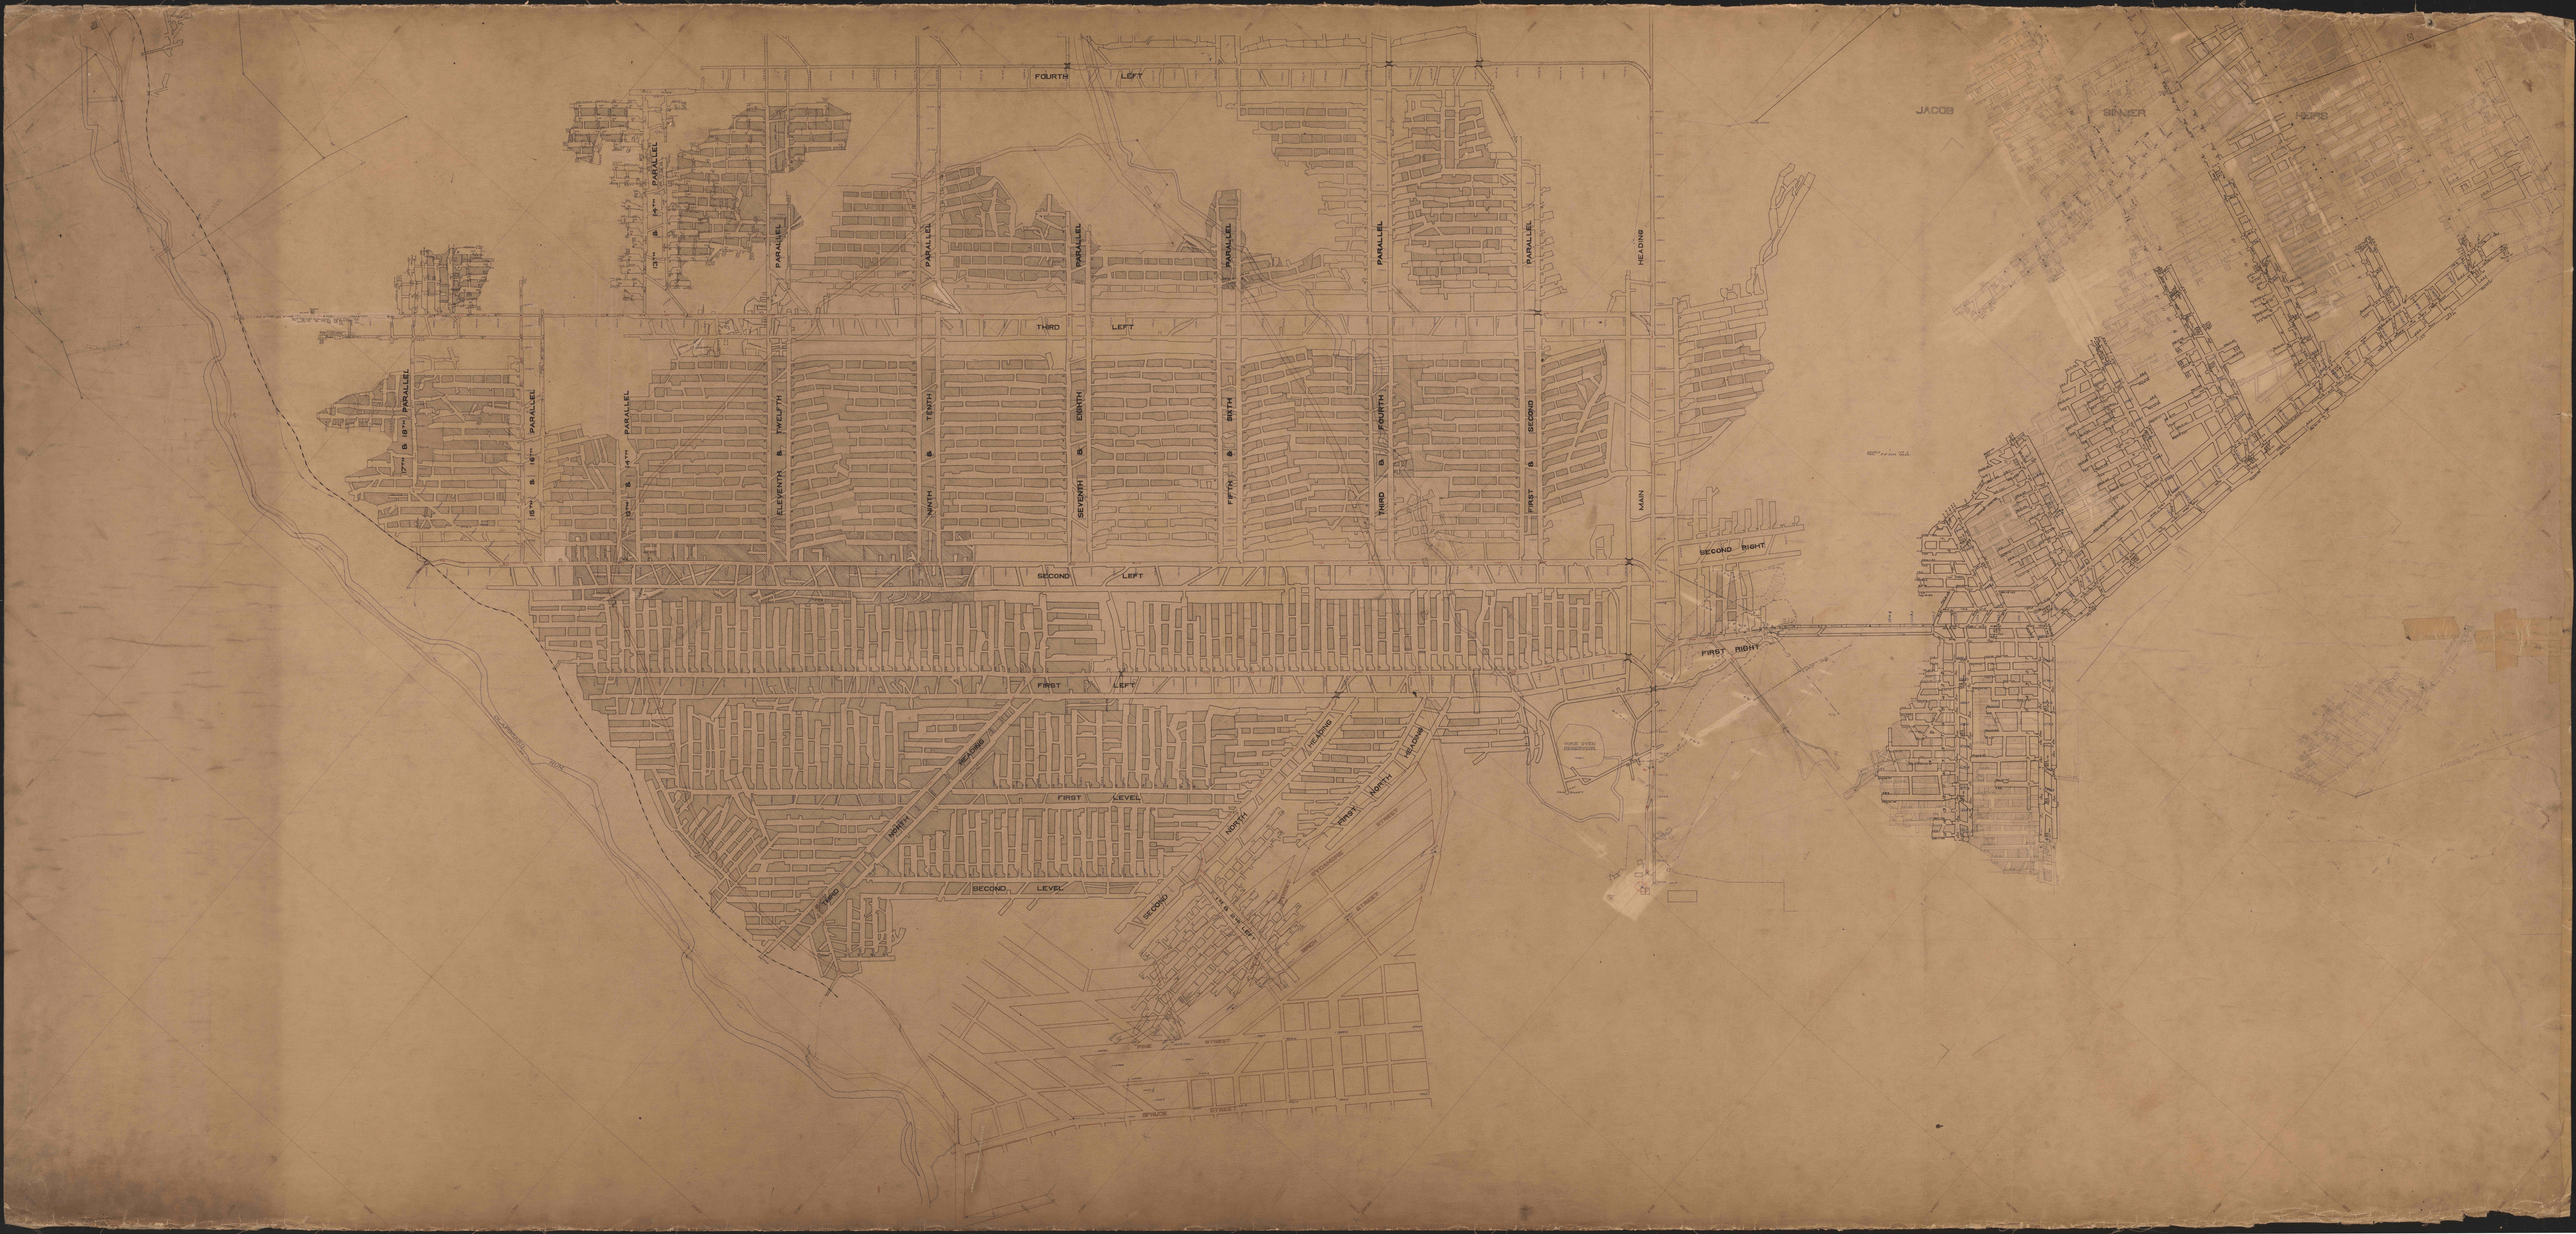
FOURTH LEFT
THIRD LEFT
SECOND LEFT
FIRST LEFT
FIRST LEVEL
SECOND LEVEL
THIRD LEVEL
SECOND RIGHT
FIRST RIGHT
HEADING
MAIN
PARALLEL
13TH & 14TH PARALLEL
15TH & 16TH PARALLEL
17TH & 18TH PARALLEL
ELEVENTH & TWELFTH
NINTH & TENTH
SEVENTH & EIGHTH
FIFTH & SIXTH
THIRD & FOURTH
FIRST & SECOND
JACOB
SINNER
ALPS
CLEARFIELD RUN
PINE STREET
SPRUCE STREET