


MAP OF
JUDITH NO. 1, 2 & 4
Colonial Iron Co.

Scale: 1 inch = 100 feet
Traced Dec. 24th, 1918 by A.S.D.

1918

SIX MILE RUN

MT. EQUITY MINE

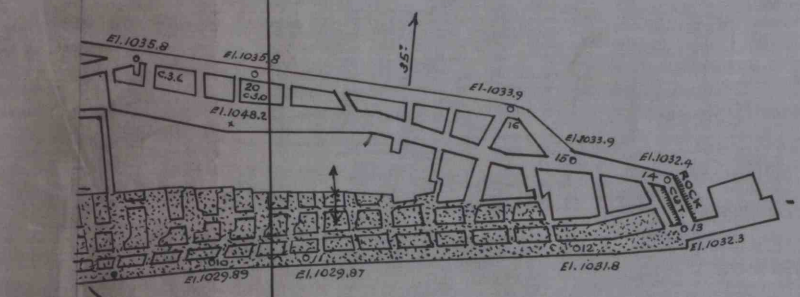

CAMBRIA IRON COMPANY

COLONIAL IRON COMPANY.

CAMBRIA IRON COMPANY.

CARBON COAL AND COKE COMPANY.

COLONIAL IRON COMPANY.

S.B.5.A.

S.B.5.A.