


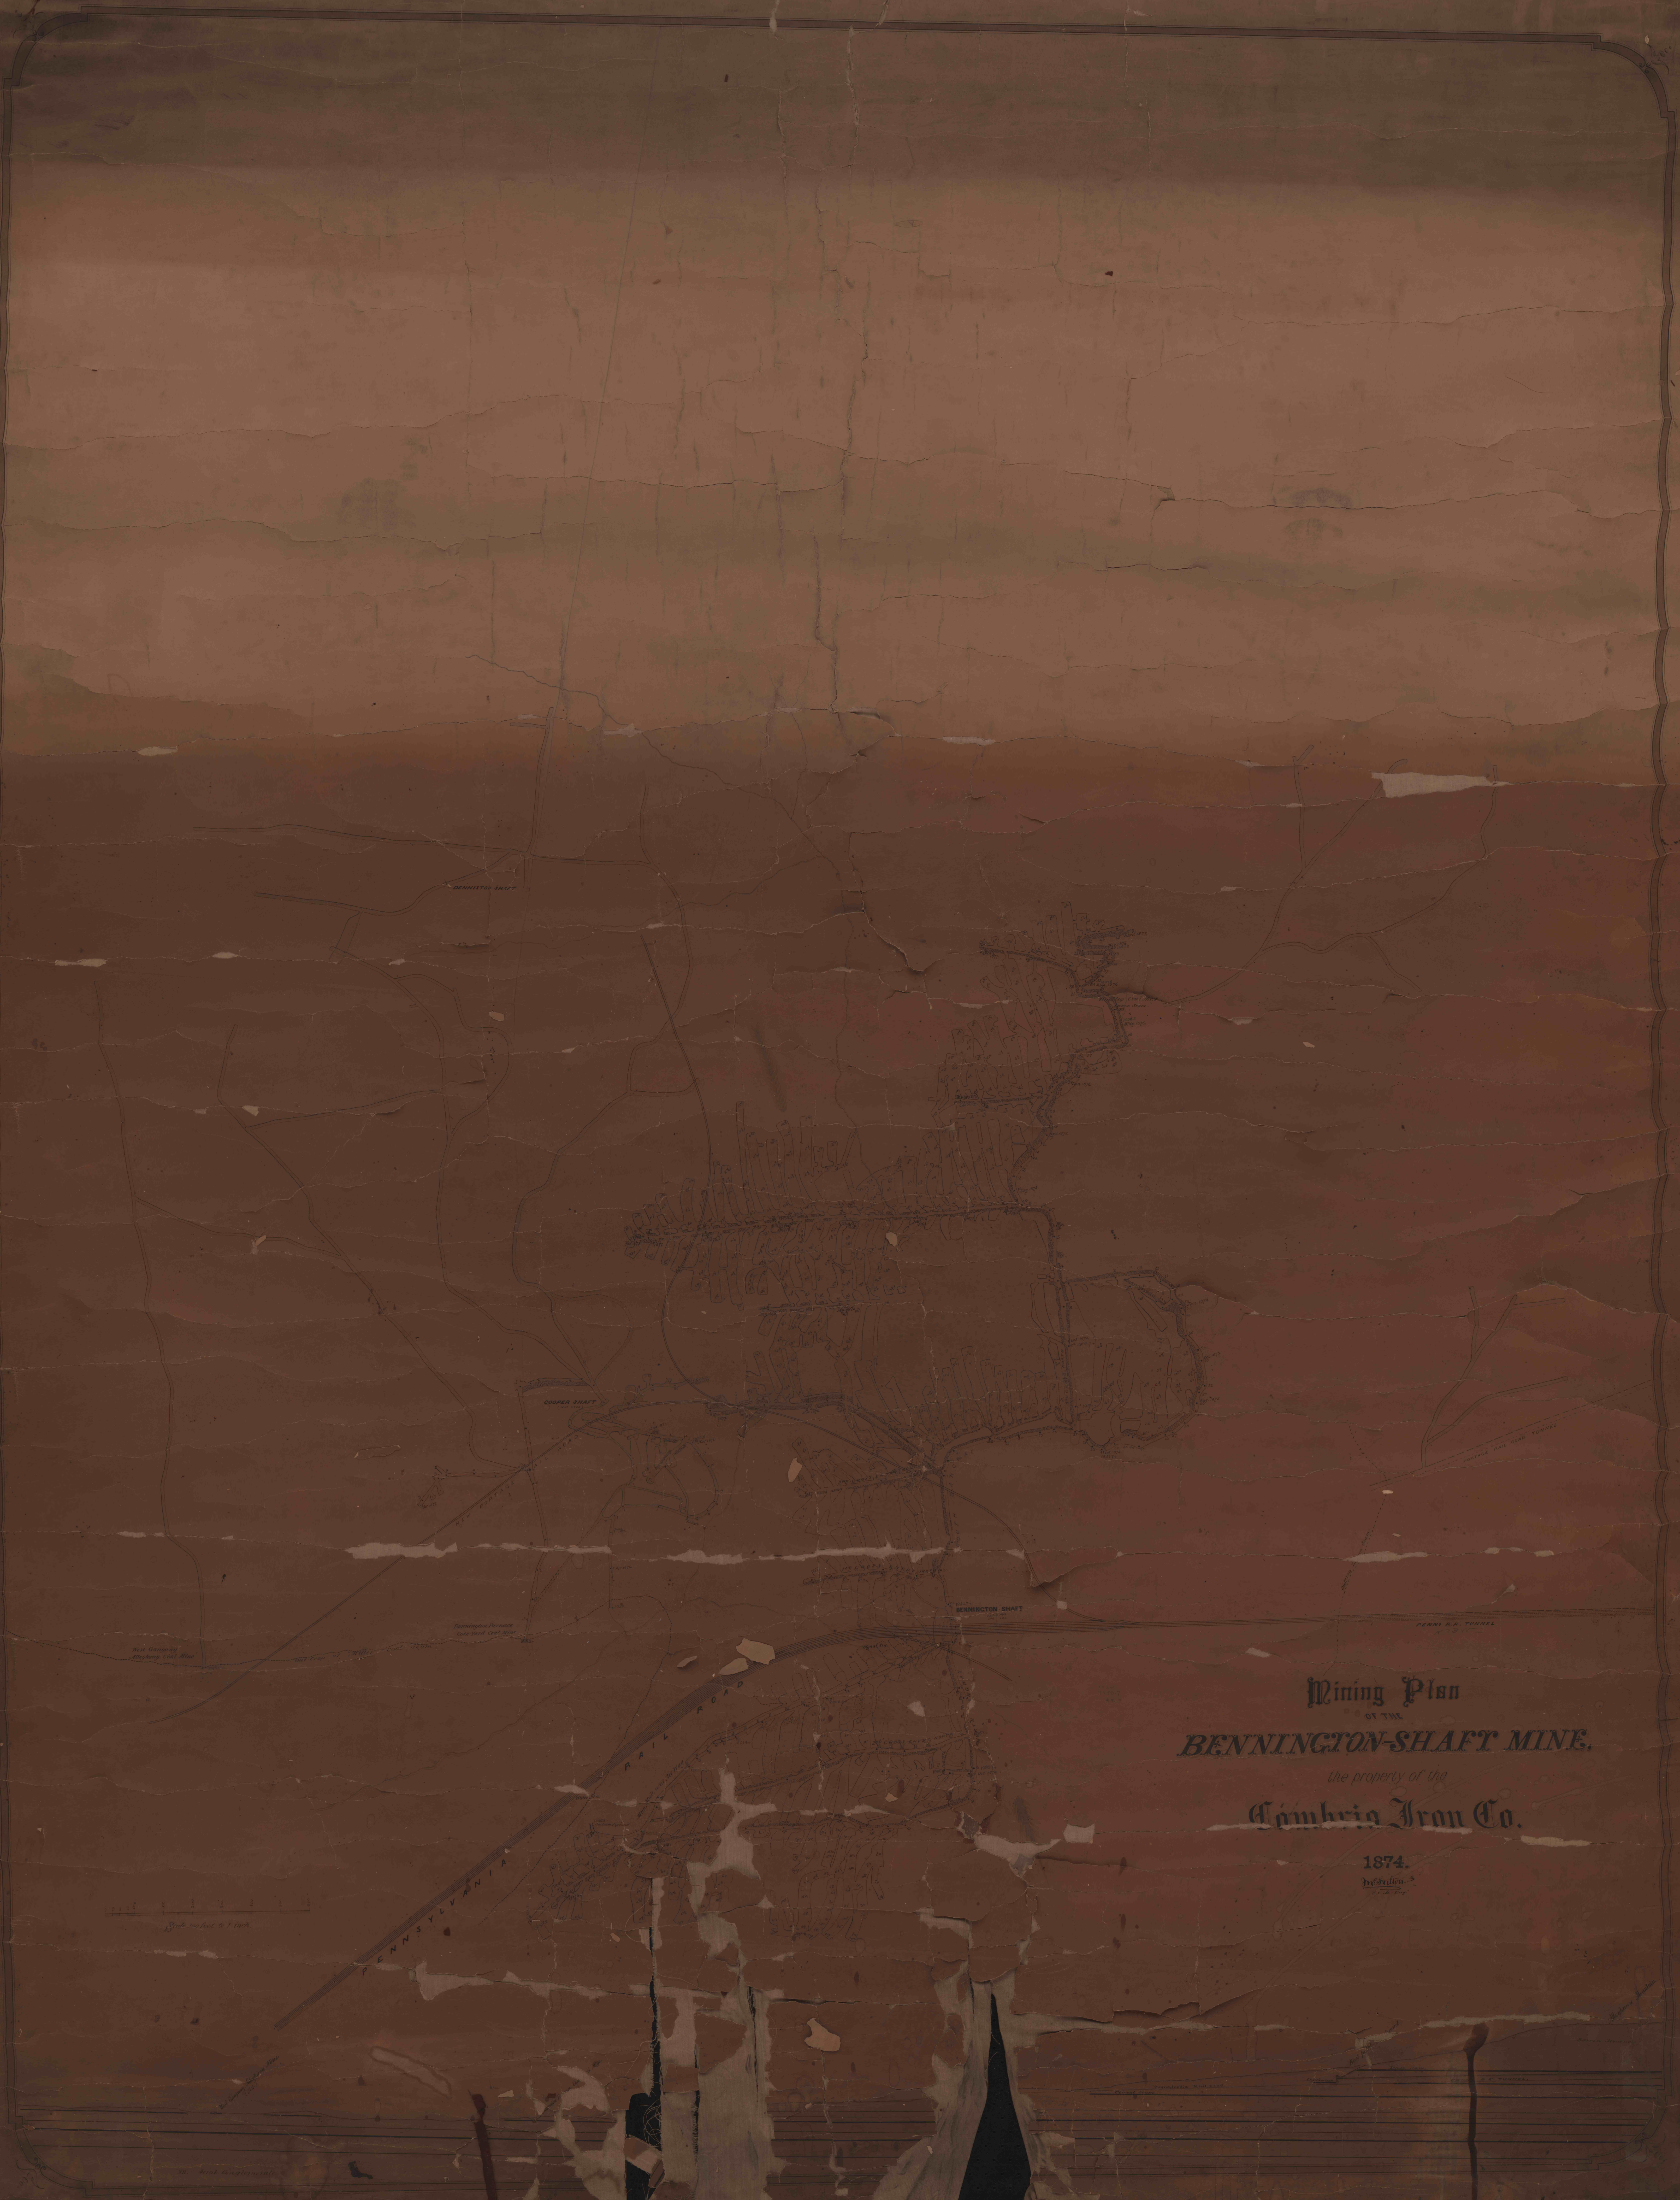

Mining Plan
OF THE
BENNINGTON-SHAFT MINE.
the property of the
Cambria Iron Co.

1874.

W. H. PIERCE