


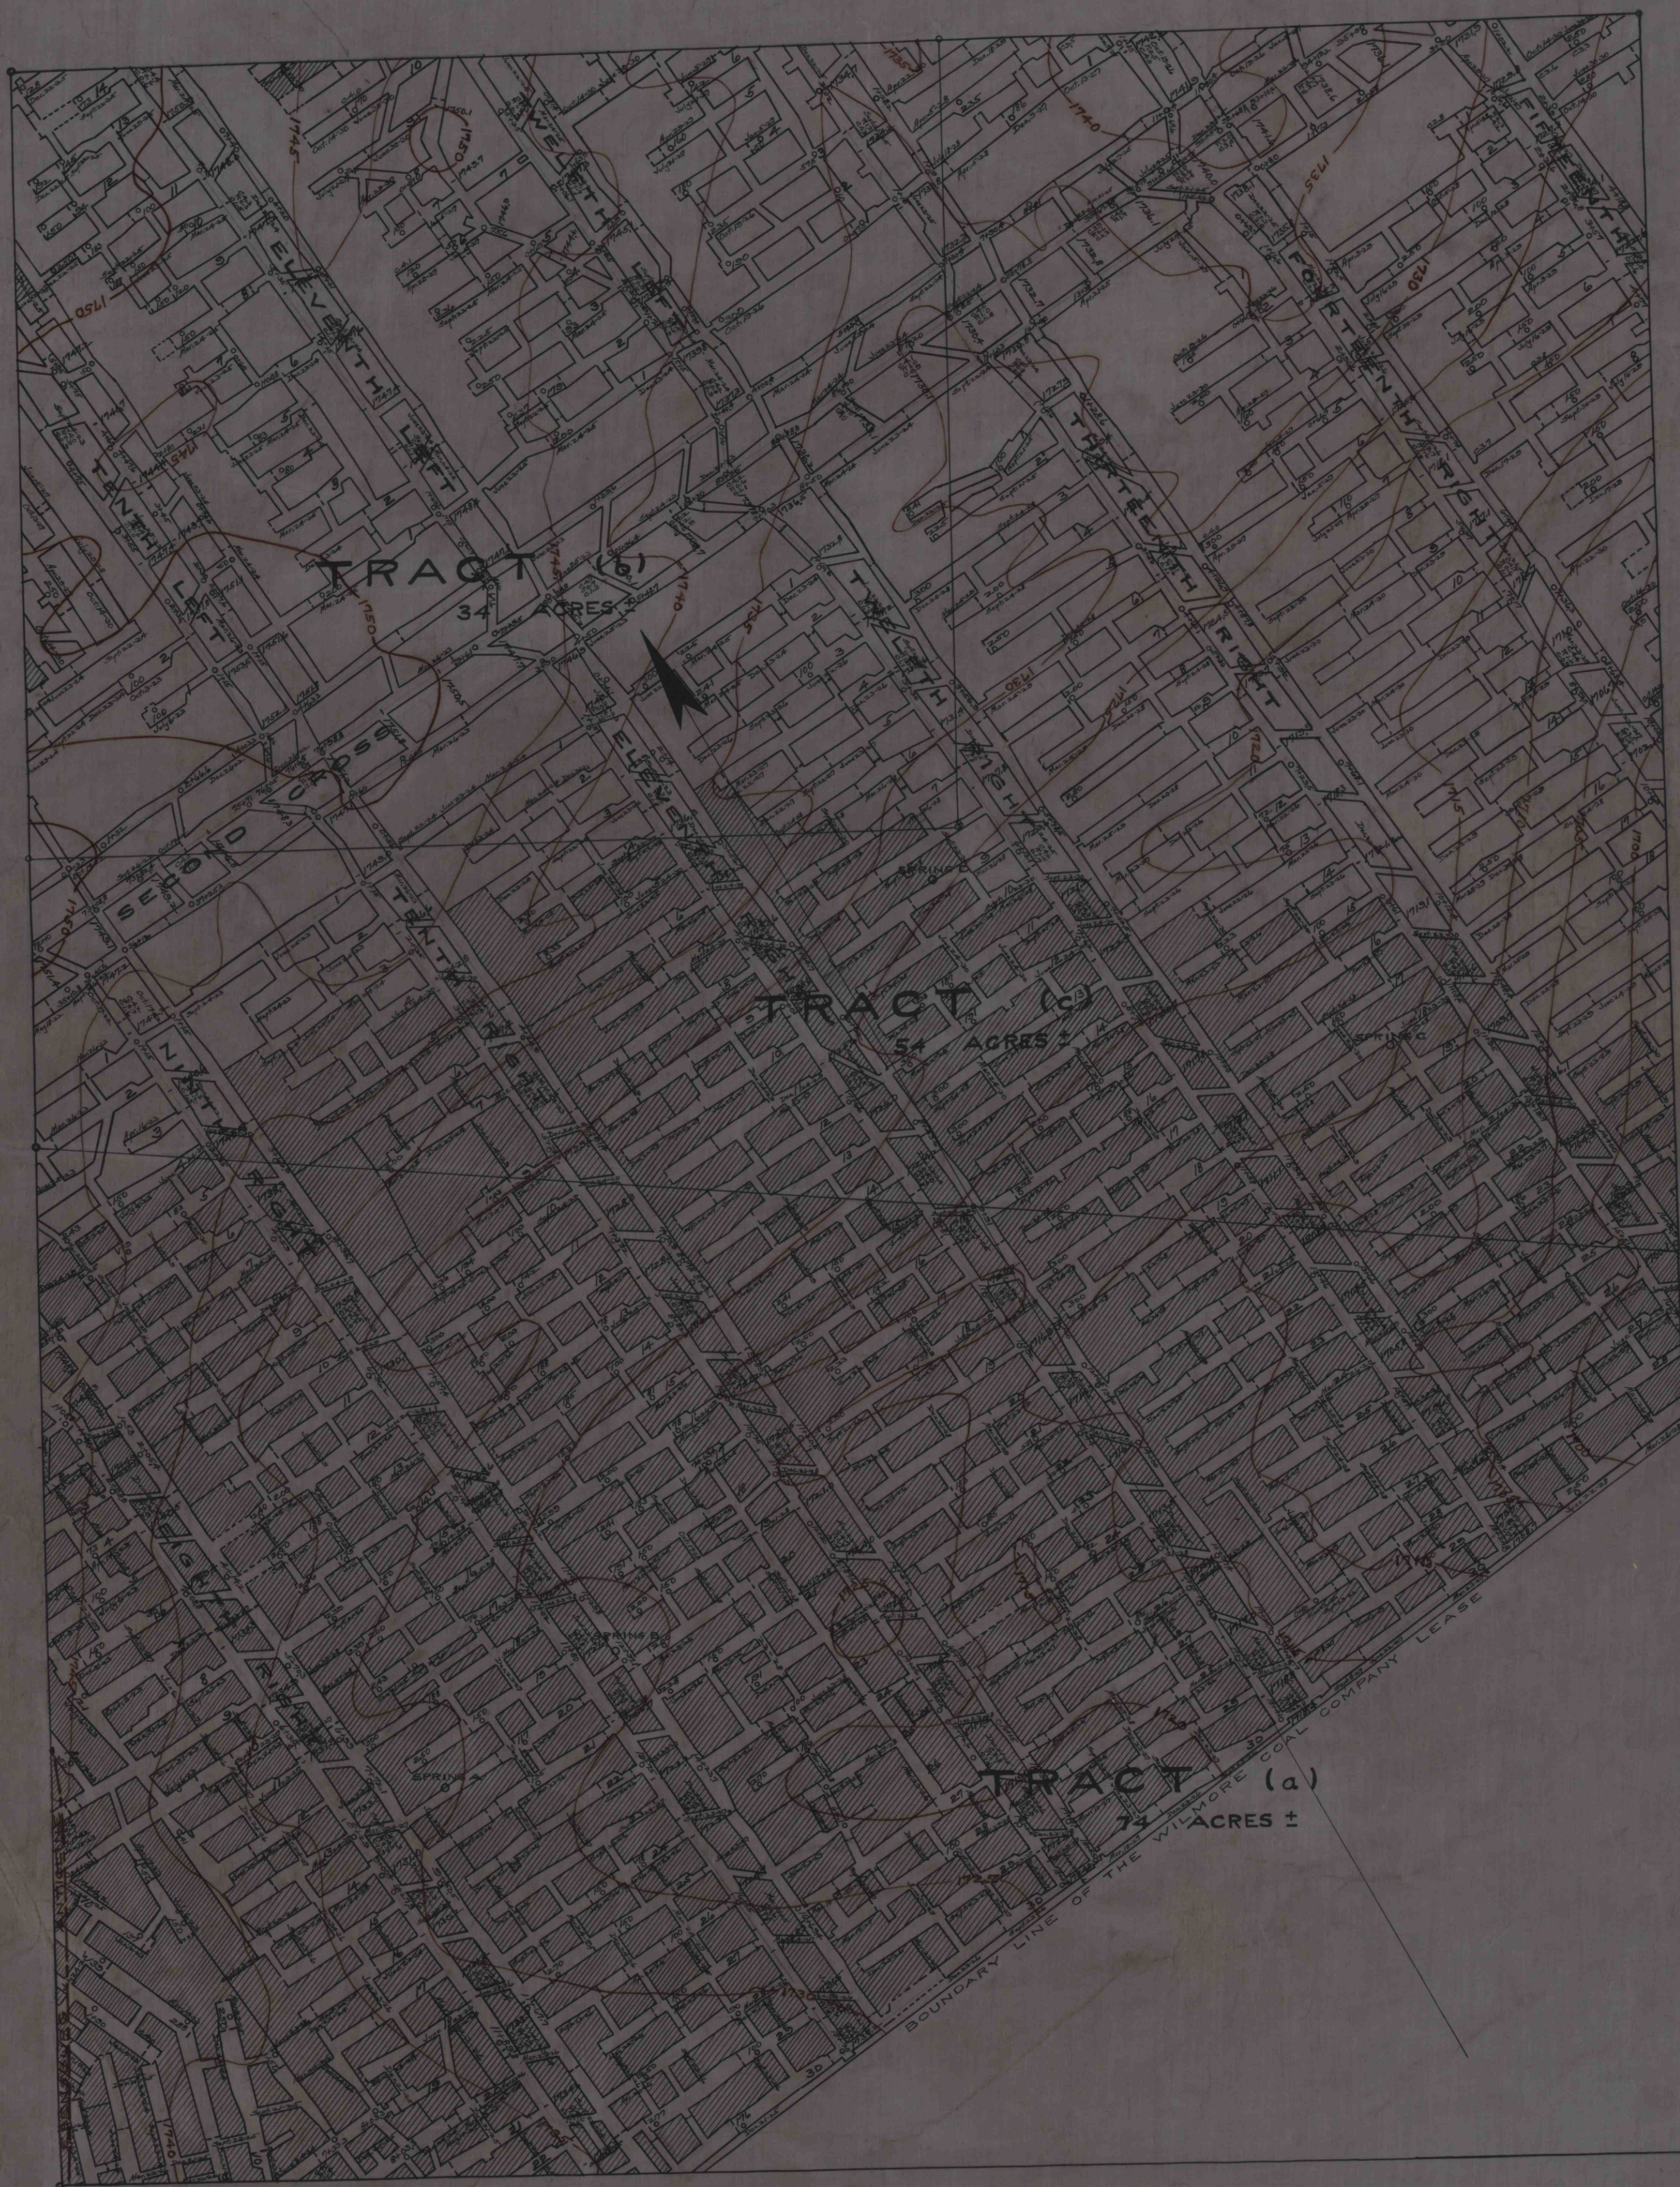

MAP OF
 BETHLEHEM MINE No 74
 "B" OR MILLER SEAM
 ON
 MARTIN HORNICK HEIRS PROPERTY.

Scale 1"=100'

November, 1930.

BETHLEHEM MINES CORPORATION
 Engineering Dept. Johnstown, Penna.