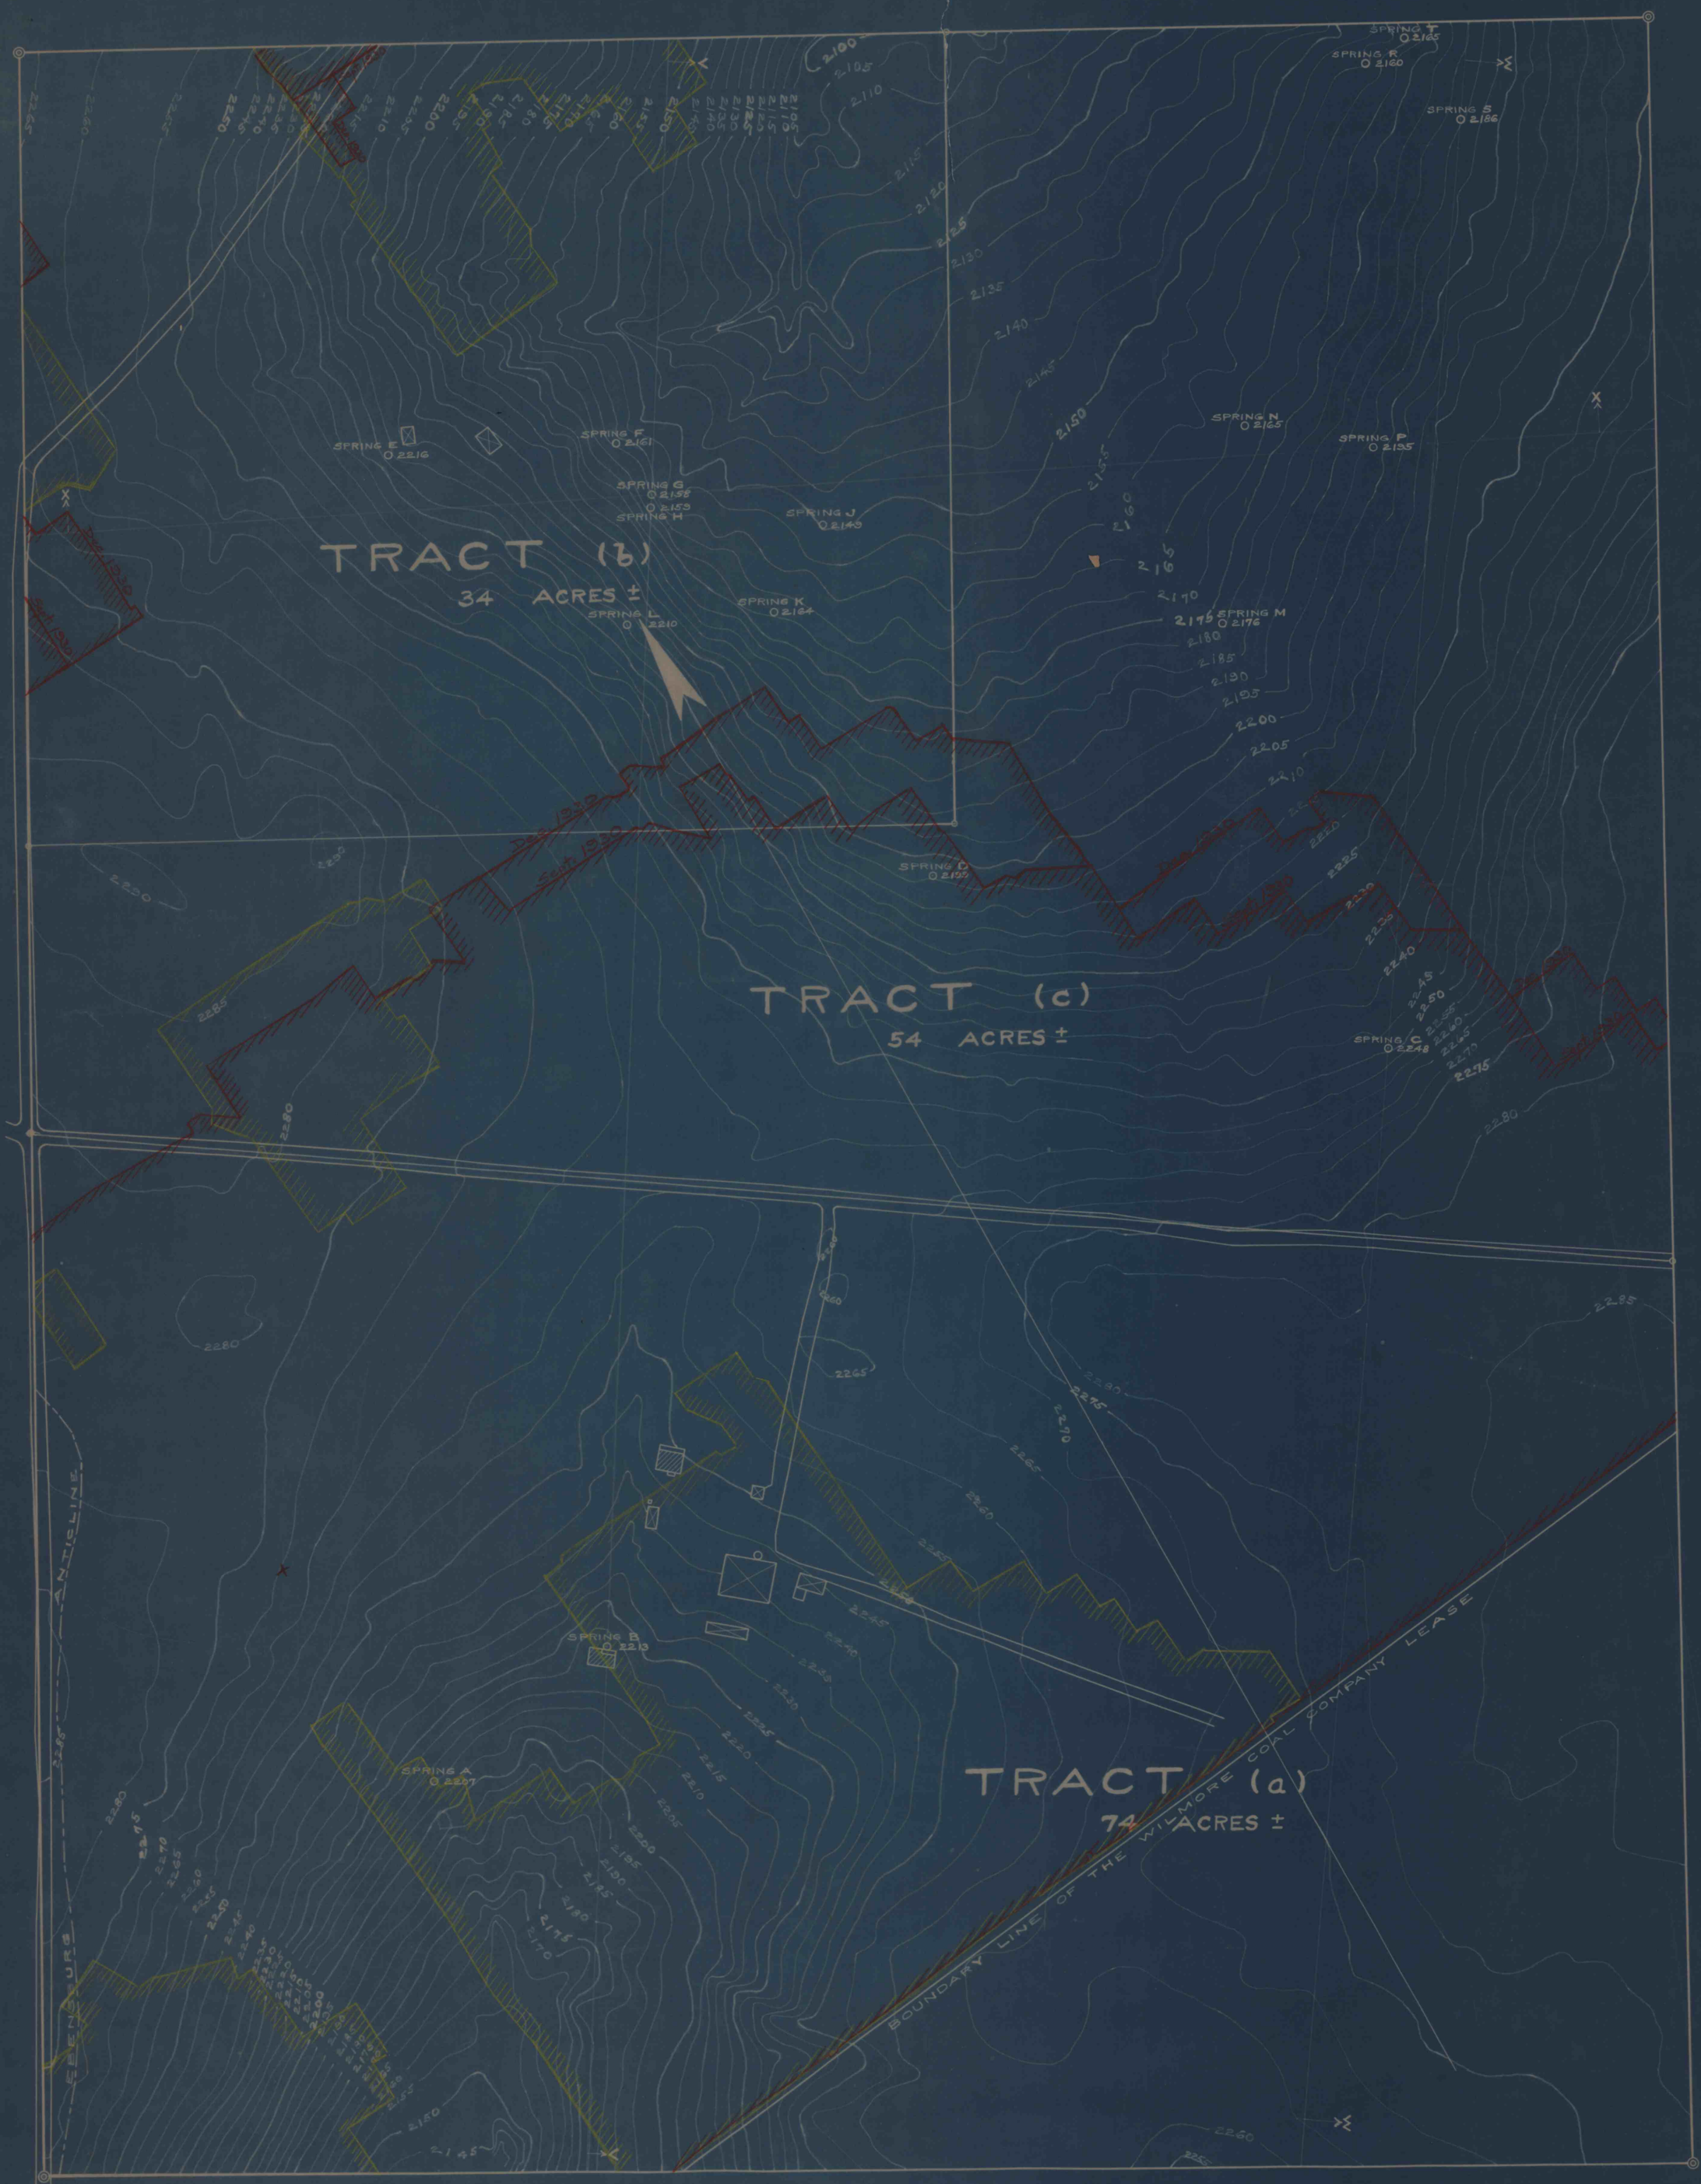


Pillared Area Mine No 73 'C' Seam

Pillared Area Mine No 94 'B' Seam

# MAP OF
# MARTIN HORNICK HEIRS PROPERTY
SITUATE
RICHLAND TOWNSHIP, CAMBRIA COUNTY,
PENNSYLVANIA.

Scale 1" = 100'  November, 1930.

BETHLEHEM MINES CORPORATION
Engineering Dept.  Johnstown, Penna.

51-B-66