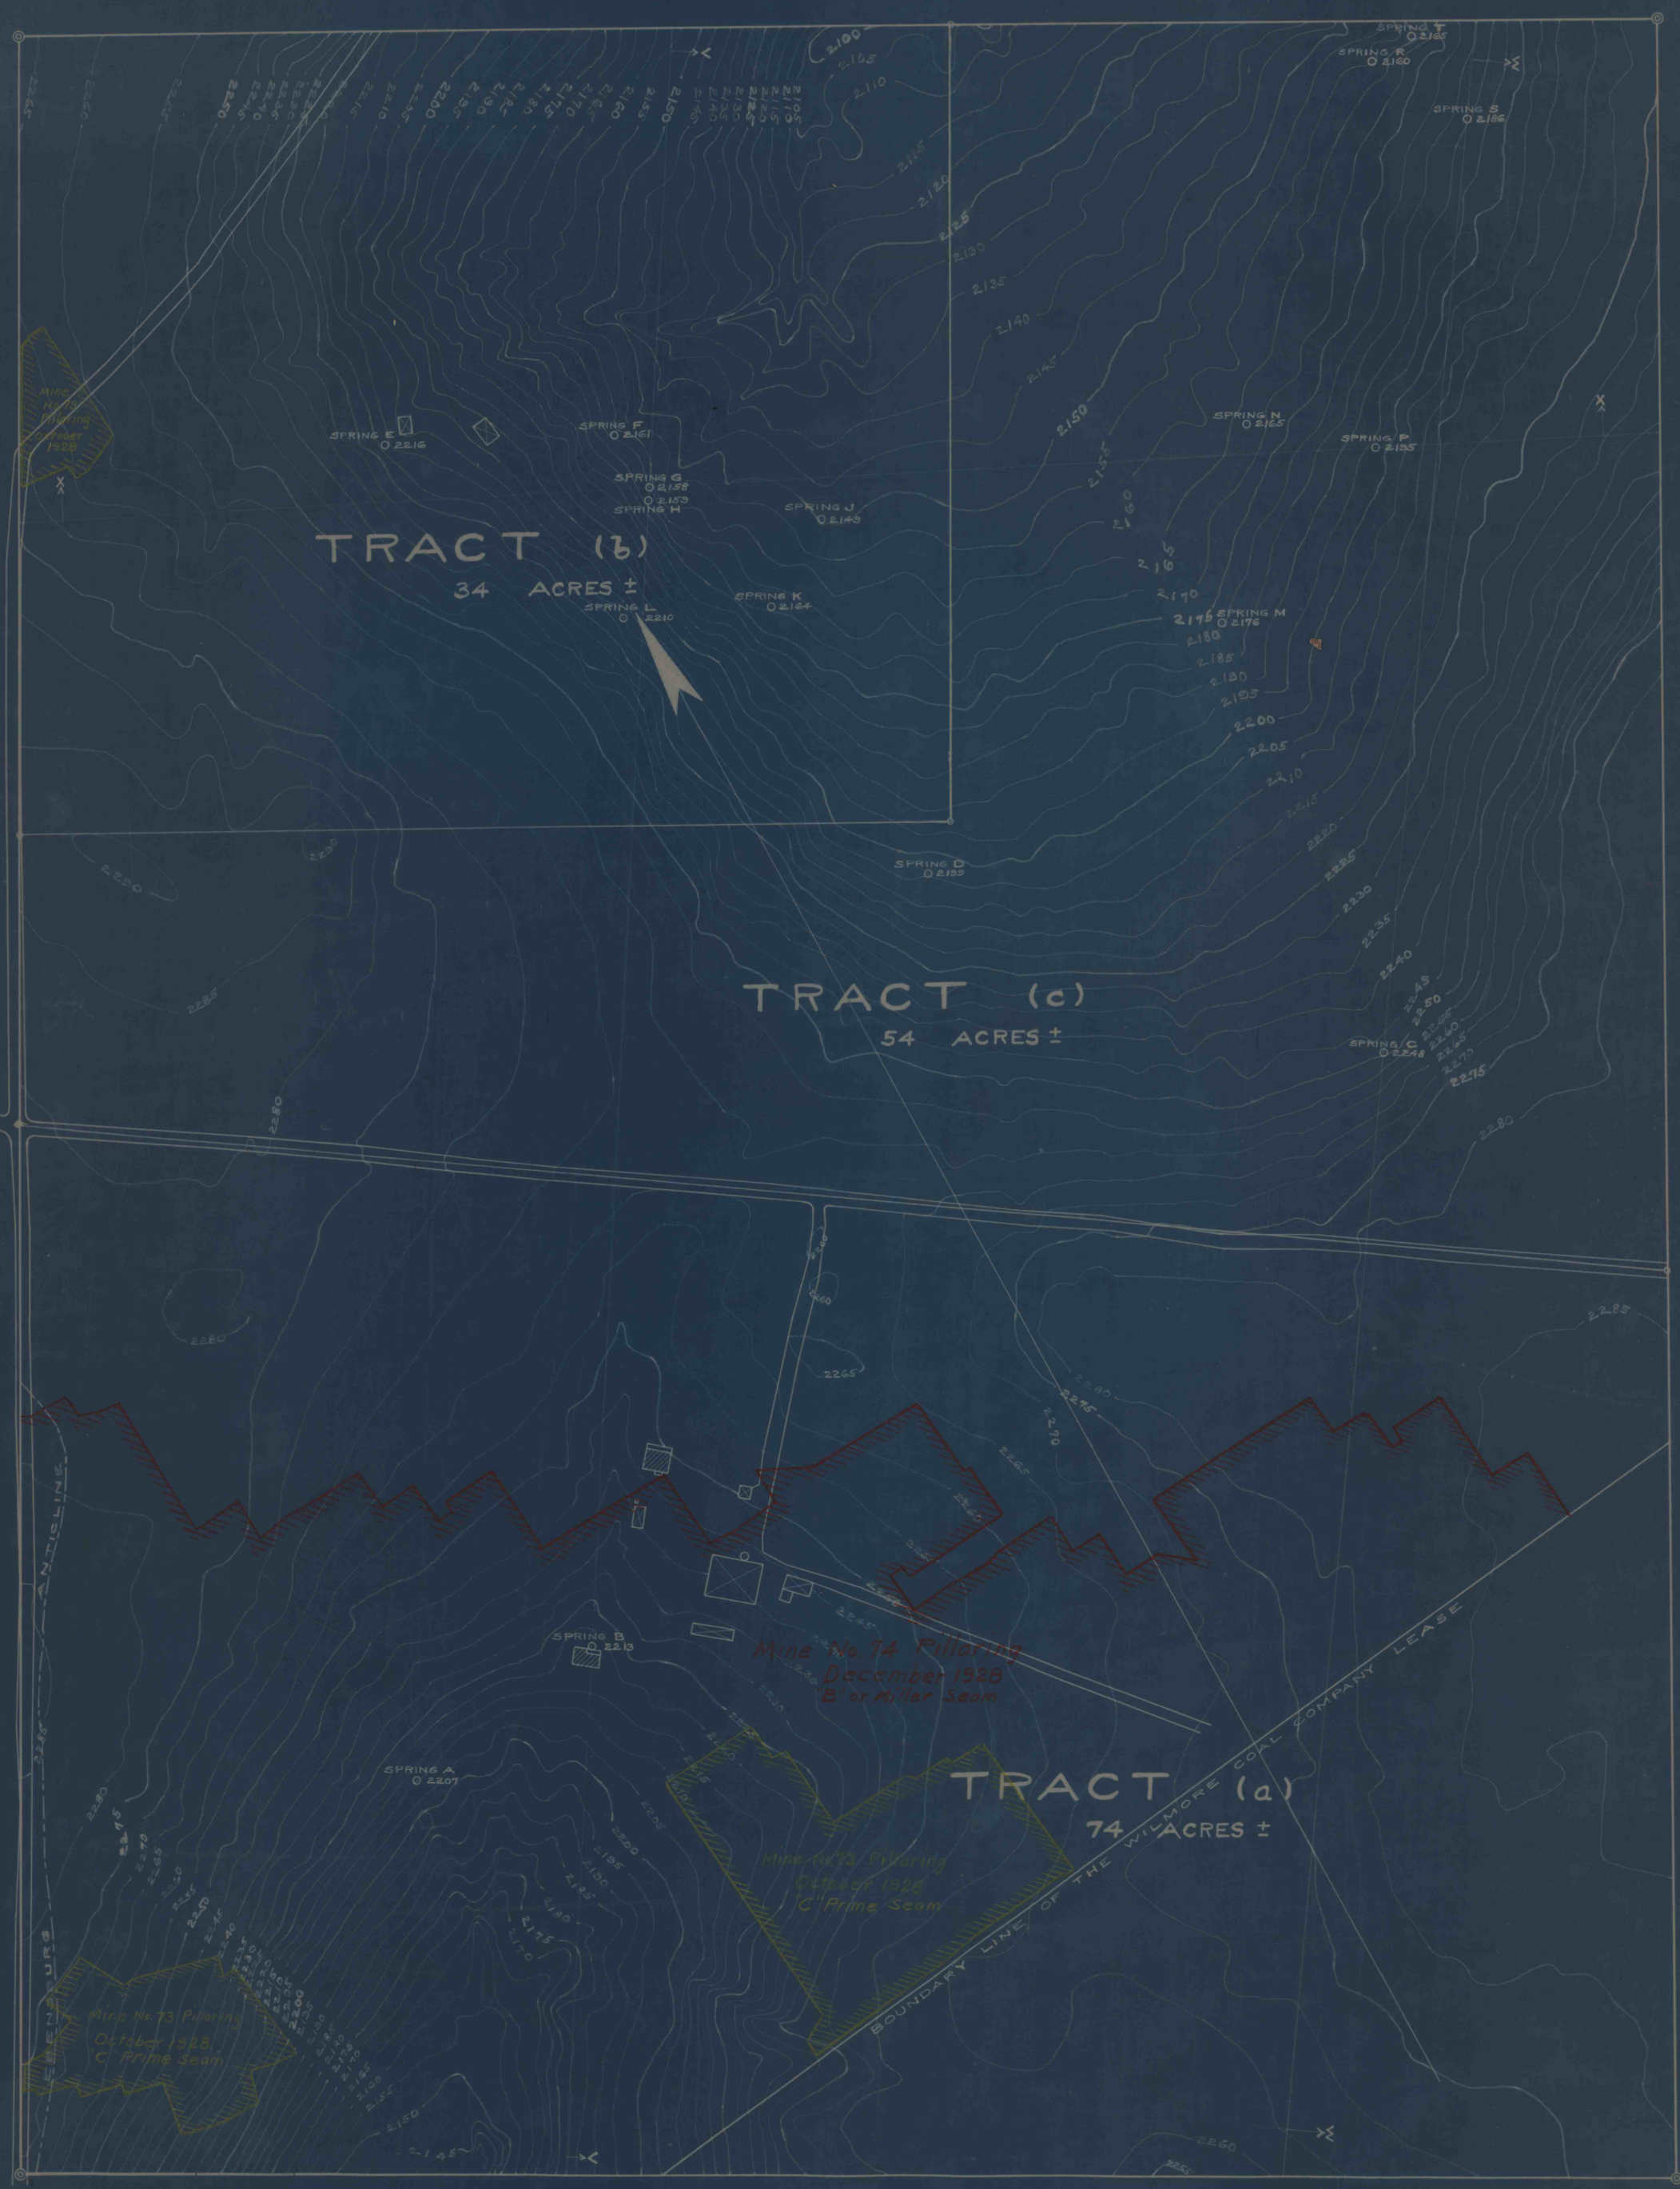

MAP OF
MARTIN HORNICK HEIRS PROPERTY
SITUATE
RICHLAND TOWNSHIP, CAMBRIA COUNTY,
PENNSYLVANIA.

Scale 1" = 100' November, 1930.

BETHLEHEM MINES CORPORATION
Engineering Dept. Johnstown, Penna.

51-B-66