


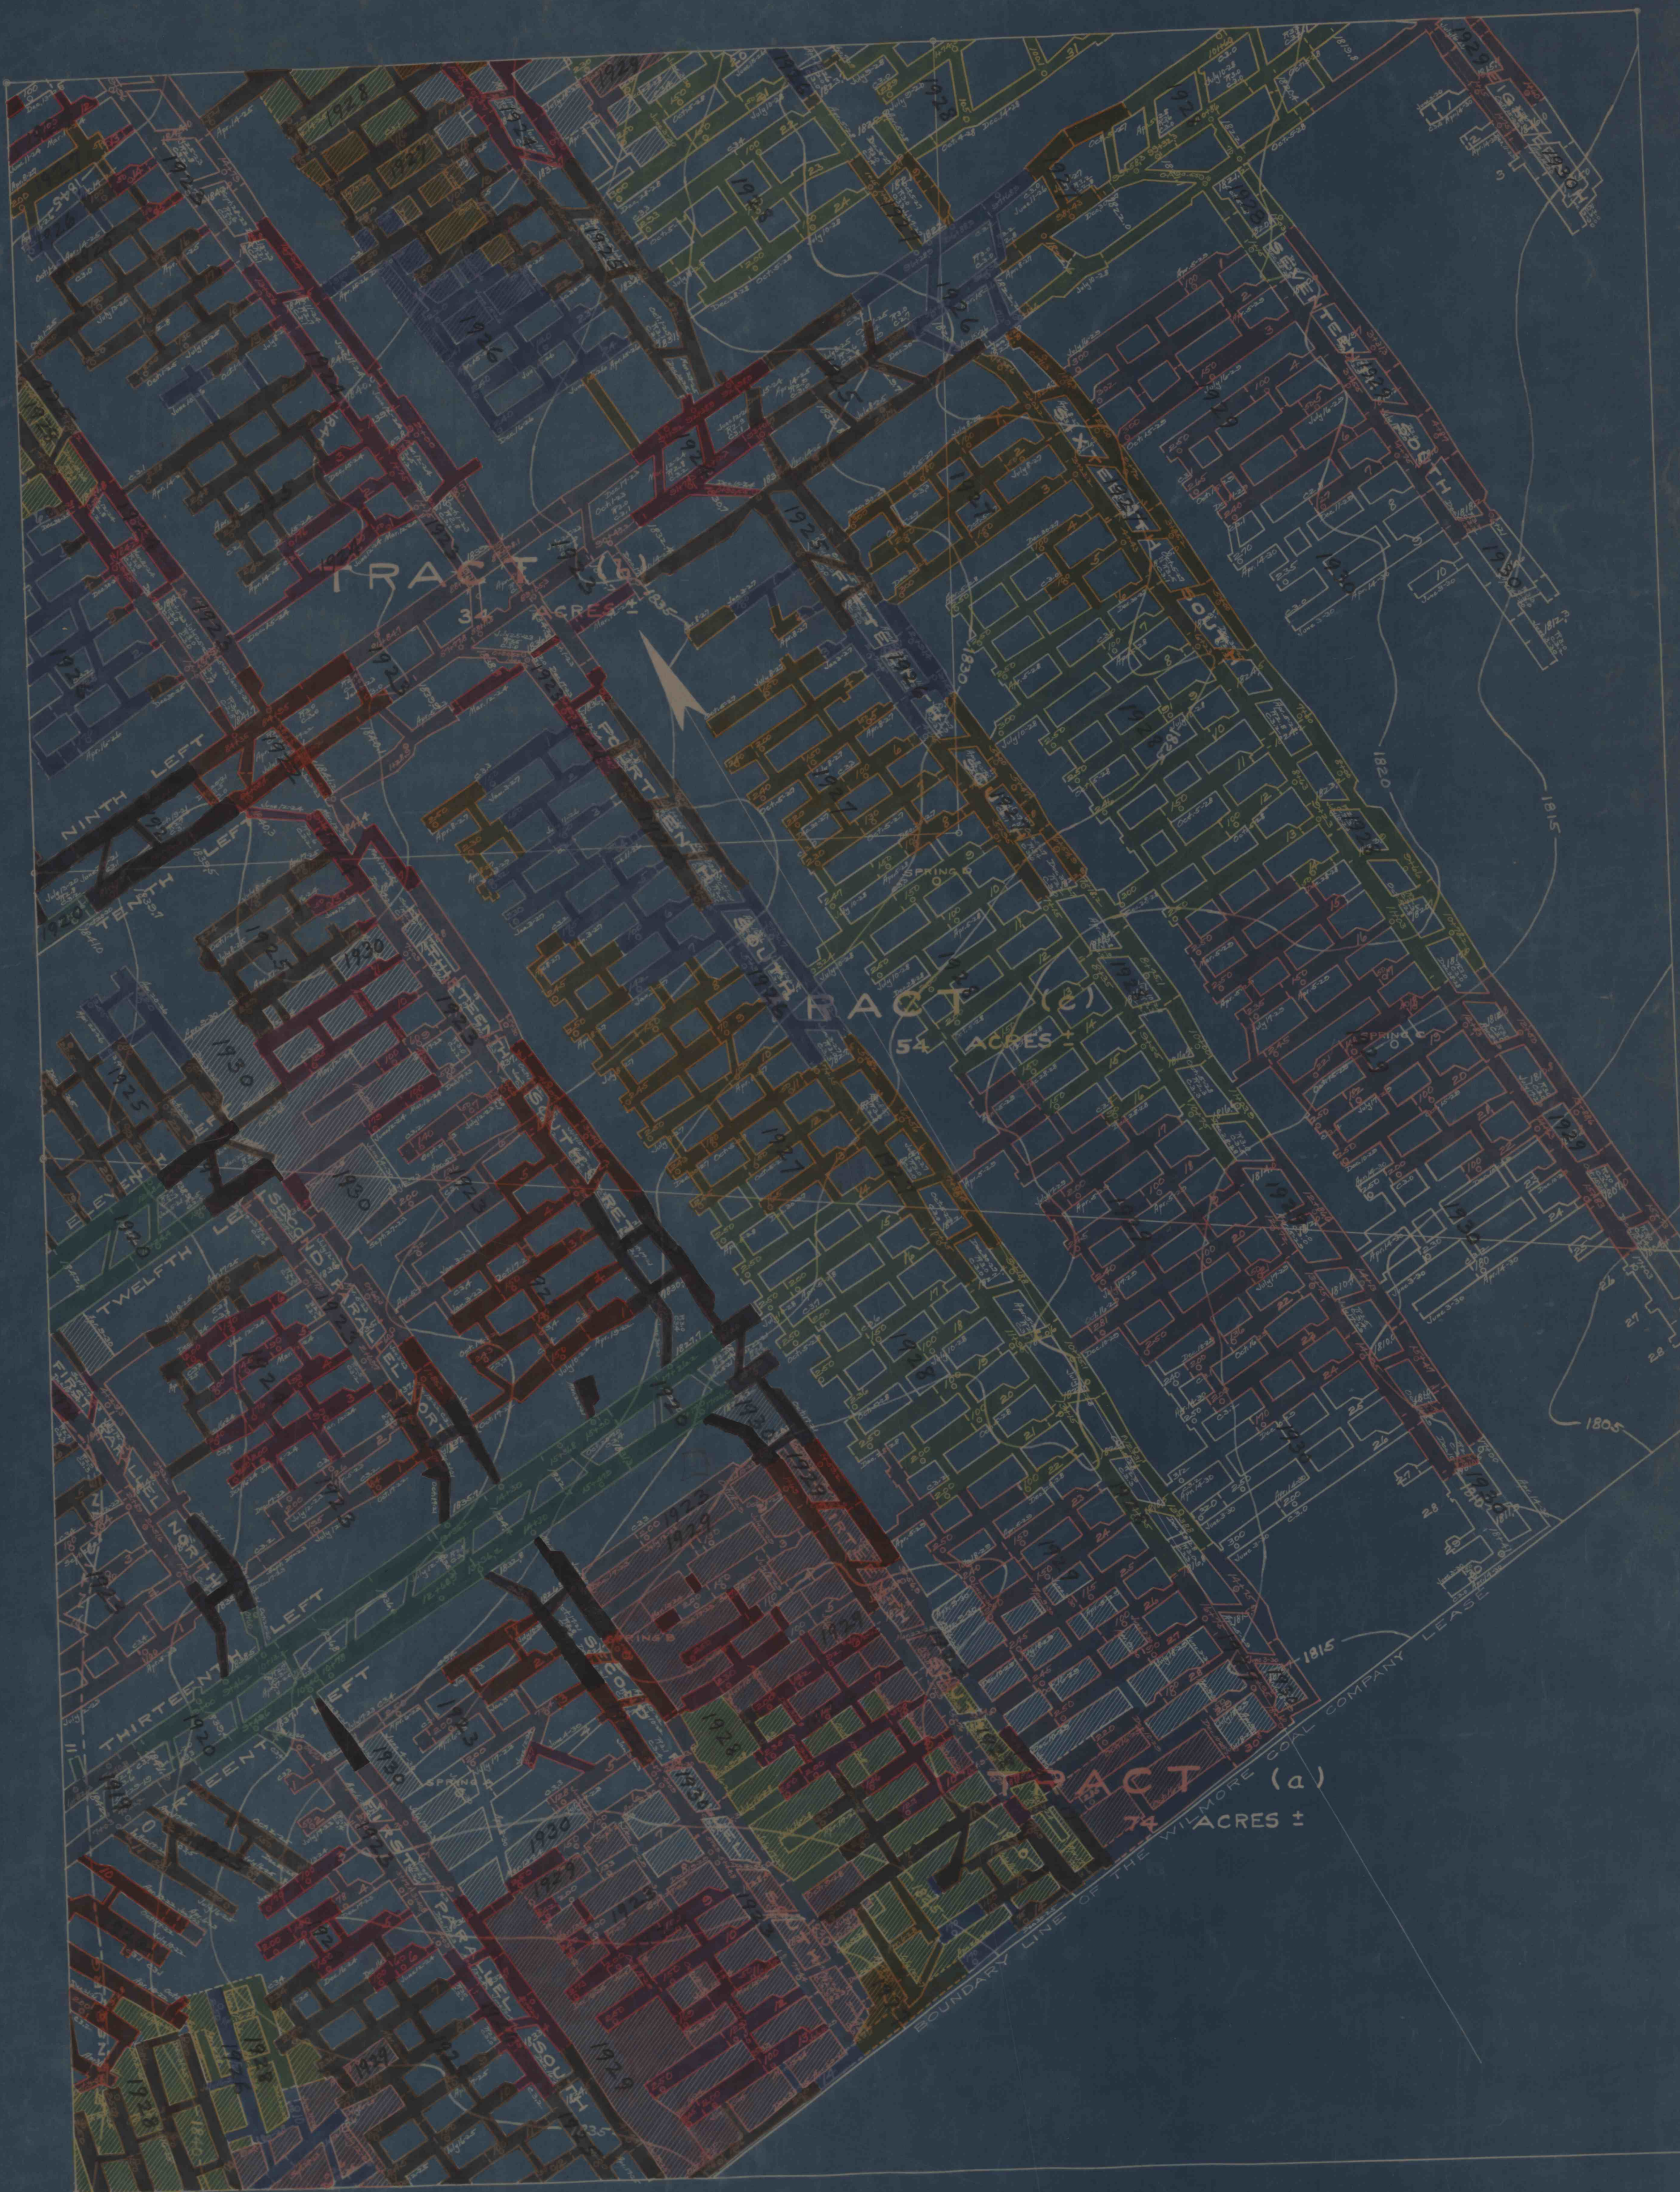

MAP OF
BETHLEHEM MINE No 73
IN THE
"C-PRIME" OR CEMENT SEAM
ON
MARTIN HORNICK HEIRS PROPERTY.

Scale 1"=100' November, 1930.
BETHLEHEM MINES CORPORATION
Engineering Dept. Johnstown, Penna.