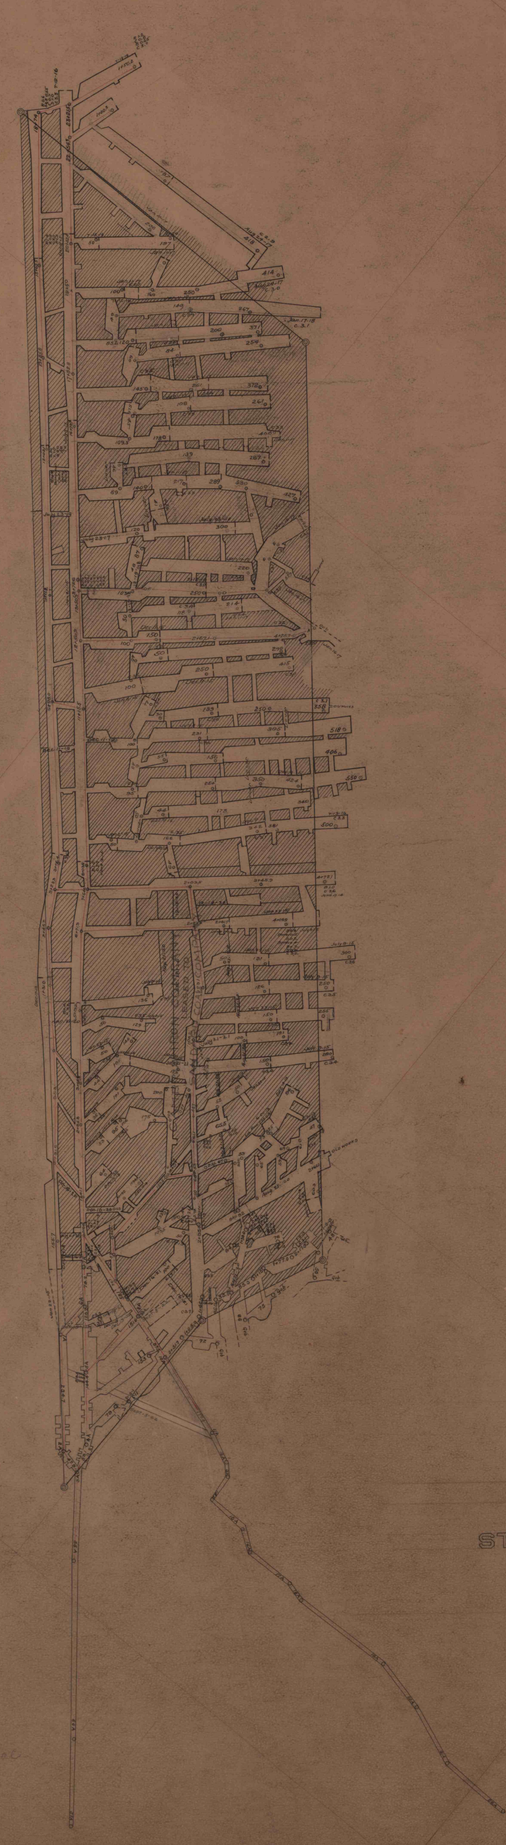

MAP OF MINE

OPERATED BY

STANDARD COAL COMPANY

SITUATE

CRESSON TOWNSHIP

CAMBRIA COUNTY

PENNA.

SCALE 1 IN. 100 FT.

L.B.3