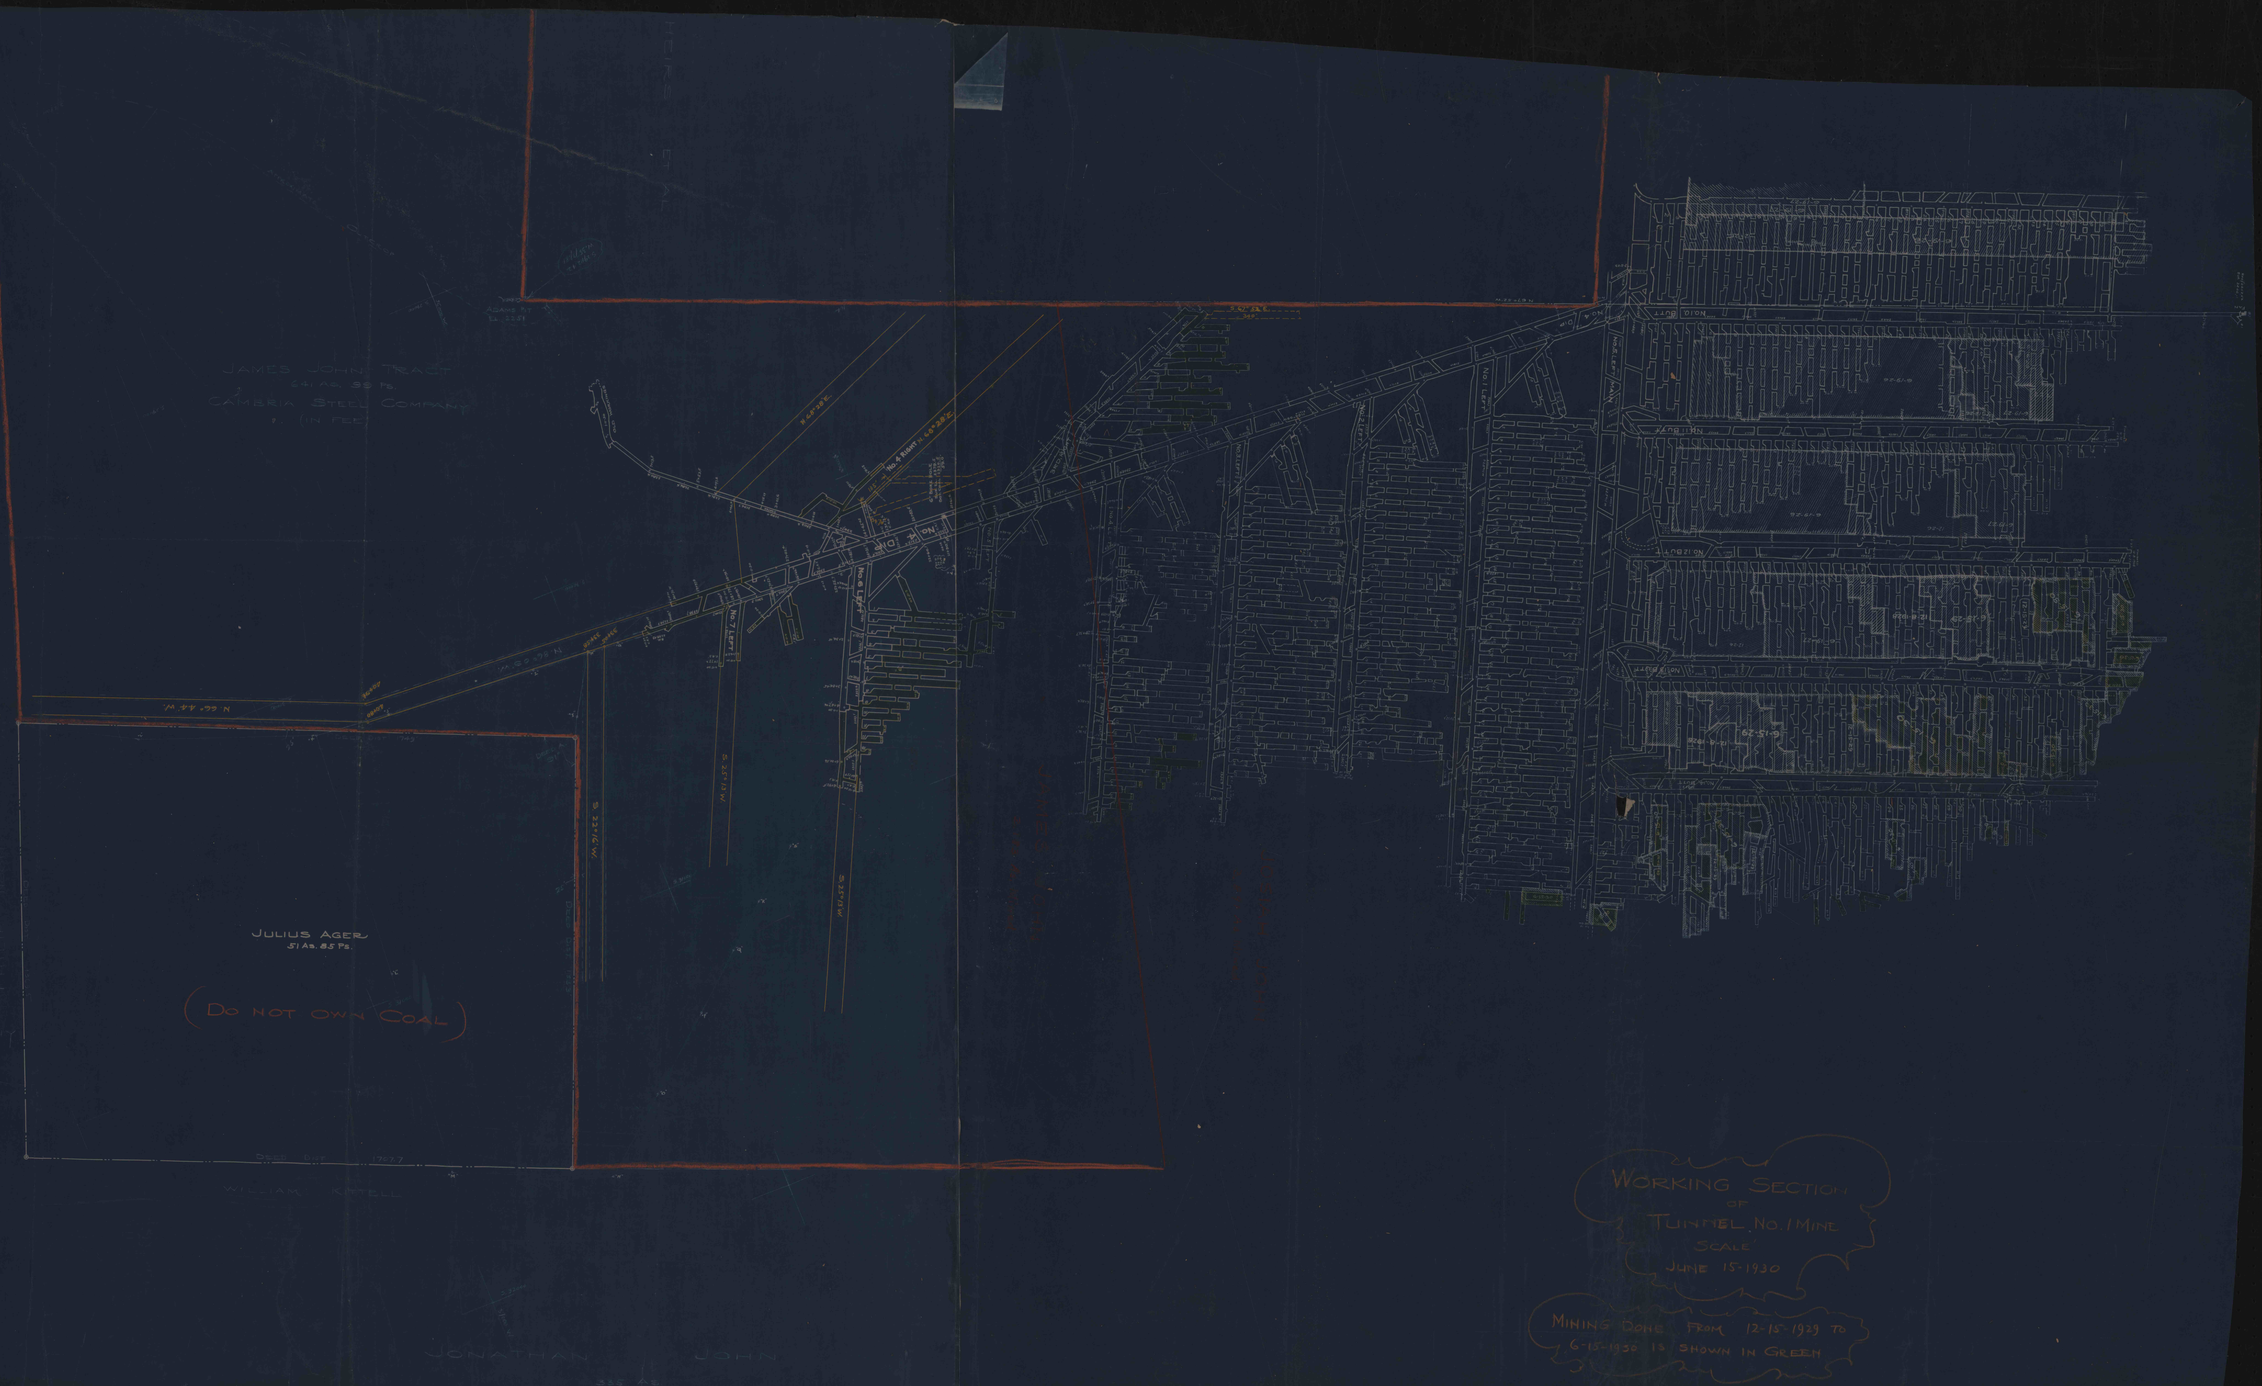
JAMES JOHN TRACT
CAMBRIA STEEL COMPANY
JULIUS AGER
51 As. 85 Ps.
(DO NOT OWN COAL)
WILLIAM KNELL
JONATHAN JOHN
WORKING SECTION
OF
TUNNEL NO. 1 MINE
SCALE
JUNE 15-1930
MINING DONE FROM 12-15-1929 TO
6-15-1930 IS SHOWN IN GREEN