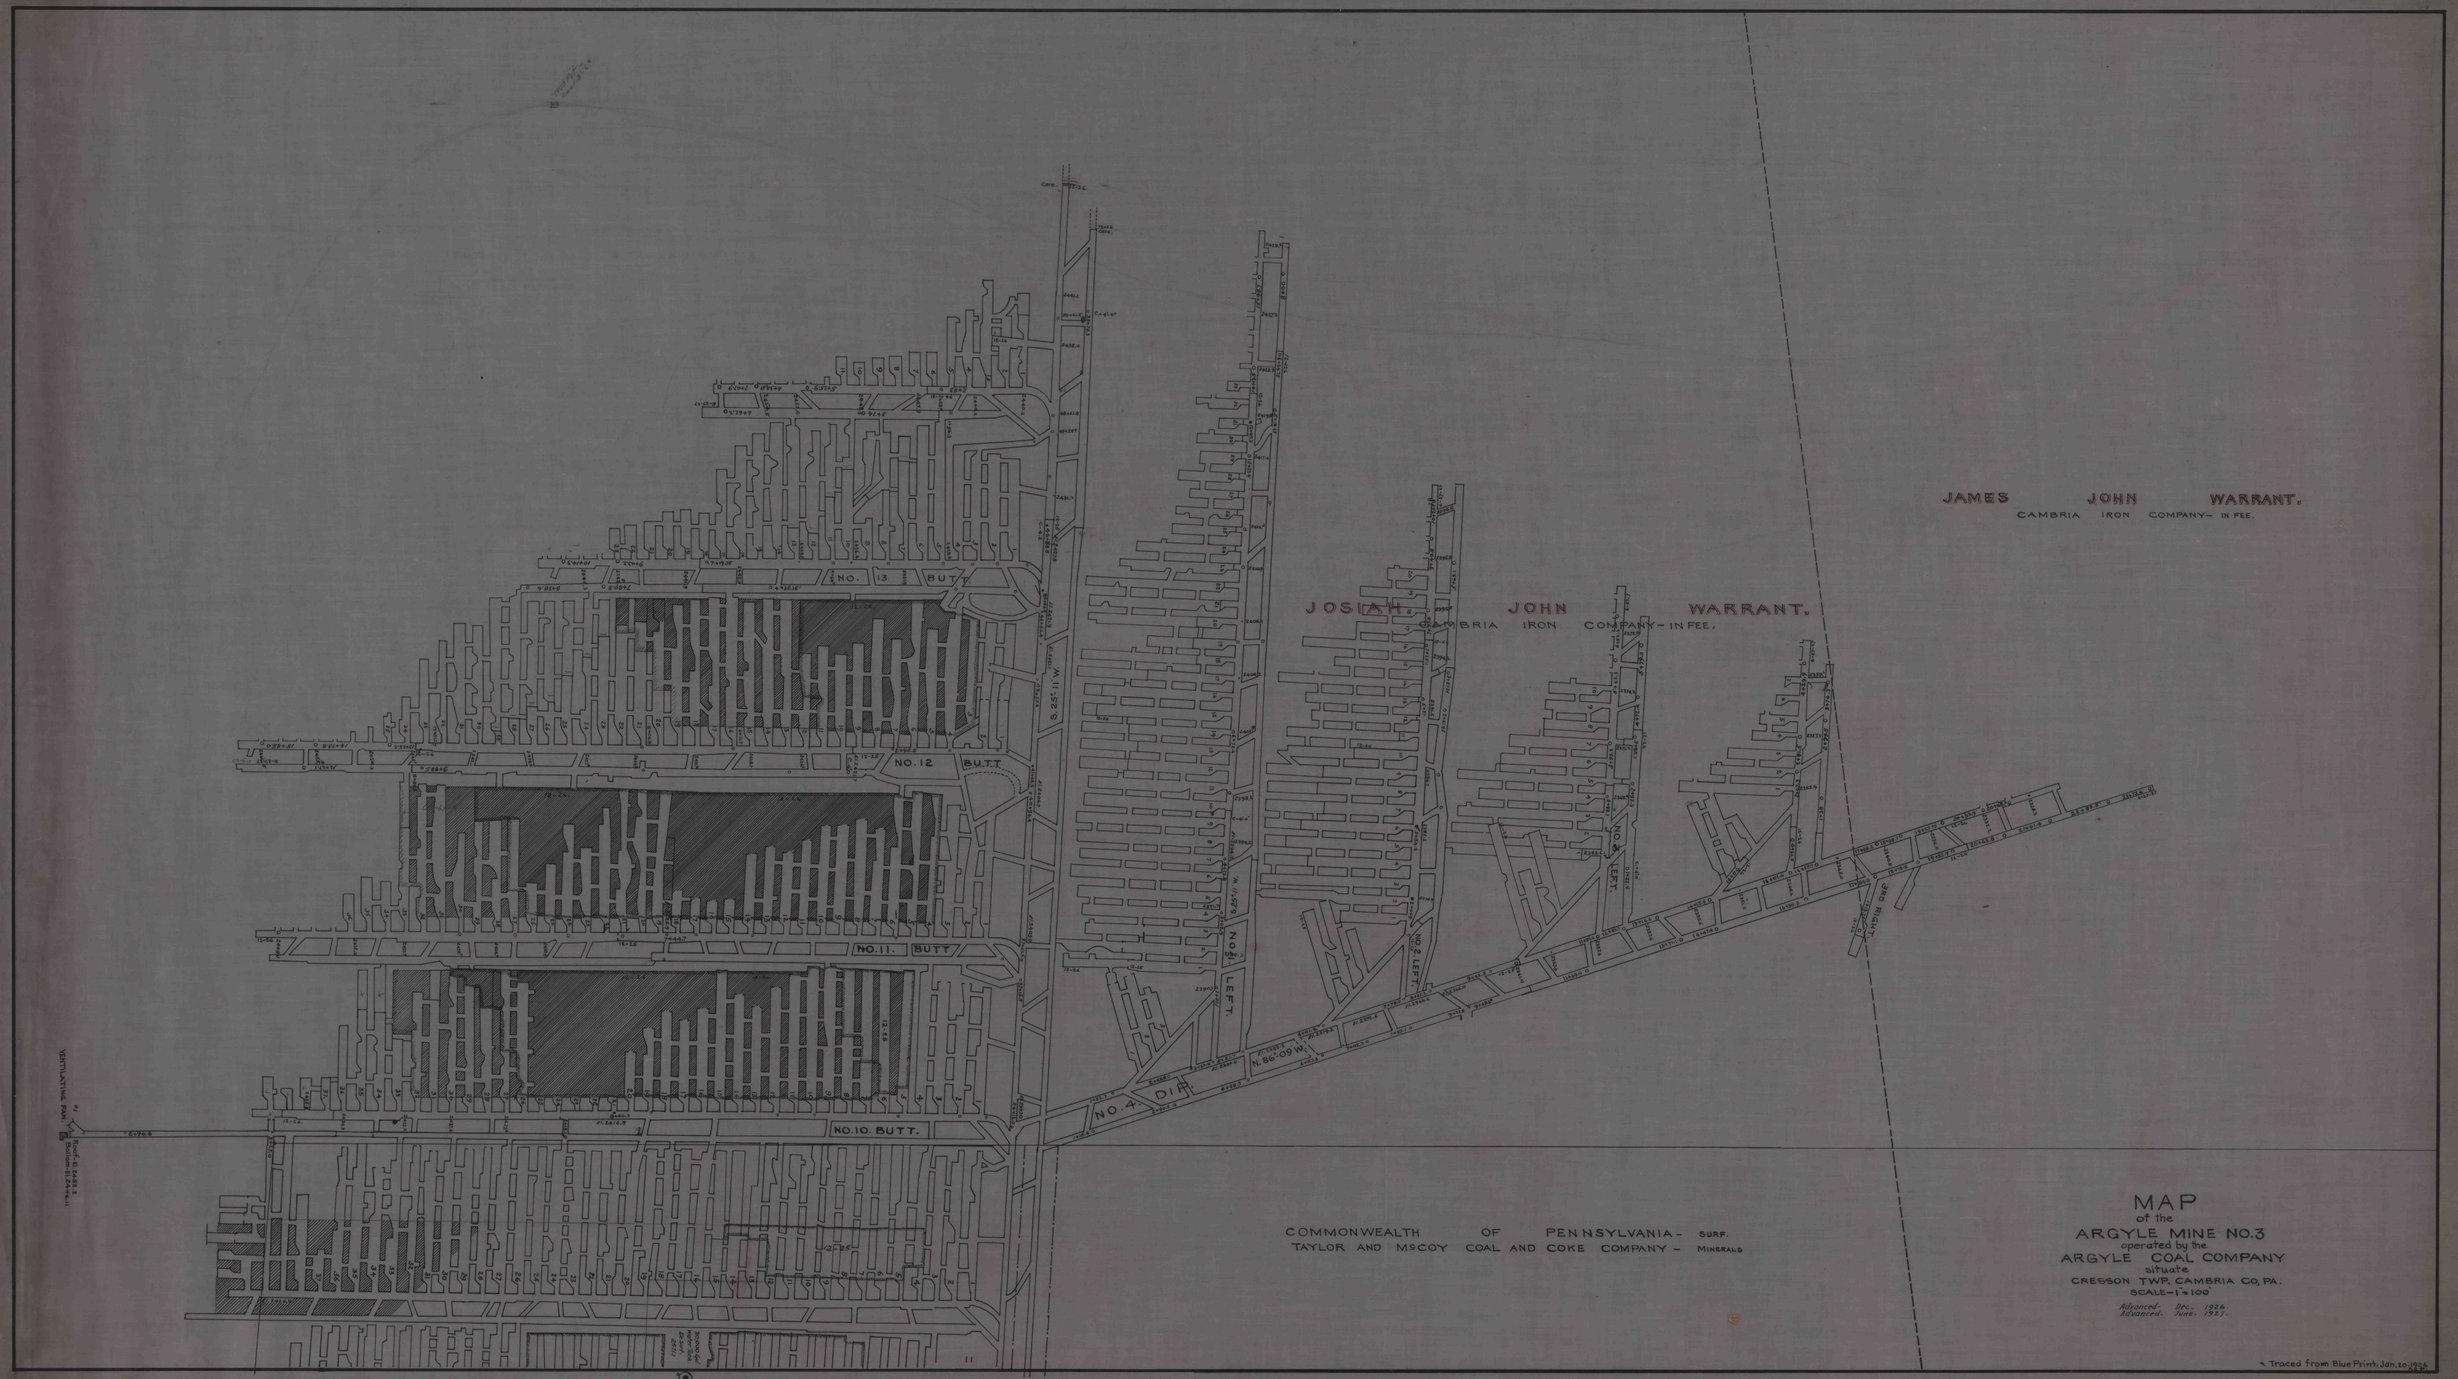
JAMES JOHN WARRANT.
CAMBRIA IRON COMPANY - IN FEE.
JOSIAH JOHN WARRANT.
CAMBRIA IRON COMPANY - IN FEE.
NO. 13 BUTT
NO. 12 BUTT
NO. 11. BUTT
NO. 10. BUTT.
NO. 4 DIP
NO. 4 LEFT
NO. 2 LEFT
NO. 3 LEFT
3RD RIGHT
S. 25° 11' W.
N. 86° 09' W.
VENTILATING FAN
COMMONWEALTH OF PENNSYLVANIA - SURF.
TAYLOR AND McCOY COAL AND COKE COMPANY - MINERALS
MAP
of the
ARGYLE MINE NO. 3
operated by the
ARGYLE COAL COMPANY
situate
CRESSON TWP. CAMBRIA CO. PA.
SCALE - 1" = 100'
Advanced - Dec. 1926.
Advanced - June. 1927.
Traced from Blue Print Jan. 20. 1928