


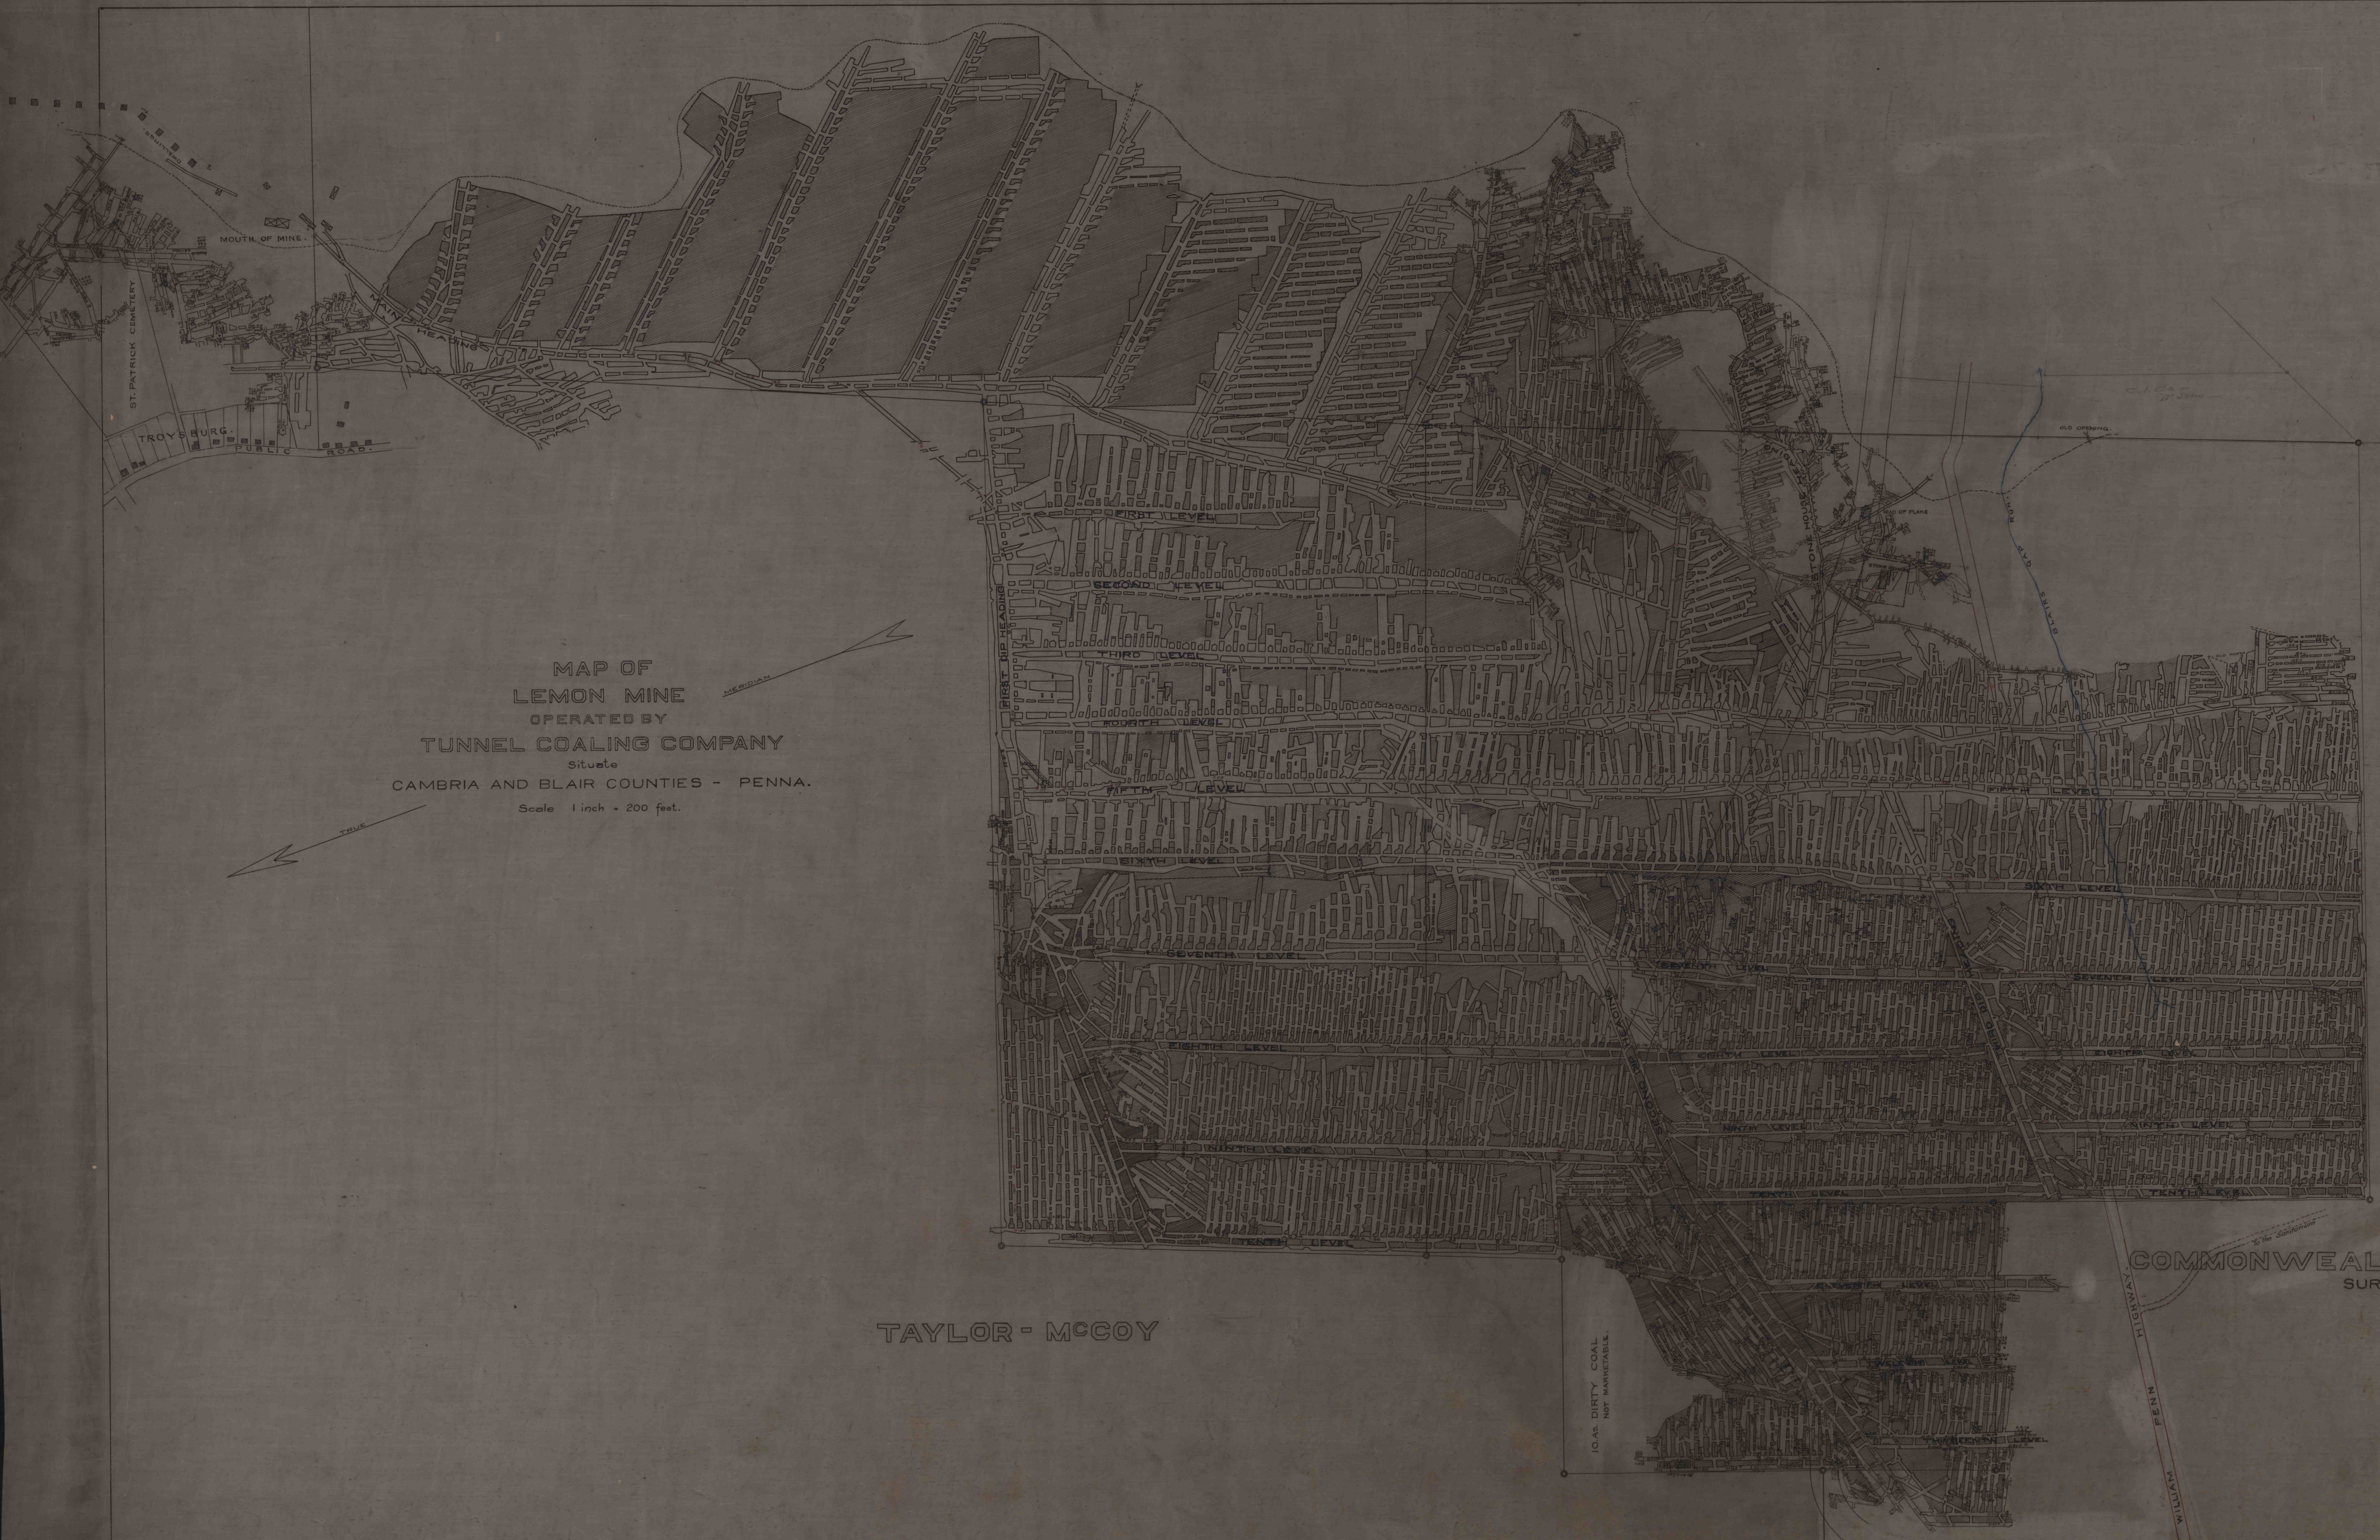

MAP OF
LEMON MINE
OPERATED BY
TUNNEL COALING COMPANY
Situate
CAMBRIA AND BLAIR COUNTIES - PENNA.
Scale 1 inch = 200 feet.

TAYLOR - MCGOY

STANDARD COAL CO.