


CONNELLSVILLE GAS COAL COMPANY'S MORRELL MINE (ABANDONED)

ANCHOR MINE (ABANDONED)

MAP
of the
MAHONING-ATLAS MINE.
OPERATED BY THE
CAMBRIA STEEL CO.

FAYETTE CO. PENNA.
SCALE-100'-1"=1".
1908.

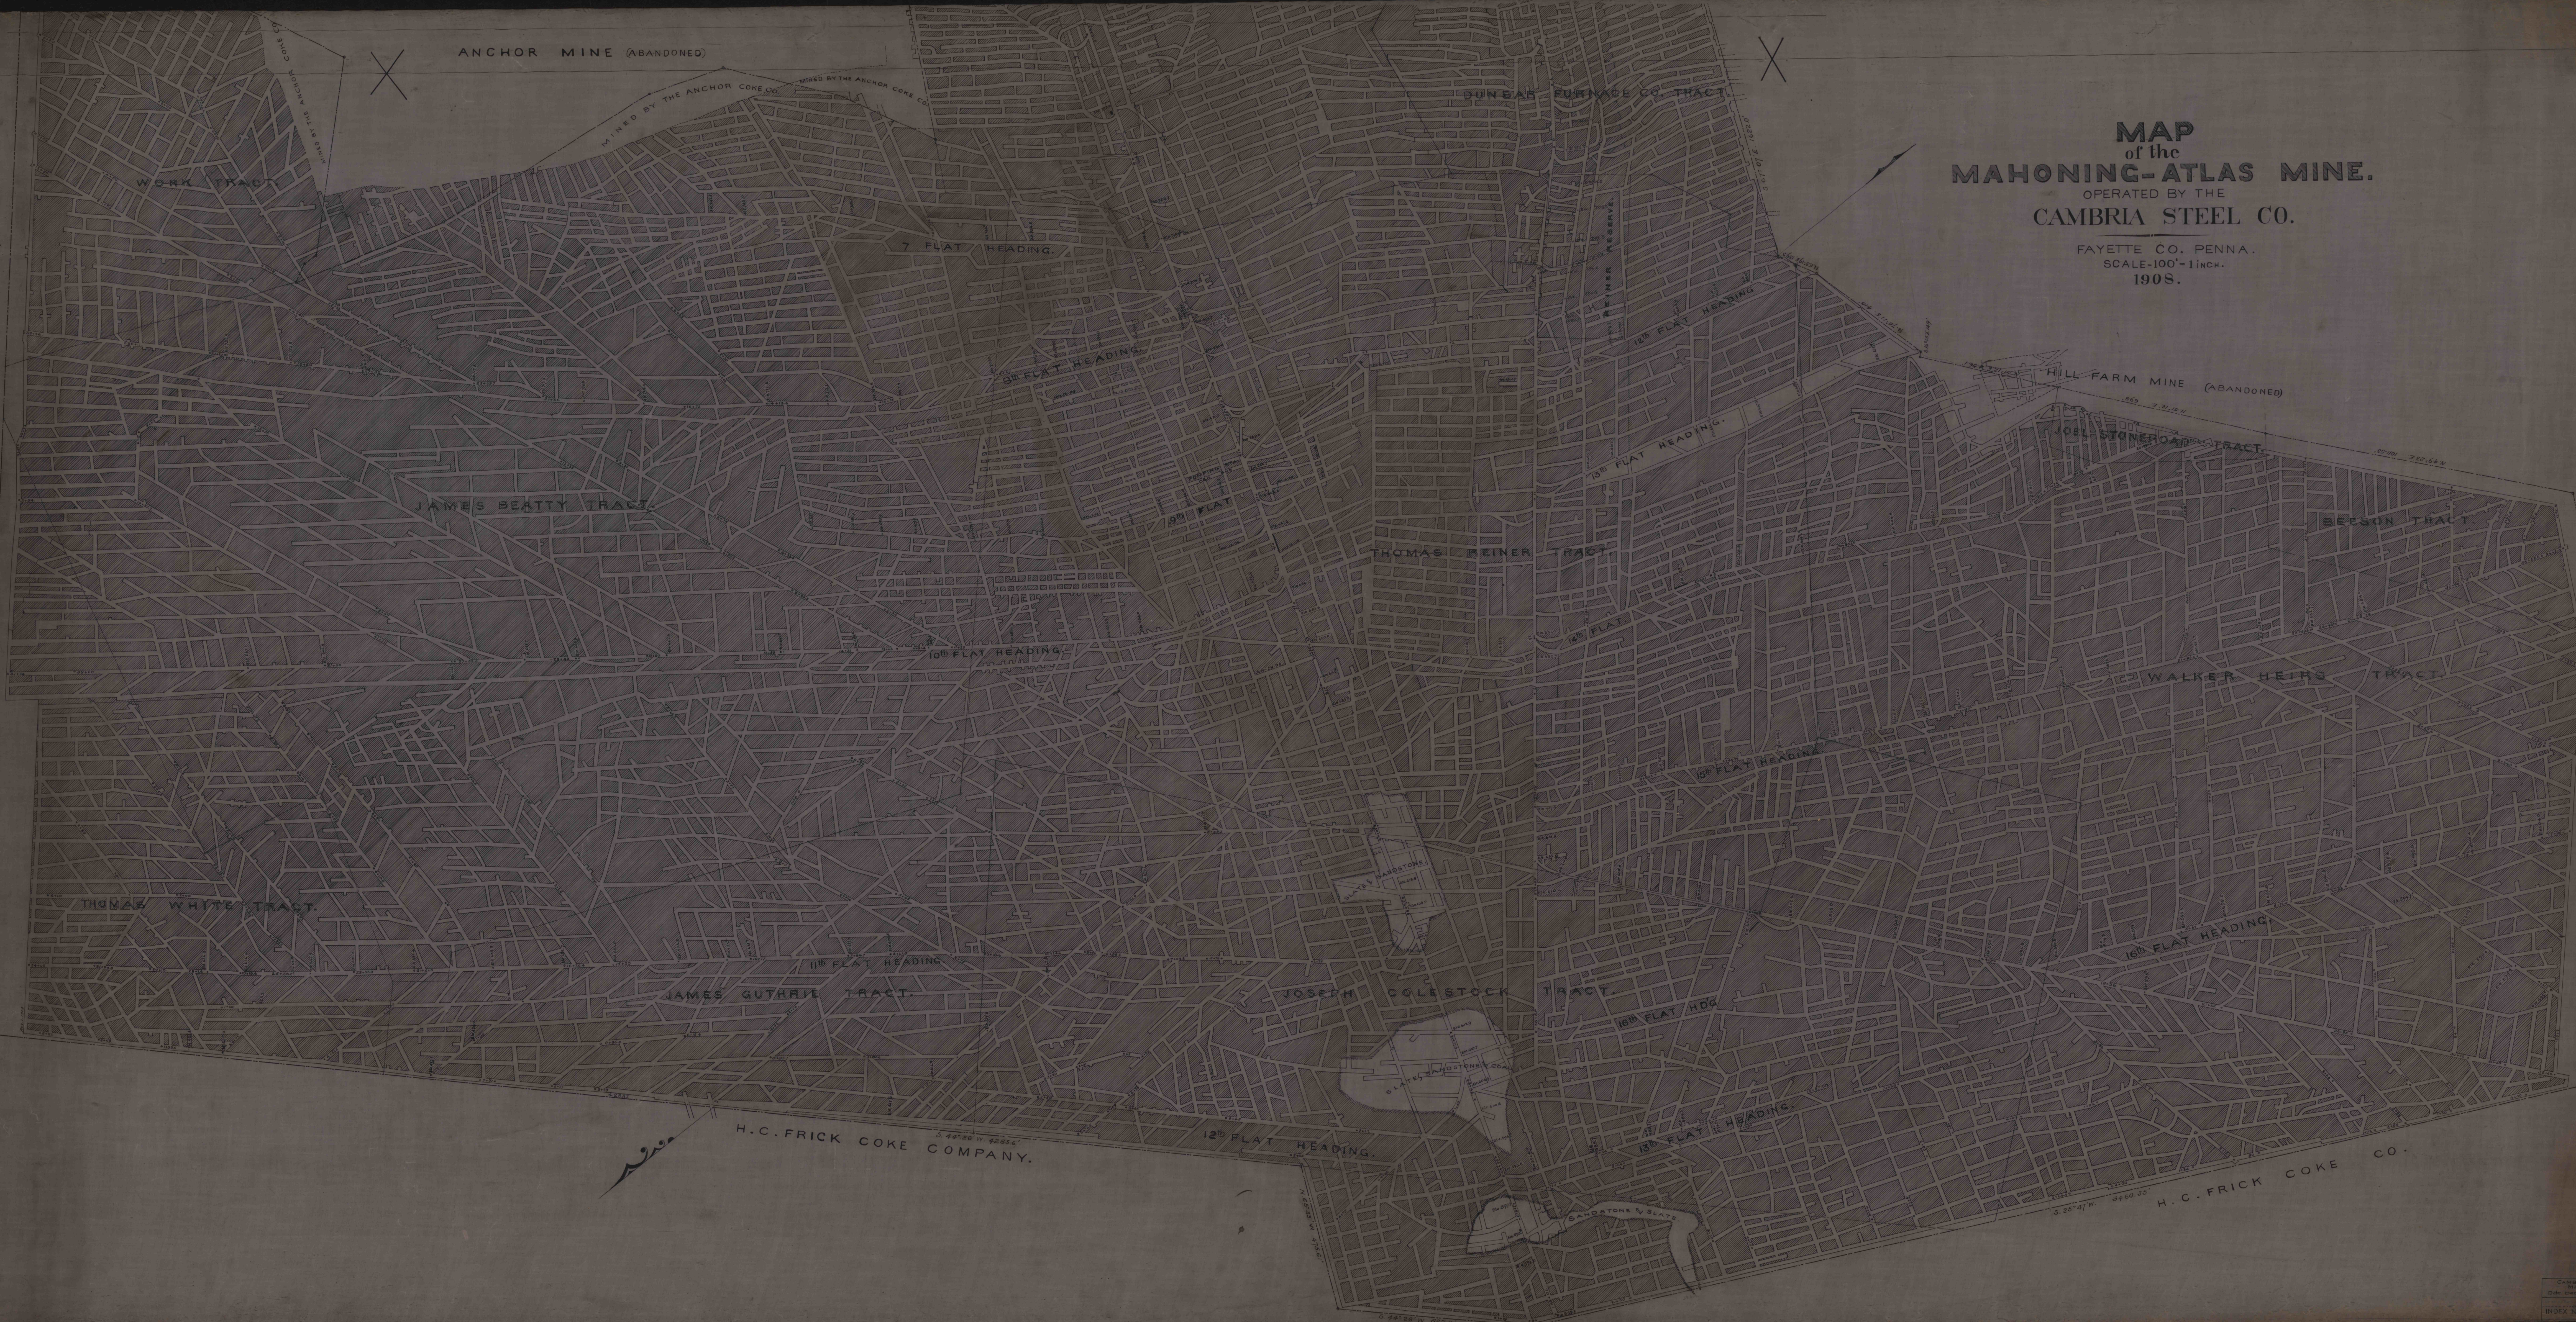

DUNBAR FURNACE CO.