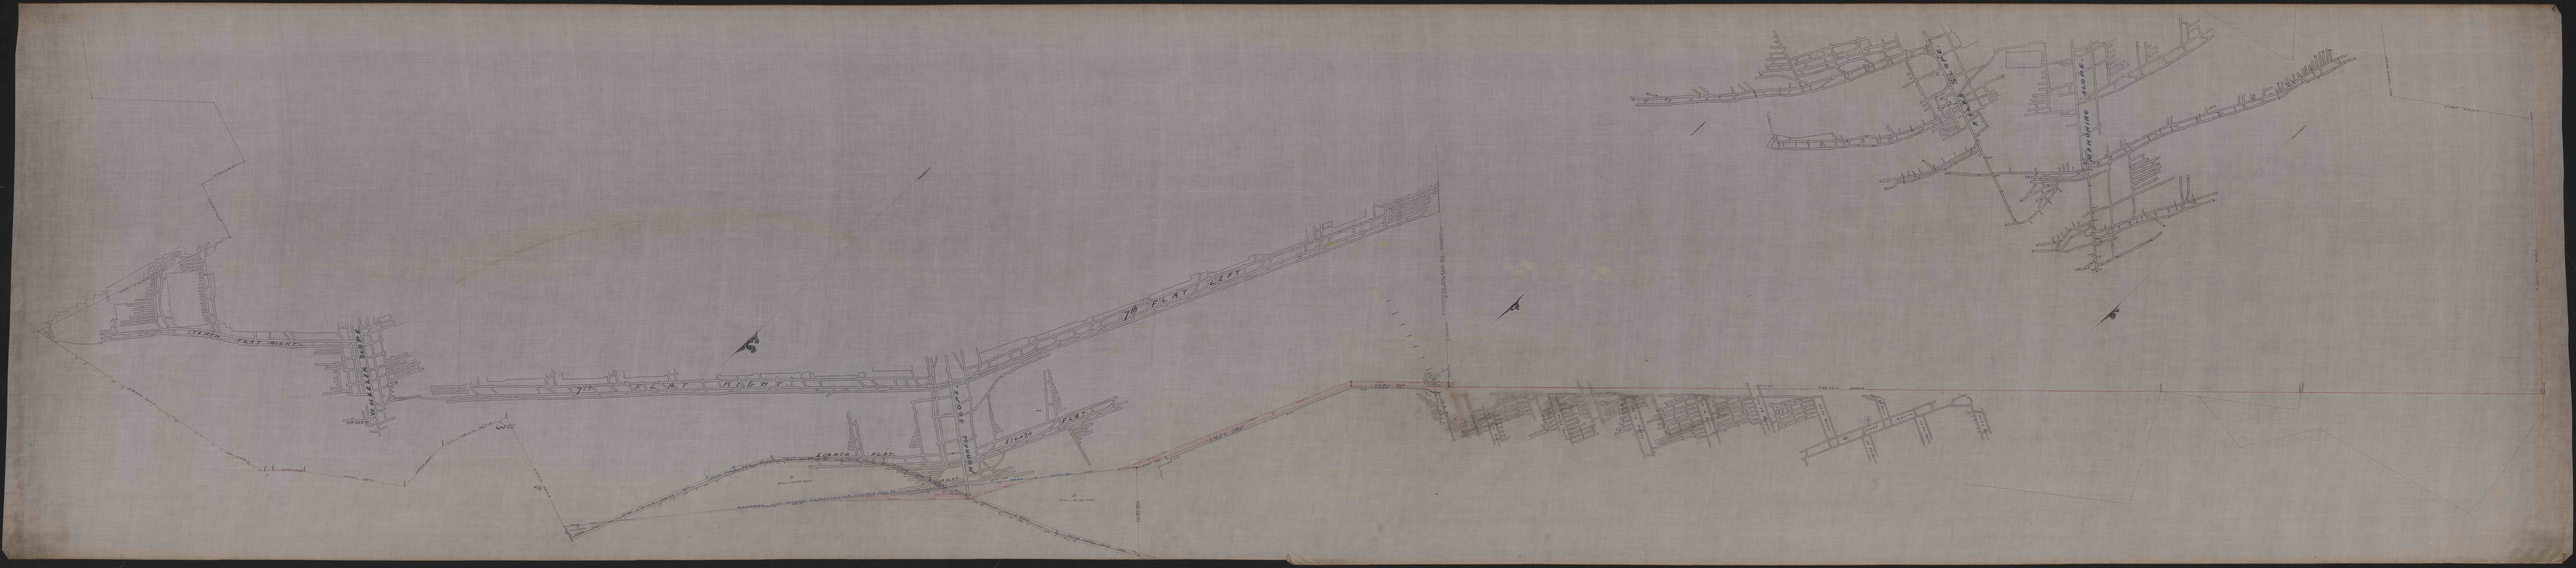
7th FLAT RIGHT
7th FLAT LEFT
