


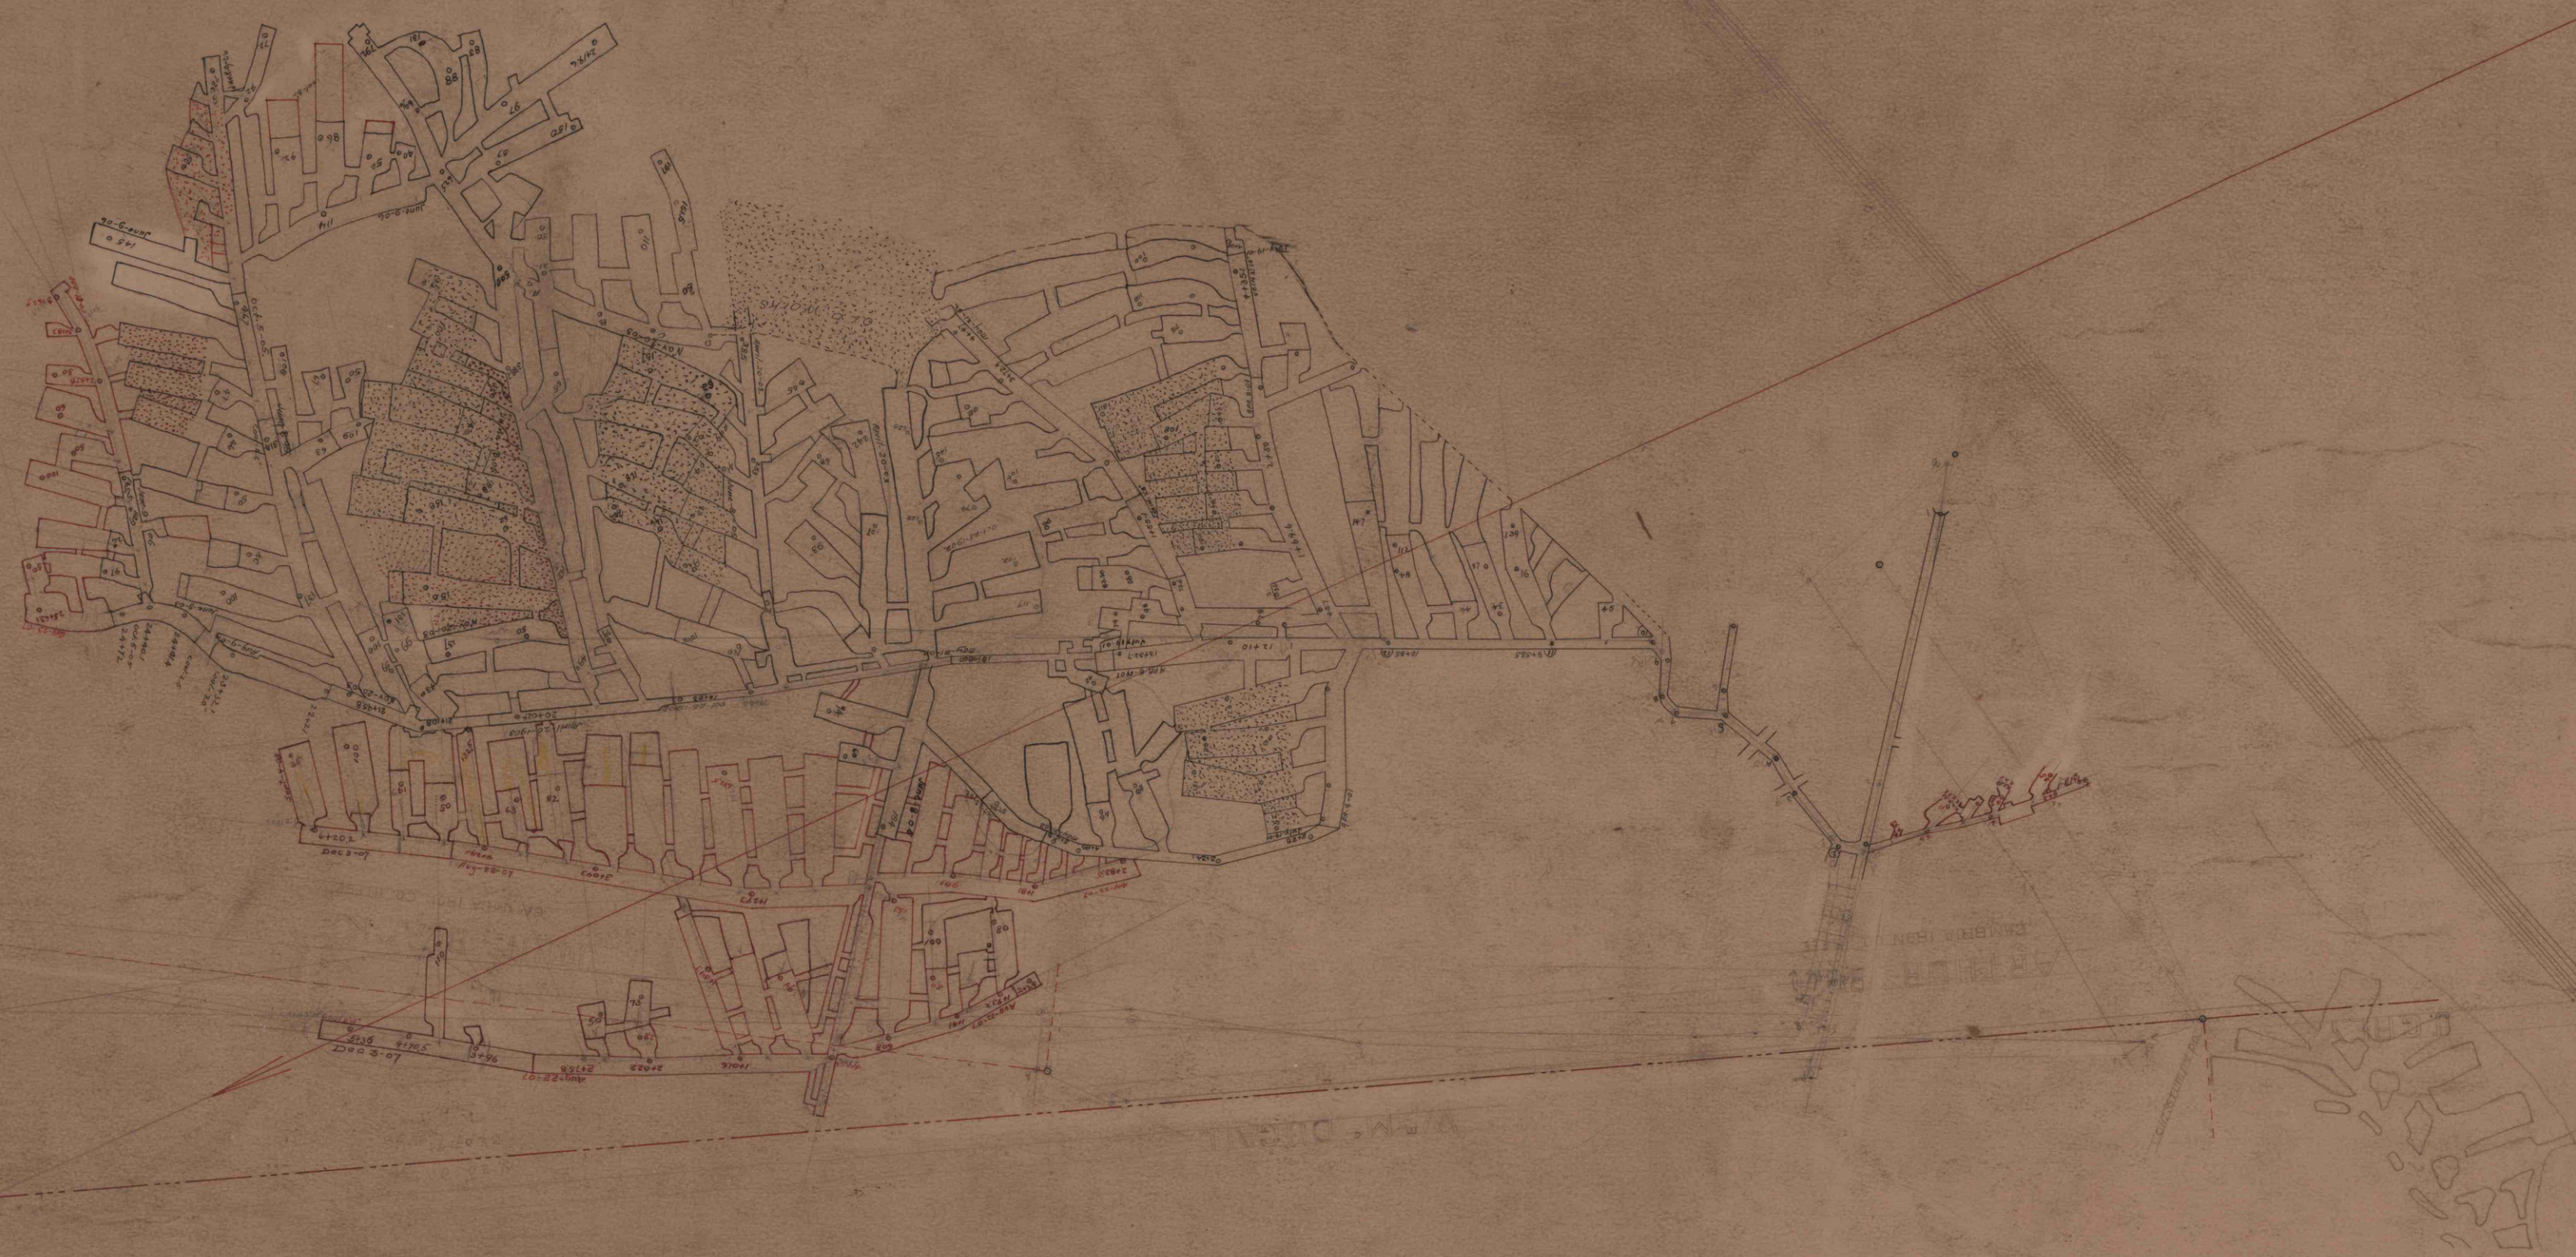

L.B.5