


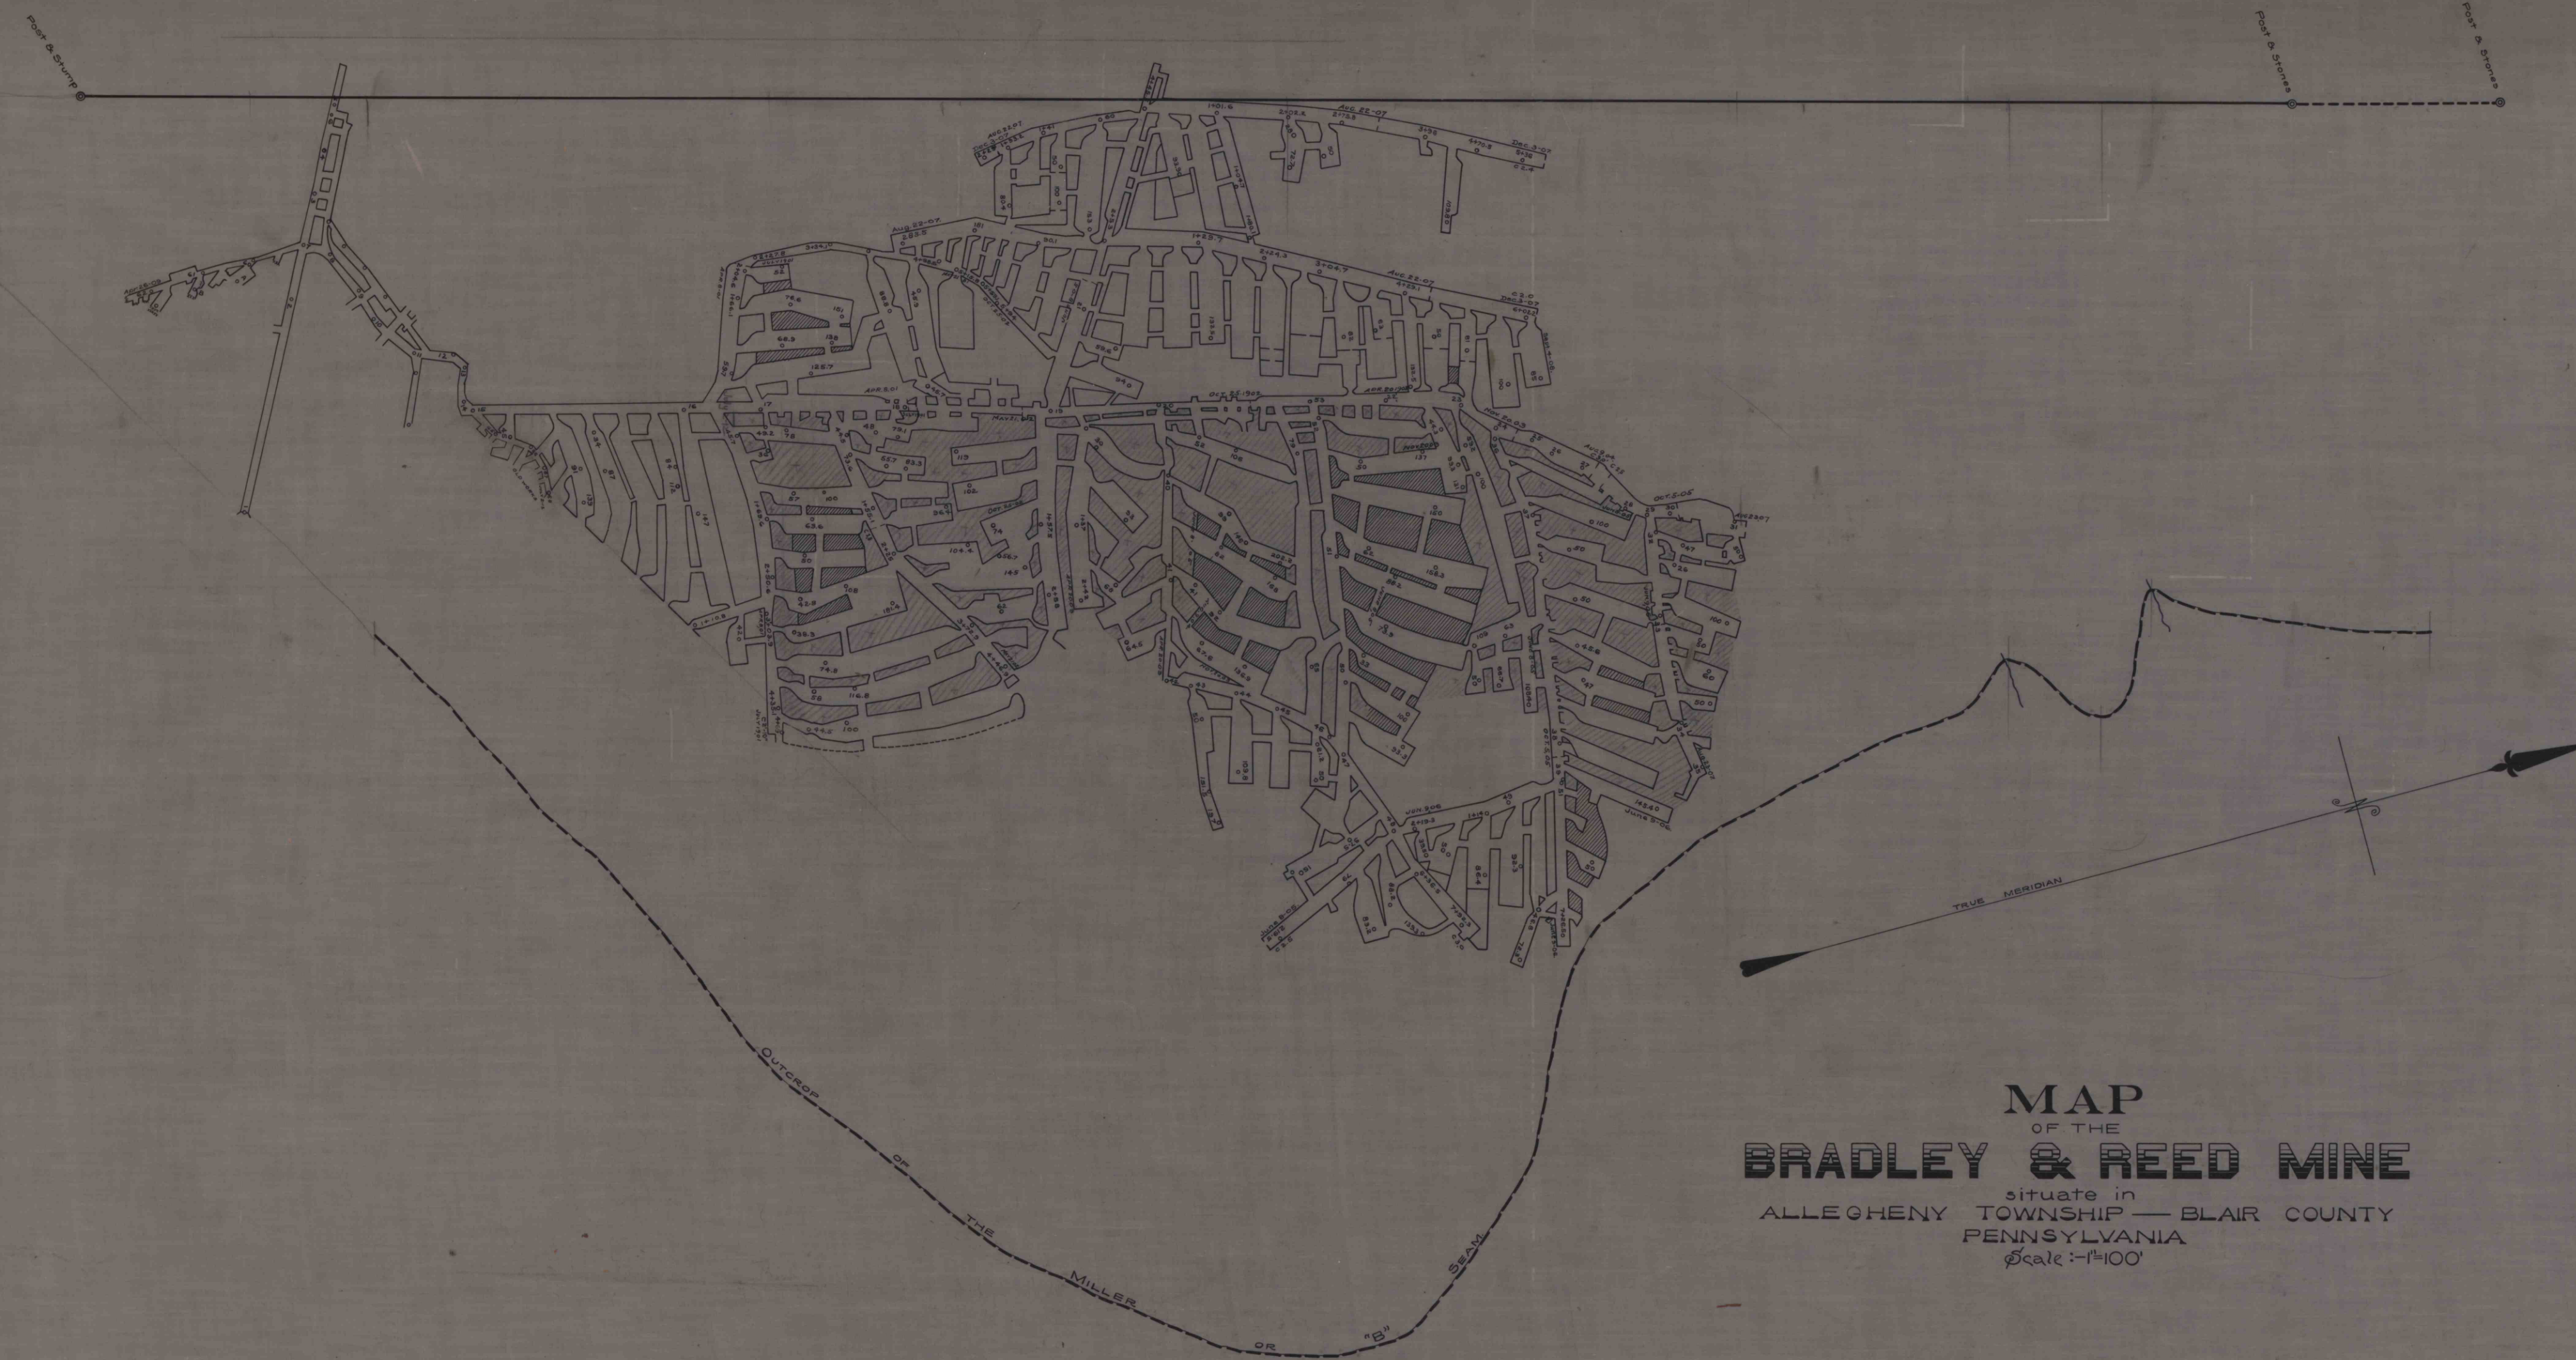

MAP
OF THE
BRADLEY & REED MINE
situate in
ALLEGHENY TOWNSHIP — BLAIR COUNTY
PENNSYLVANIA
Scale: 1"=100'