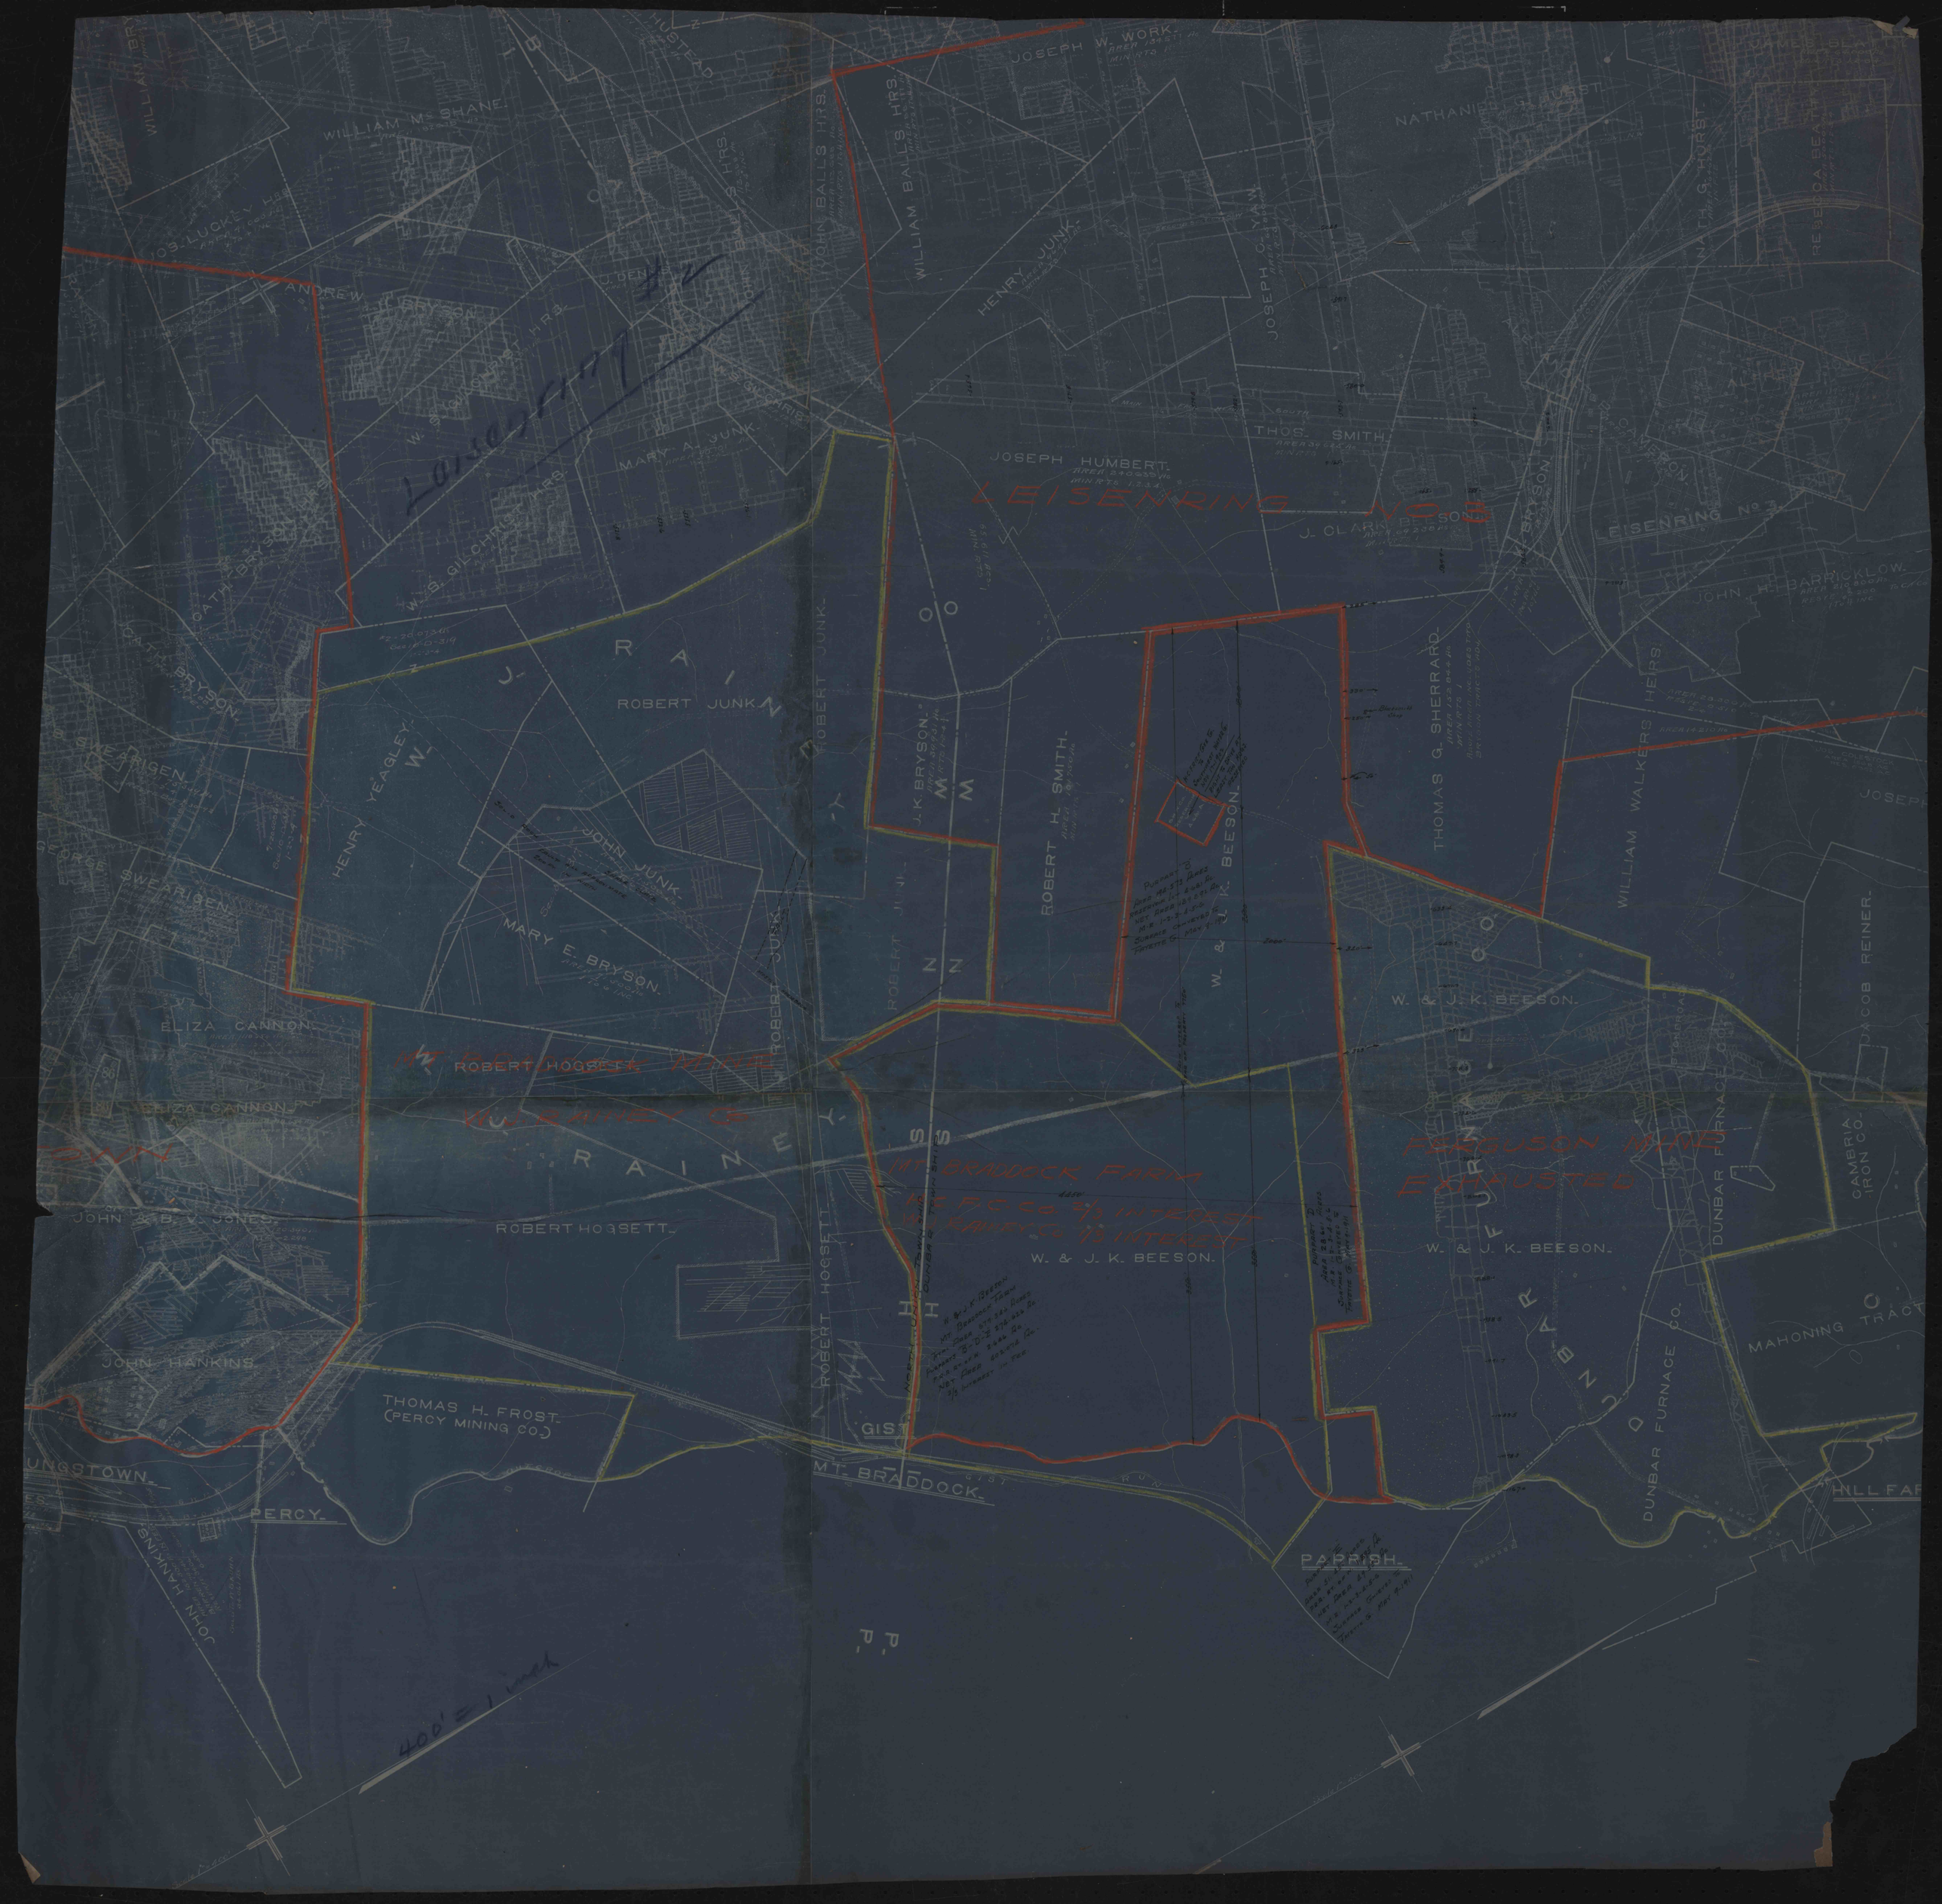
Longacre #6
WILLIAM McSHANE
JOS. LUCKEY HRS.
ANDREW BRYSON
W. S. GILCHRIST HRS.
MARY A. JUNK
JOHN BALLS HRS.
WILLIAM BALLS HRS.
HENRY JUNK
JOSEPH W. WORK
JOSEPH HUMBERT
THOS. SMITH
J. CLARK BEESON
LEISENRING No 3
JOHN H. BARRICKLOW
NATHAN G. HORST
THOMAS G. SHERRARD
WILLIAM WALKERS HEIRS
W. & J. K. BEESON
ROBERT JUNK
HENRY YEAGLEY
JOHN JUNK
MARY E. BRYSON
J. K. BRYSON
ROBERT H. SMITH
ROBERT HOGSETT
MT. BRADDOCK MINE
W.J. RAINEY Co
MT. BRADDOCK FARM
P.C.F.C. Co 2/3 INTEREST
W.J. RAINEY Co 1/3 INTEREST
FERGUSON MINE
EXHAUSTED
ELIZA CANNON
JOHN & B. V. JONES
JOHN HANKINS
THOMAS H. FROST
(PERCY MINING CO.)
DUNBAR FURNACE Co.
CAMBRIA IRON CO.
MAHONING TRACT
MT. BRADDOCK
PERCY
P.A.PRISH
400' = 1 inch