


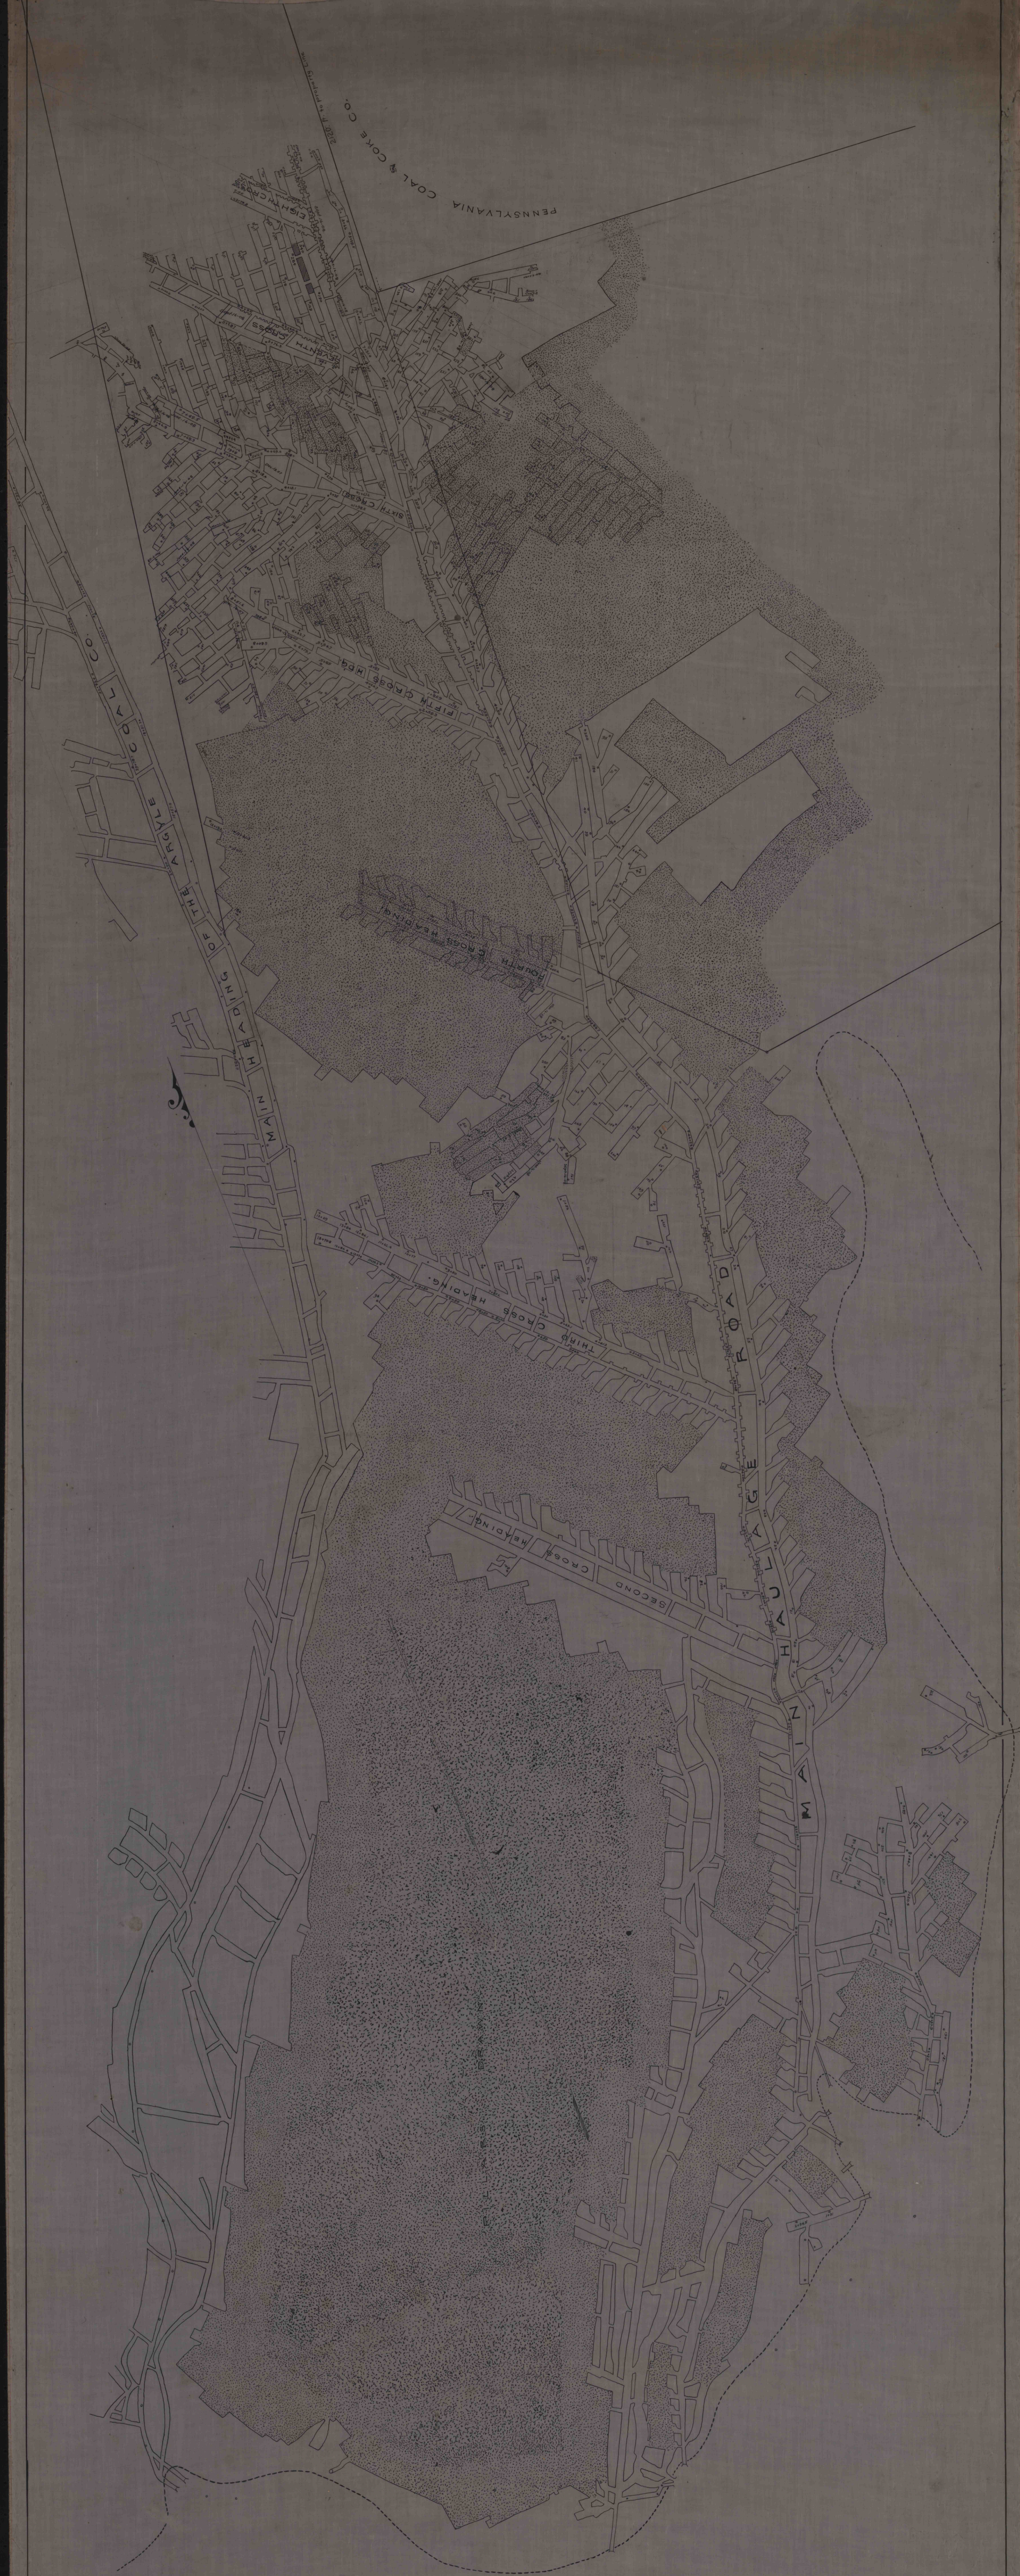

MAP
OF THE
AURORA MINE
operated by the
PRISCILLA COAL MINING CO.
— situate —
CAMBRIA CO. PA.
1908
Scale — 100' = 1 inch.

CAMBRIA STEEL CO.
J. E. G. DUFFY
Date 10-10-1907. Name 647-1000
INDEX NO. L. B. 4-D