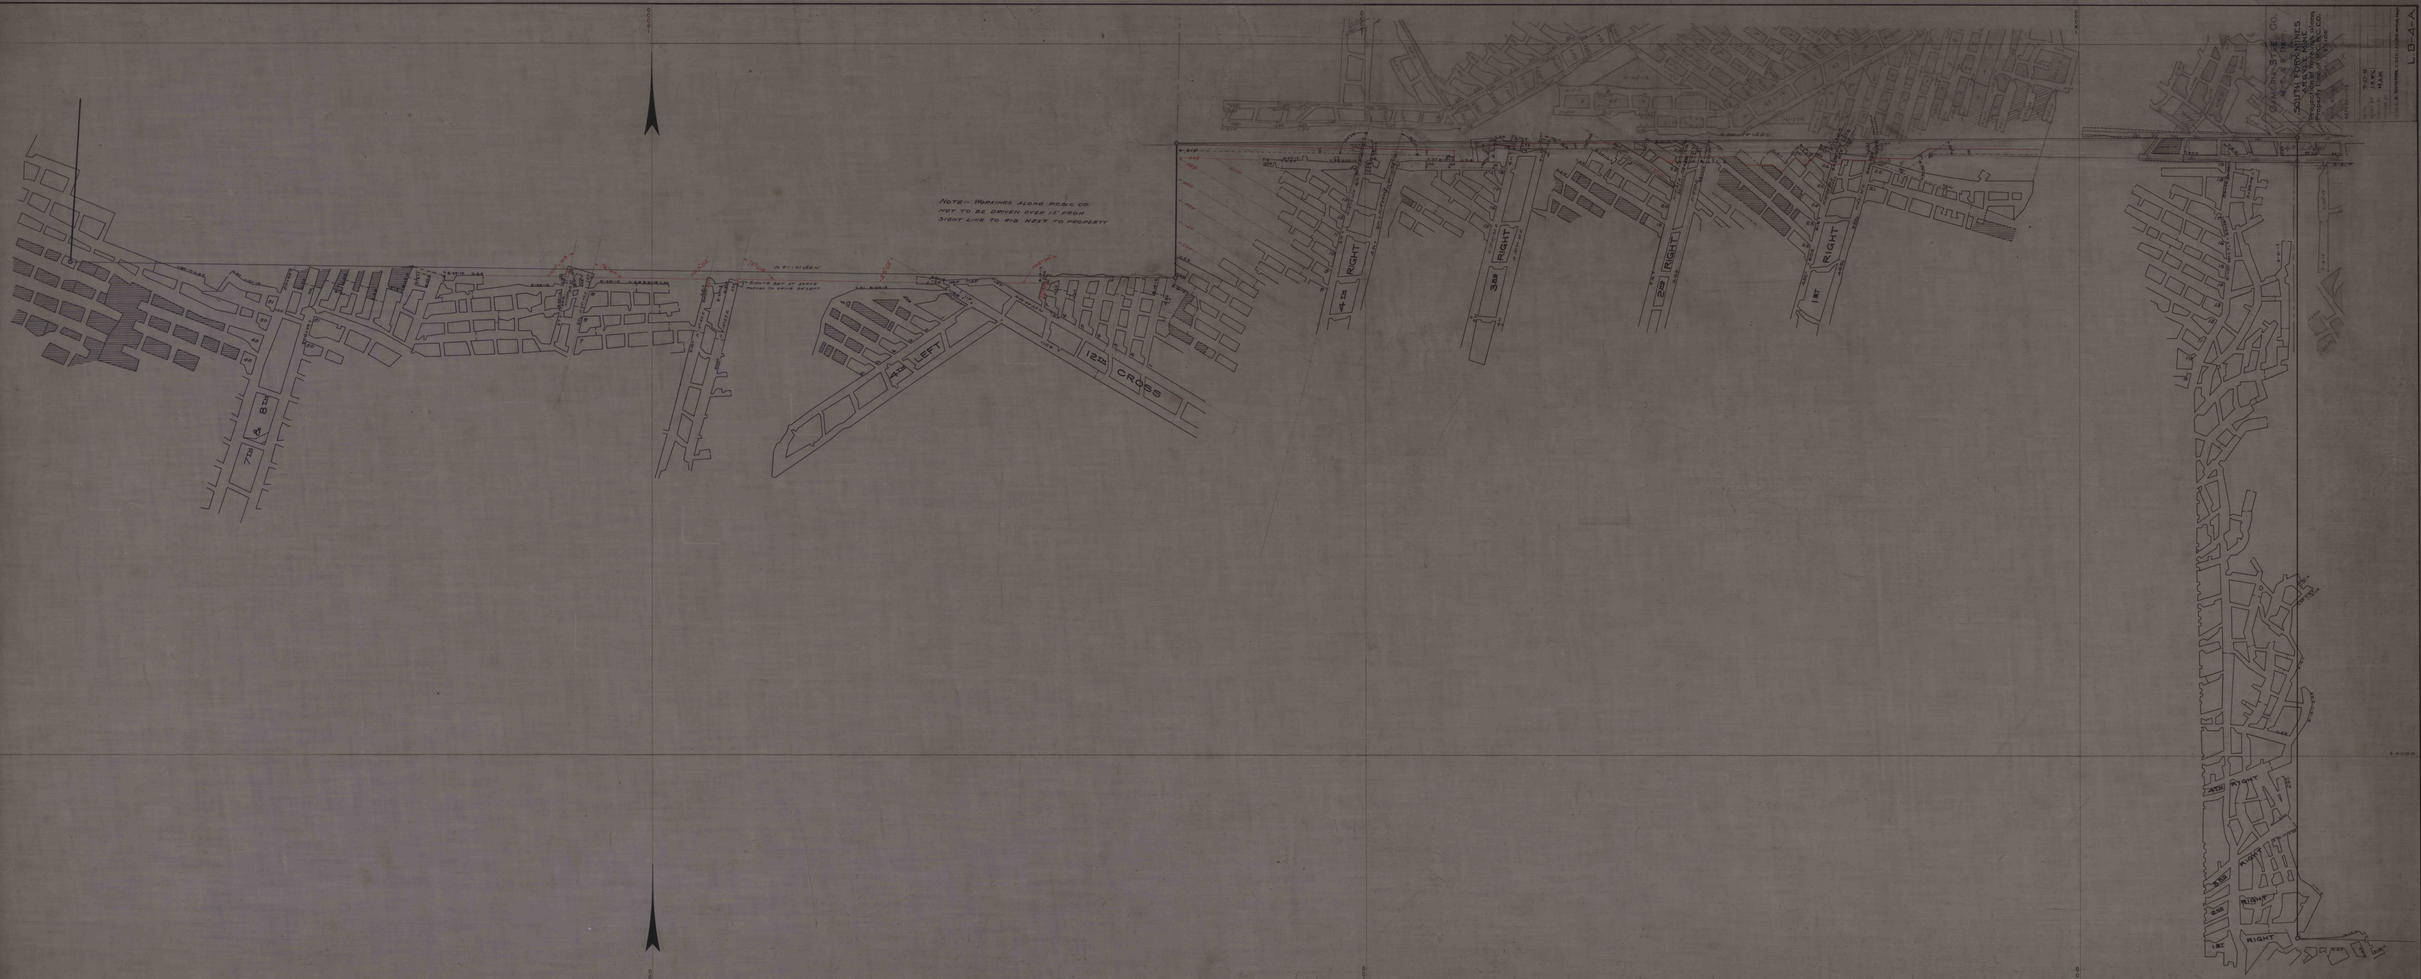
NOTE- WORKINGS ALONG P.C.& C. CO.
NOT TO BE DRIVEN OVER 15' FROM
DIRECT LINE TO RIB NEXT TO PROPERTY
7TH
8TH
12TH
CROSS
LEFT
RIGHT
1ST
2ND
3RD
4TH
L.B.-A.-A