


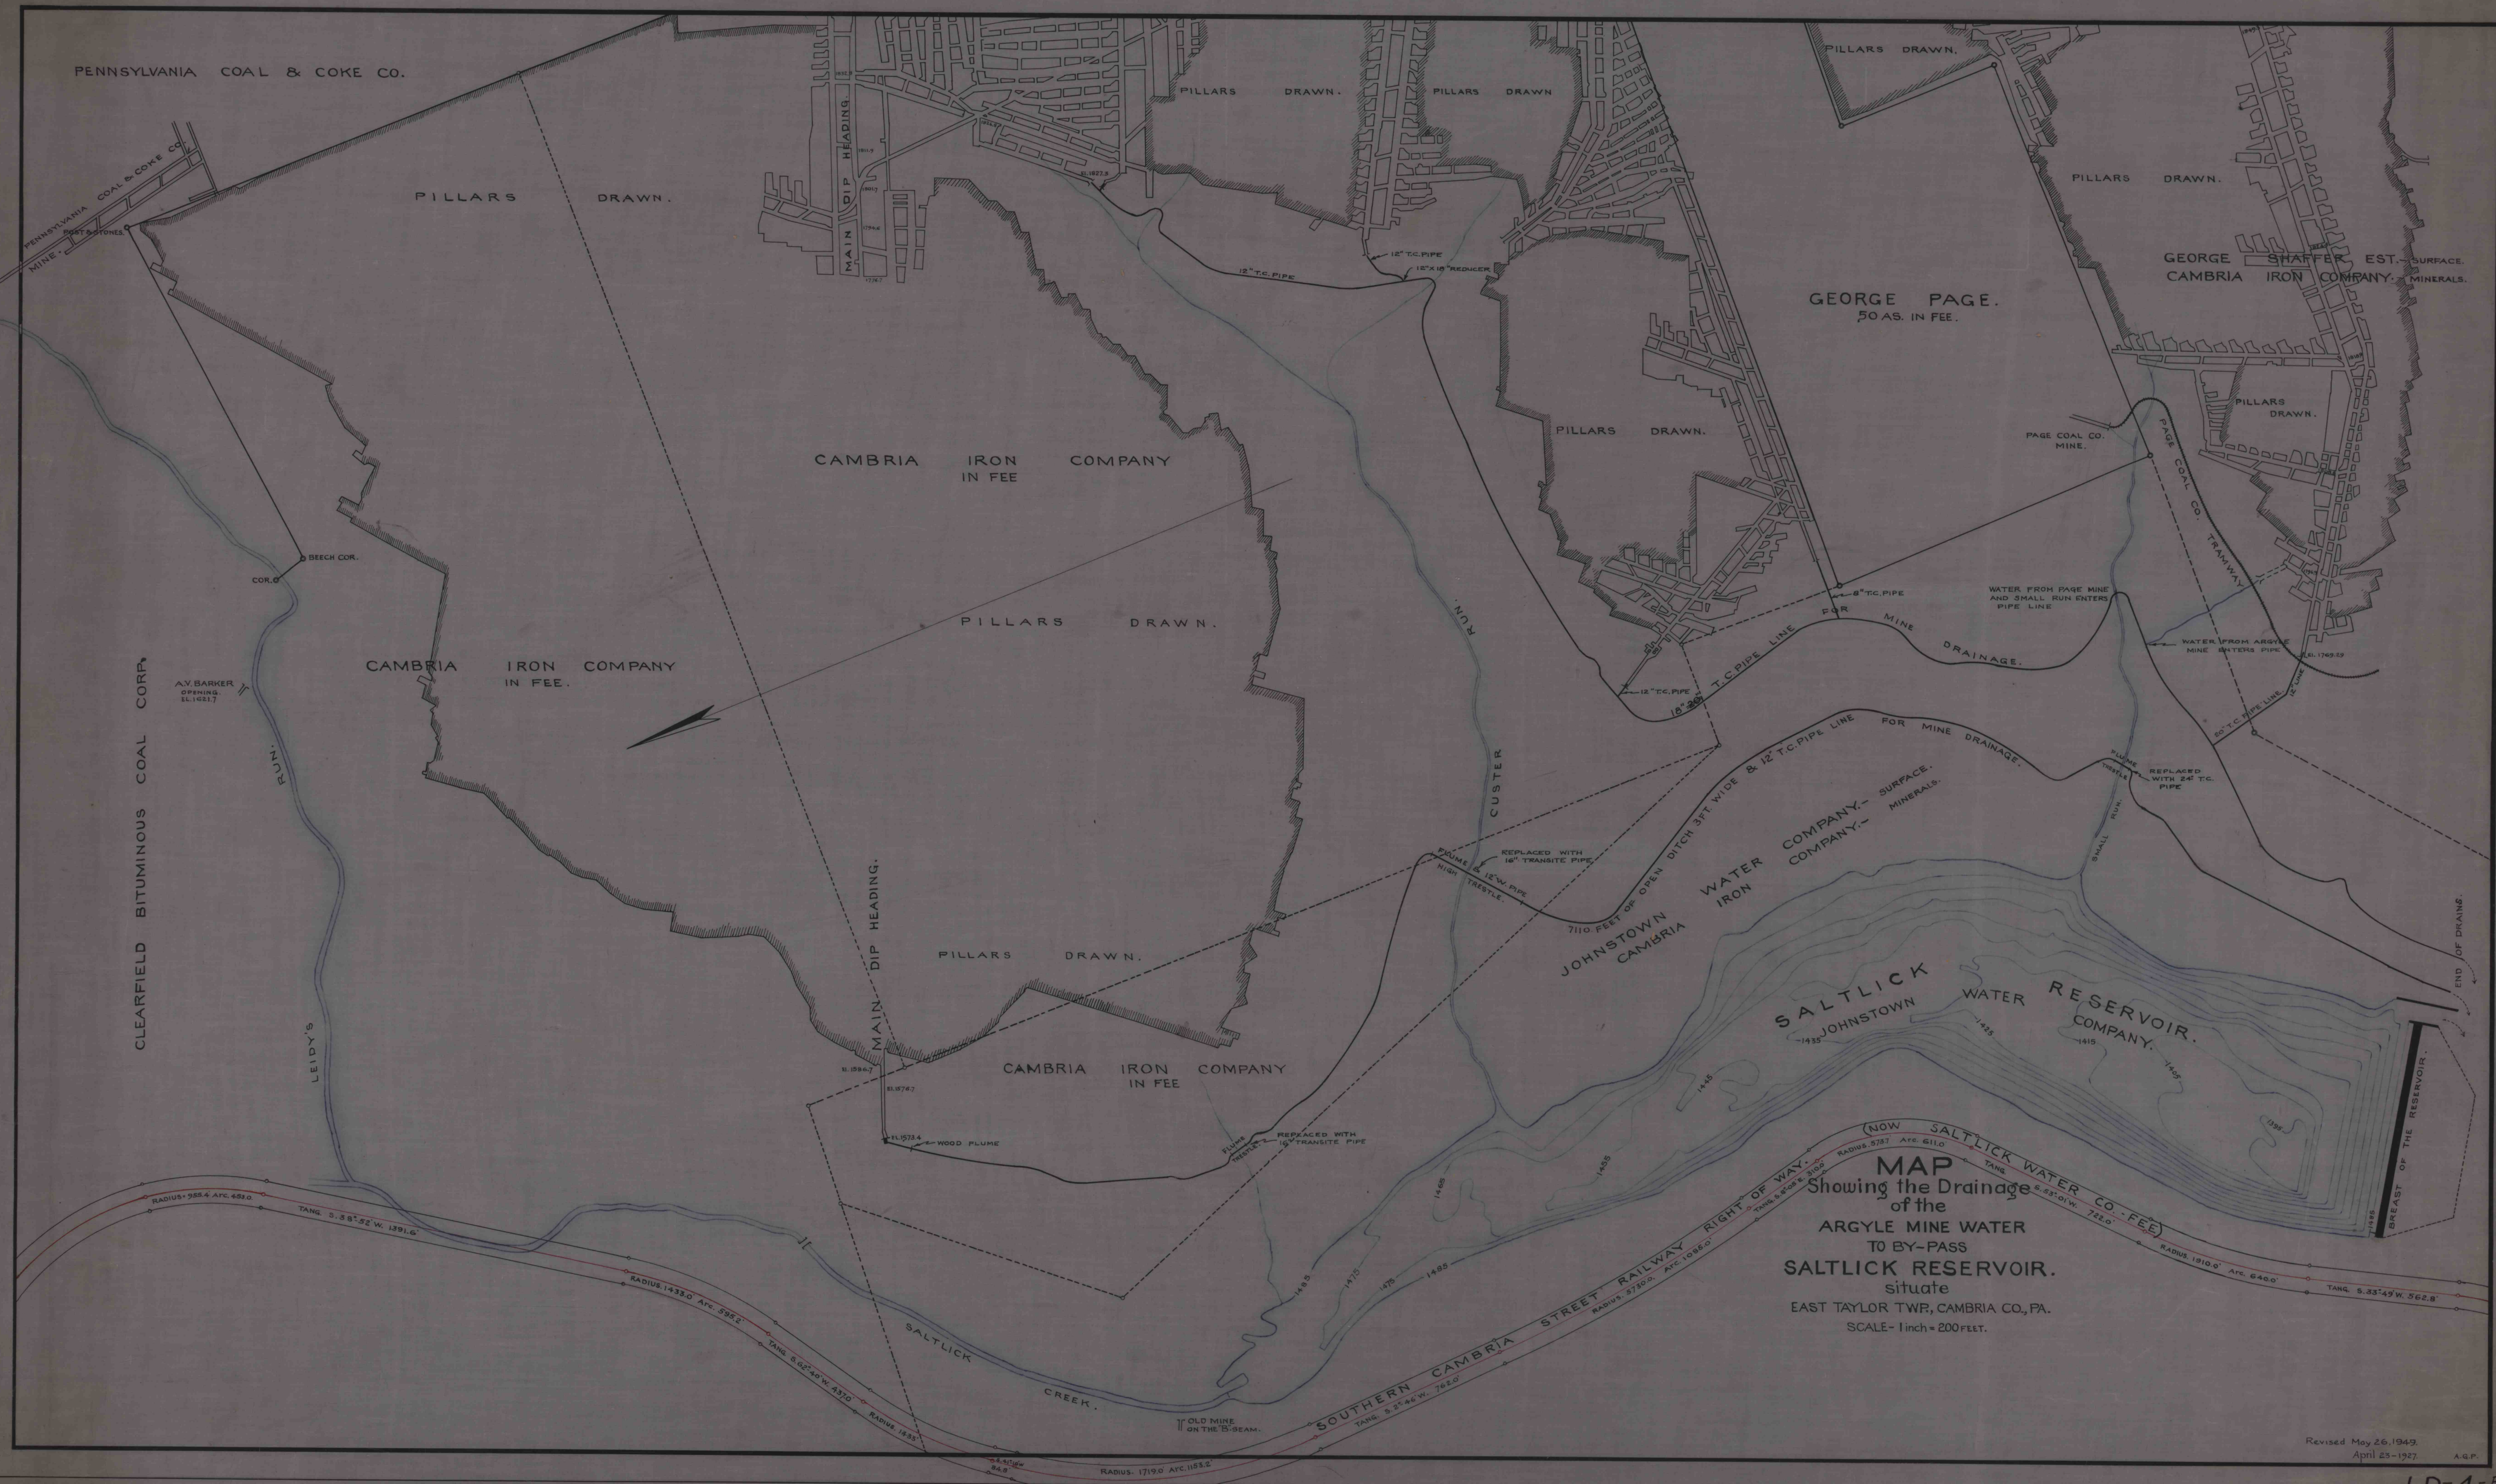

MAP
Showing the Drainage
of the
ARGYLE MINE WATER
TO BY-PASS
SALTICK RESERVOIR.
situate
EAST TAYLOR TWP., CAMBRIA CO., PA.
SCALE- 1 inch = 200 FEET.

Revised May 26, 1949.
April 23-1927. A.G.P.