


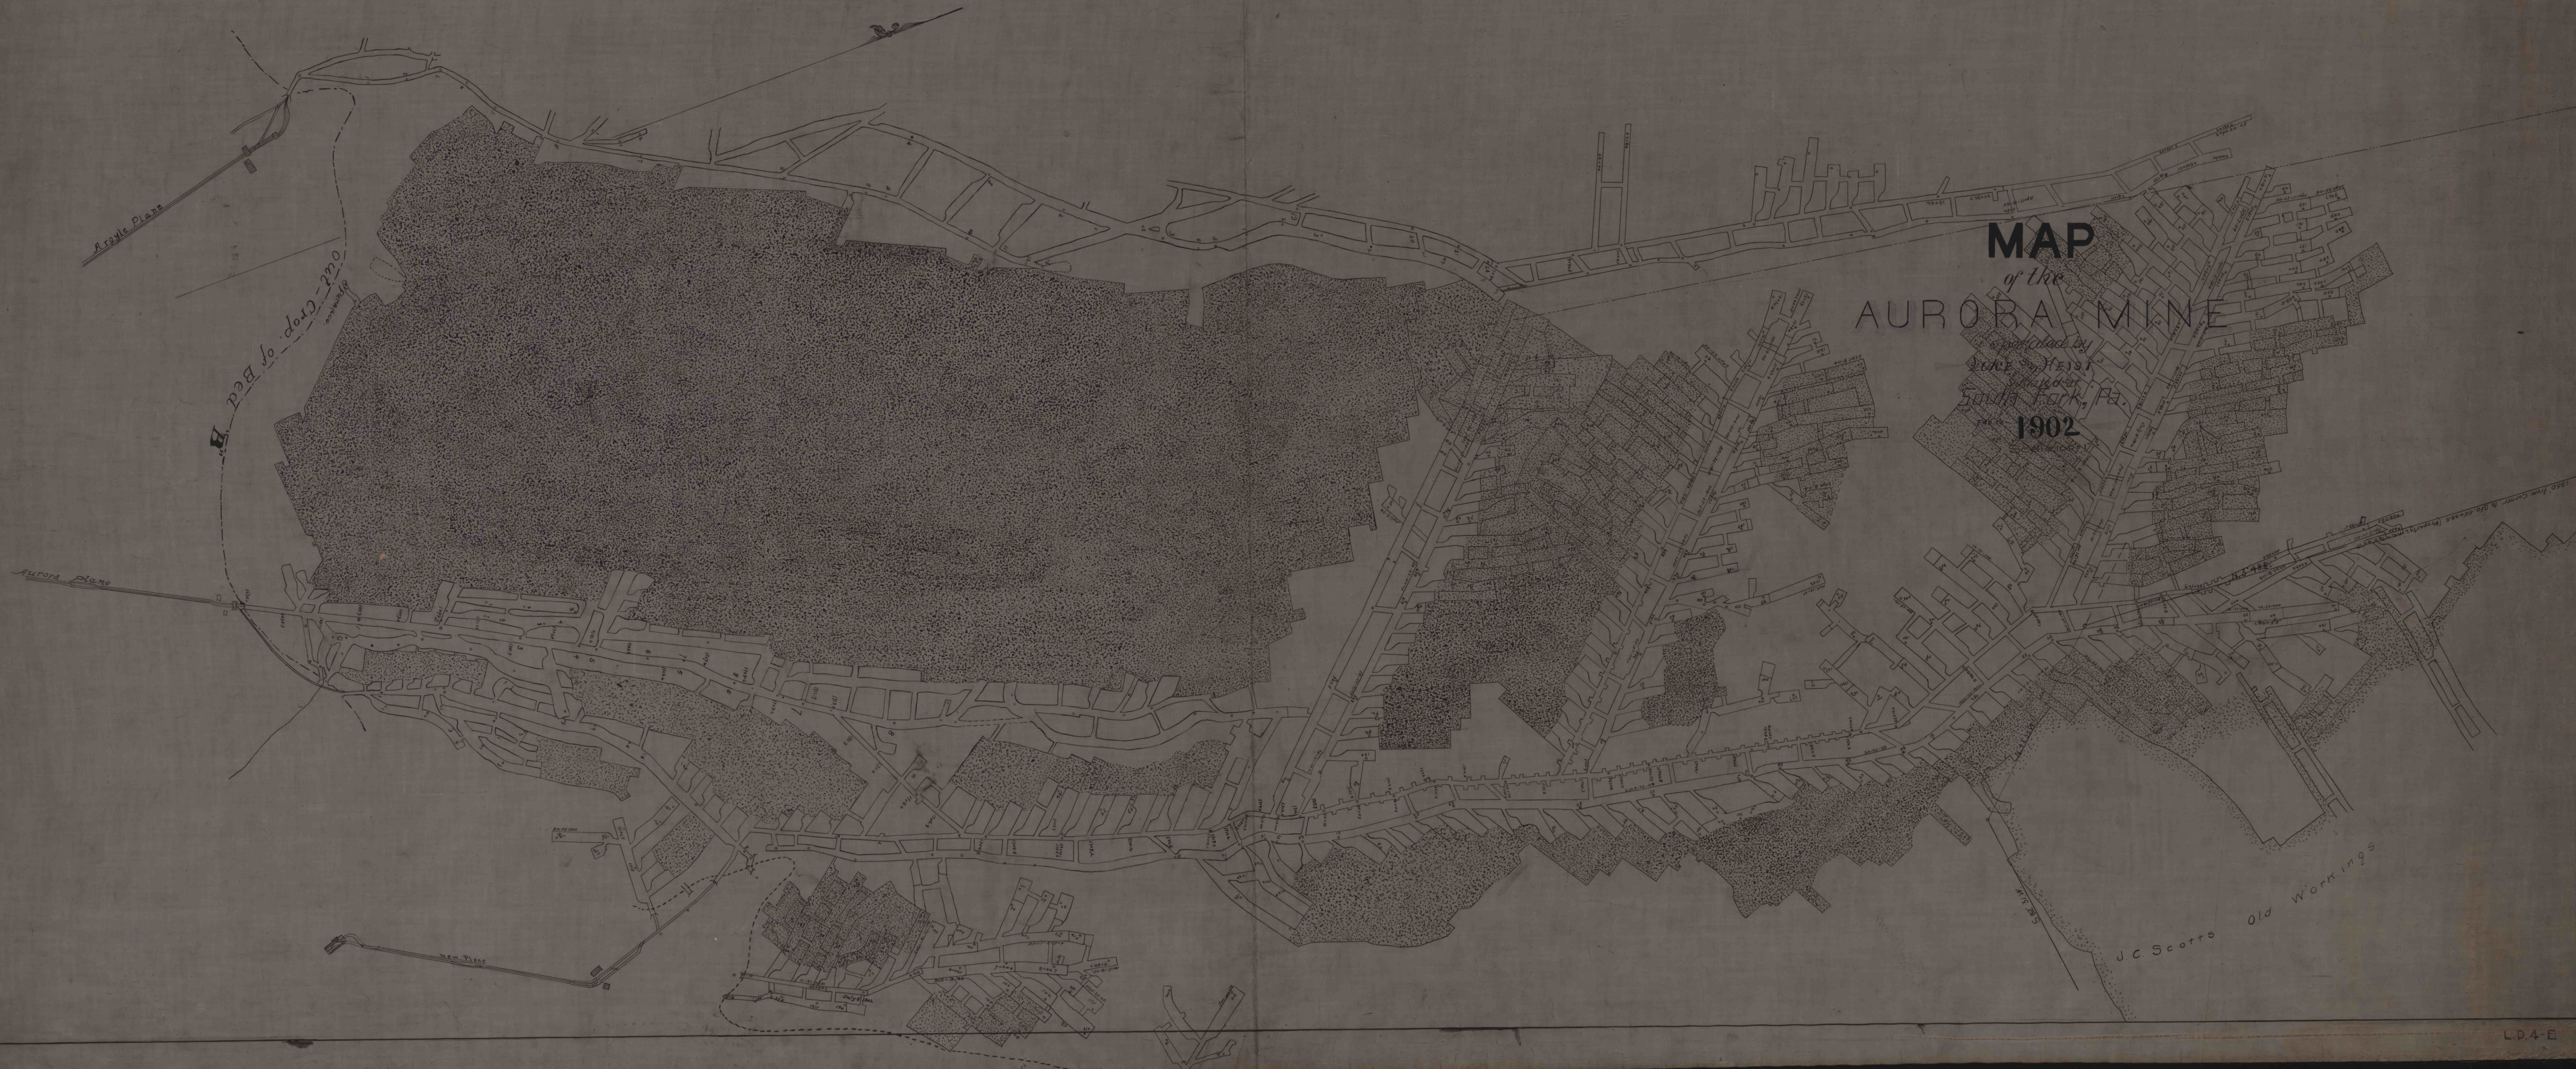

MAP
of the
AURORA MINE

compiled by
South Fork, Pa.
1902

J.C. Scotts
Old Workings