


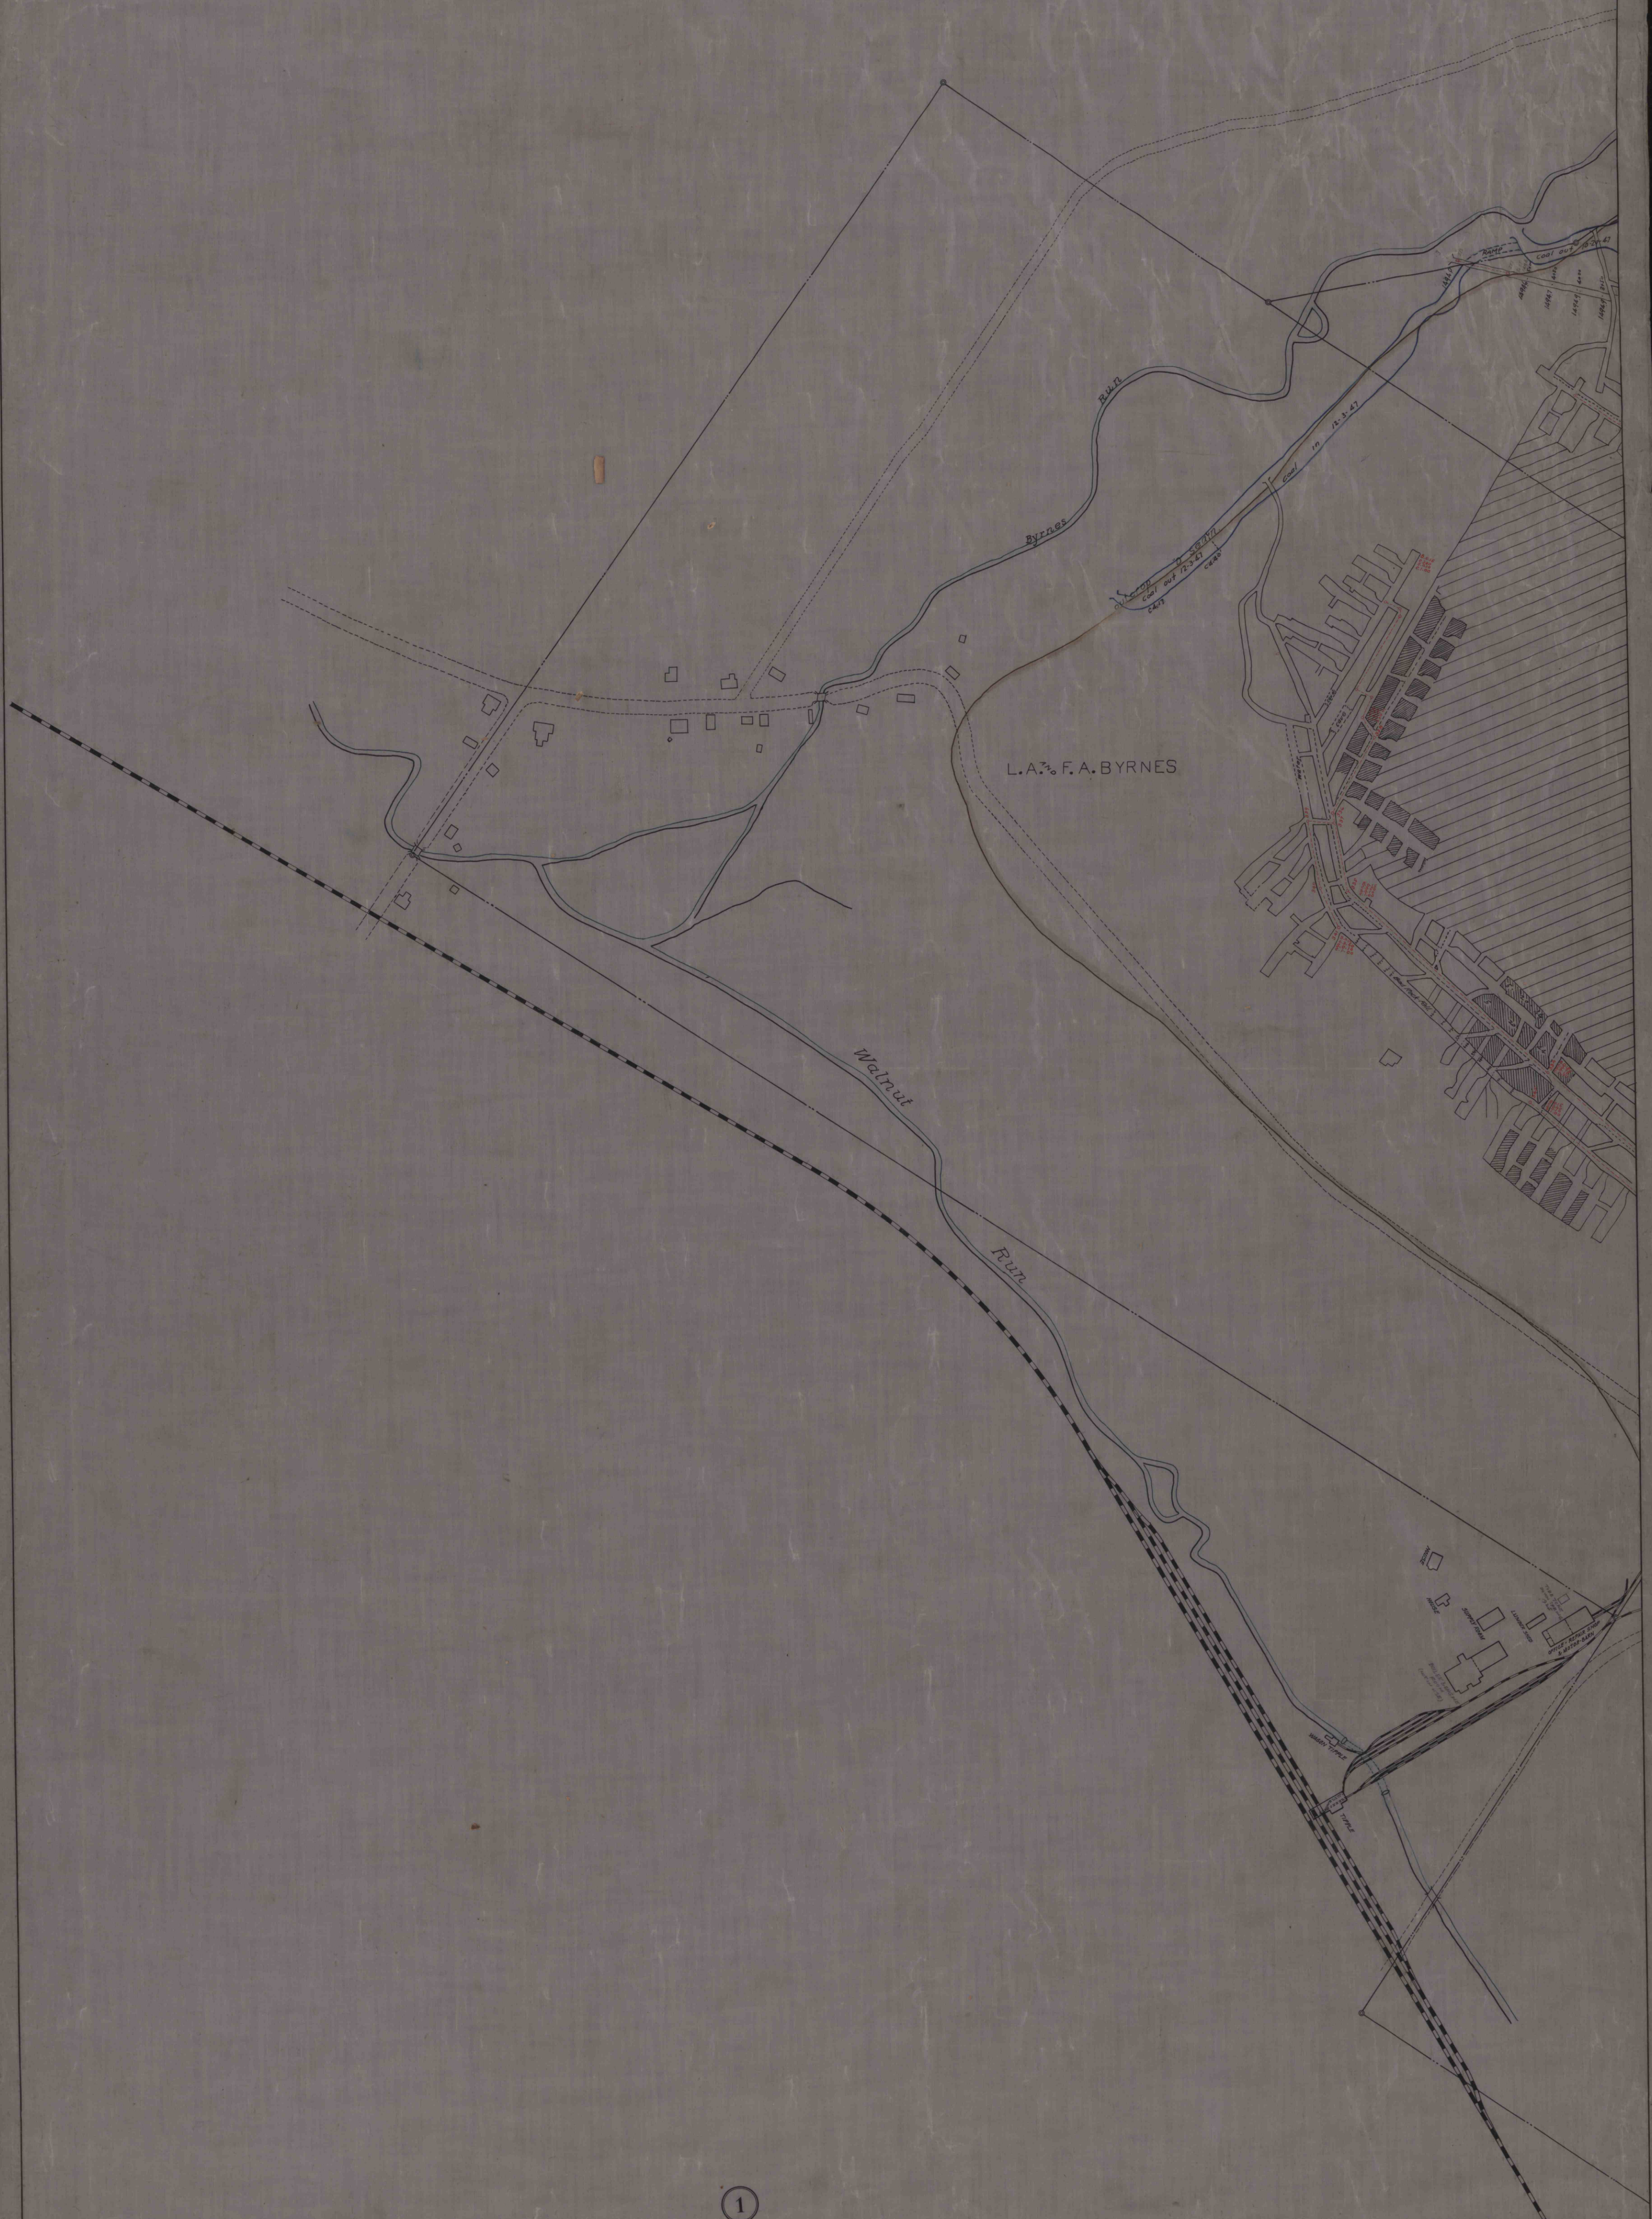

PENNSYLVANIA COAL AND COKE CORPORATION
BARNESBORO NO. 17-D MINE
"D" SEAM OF COAL
Scale 1"=100'