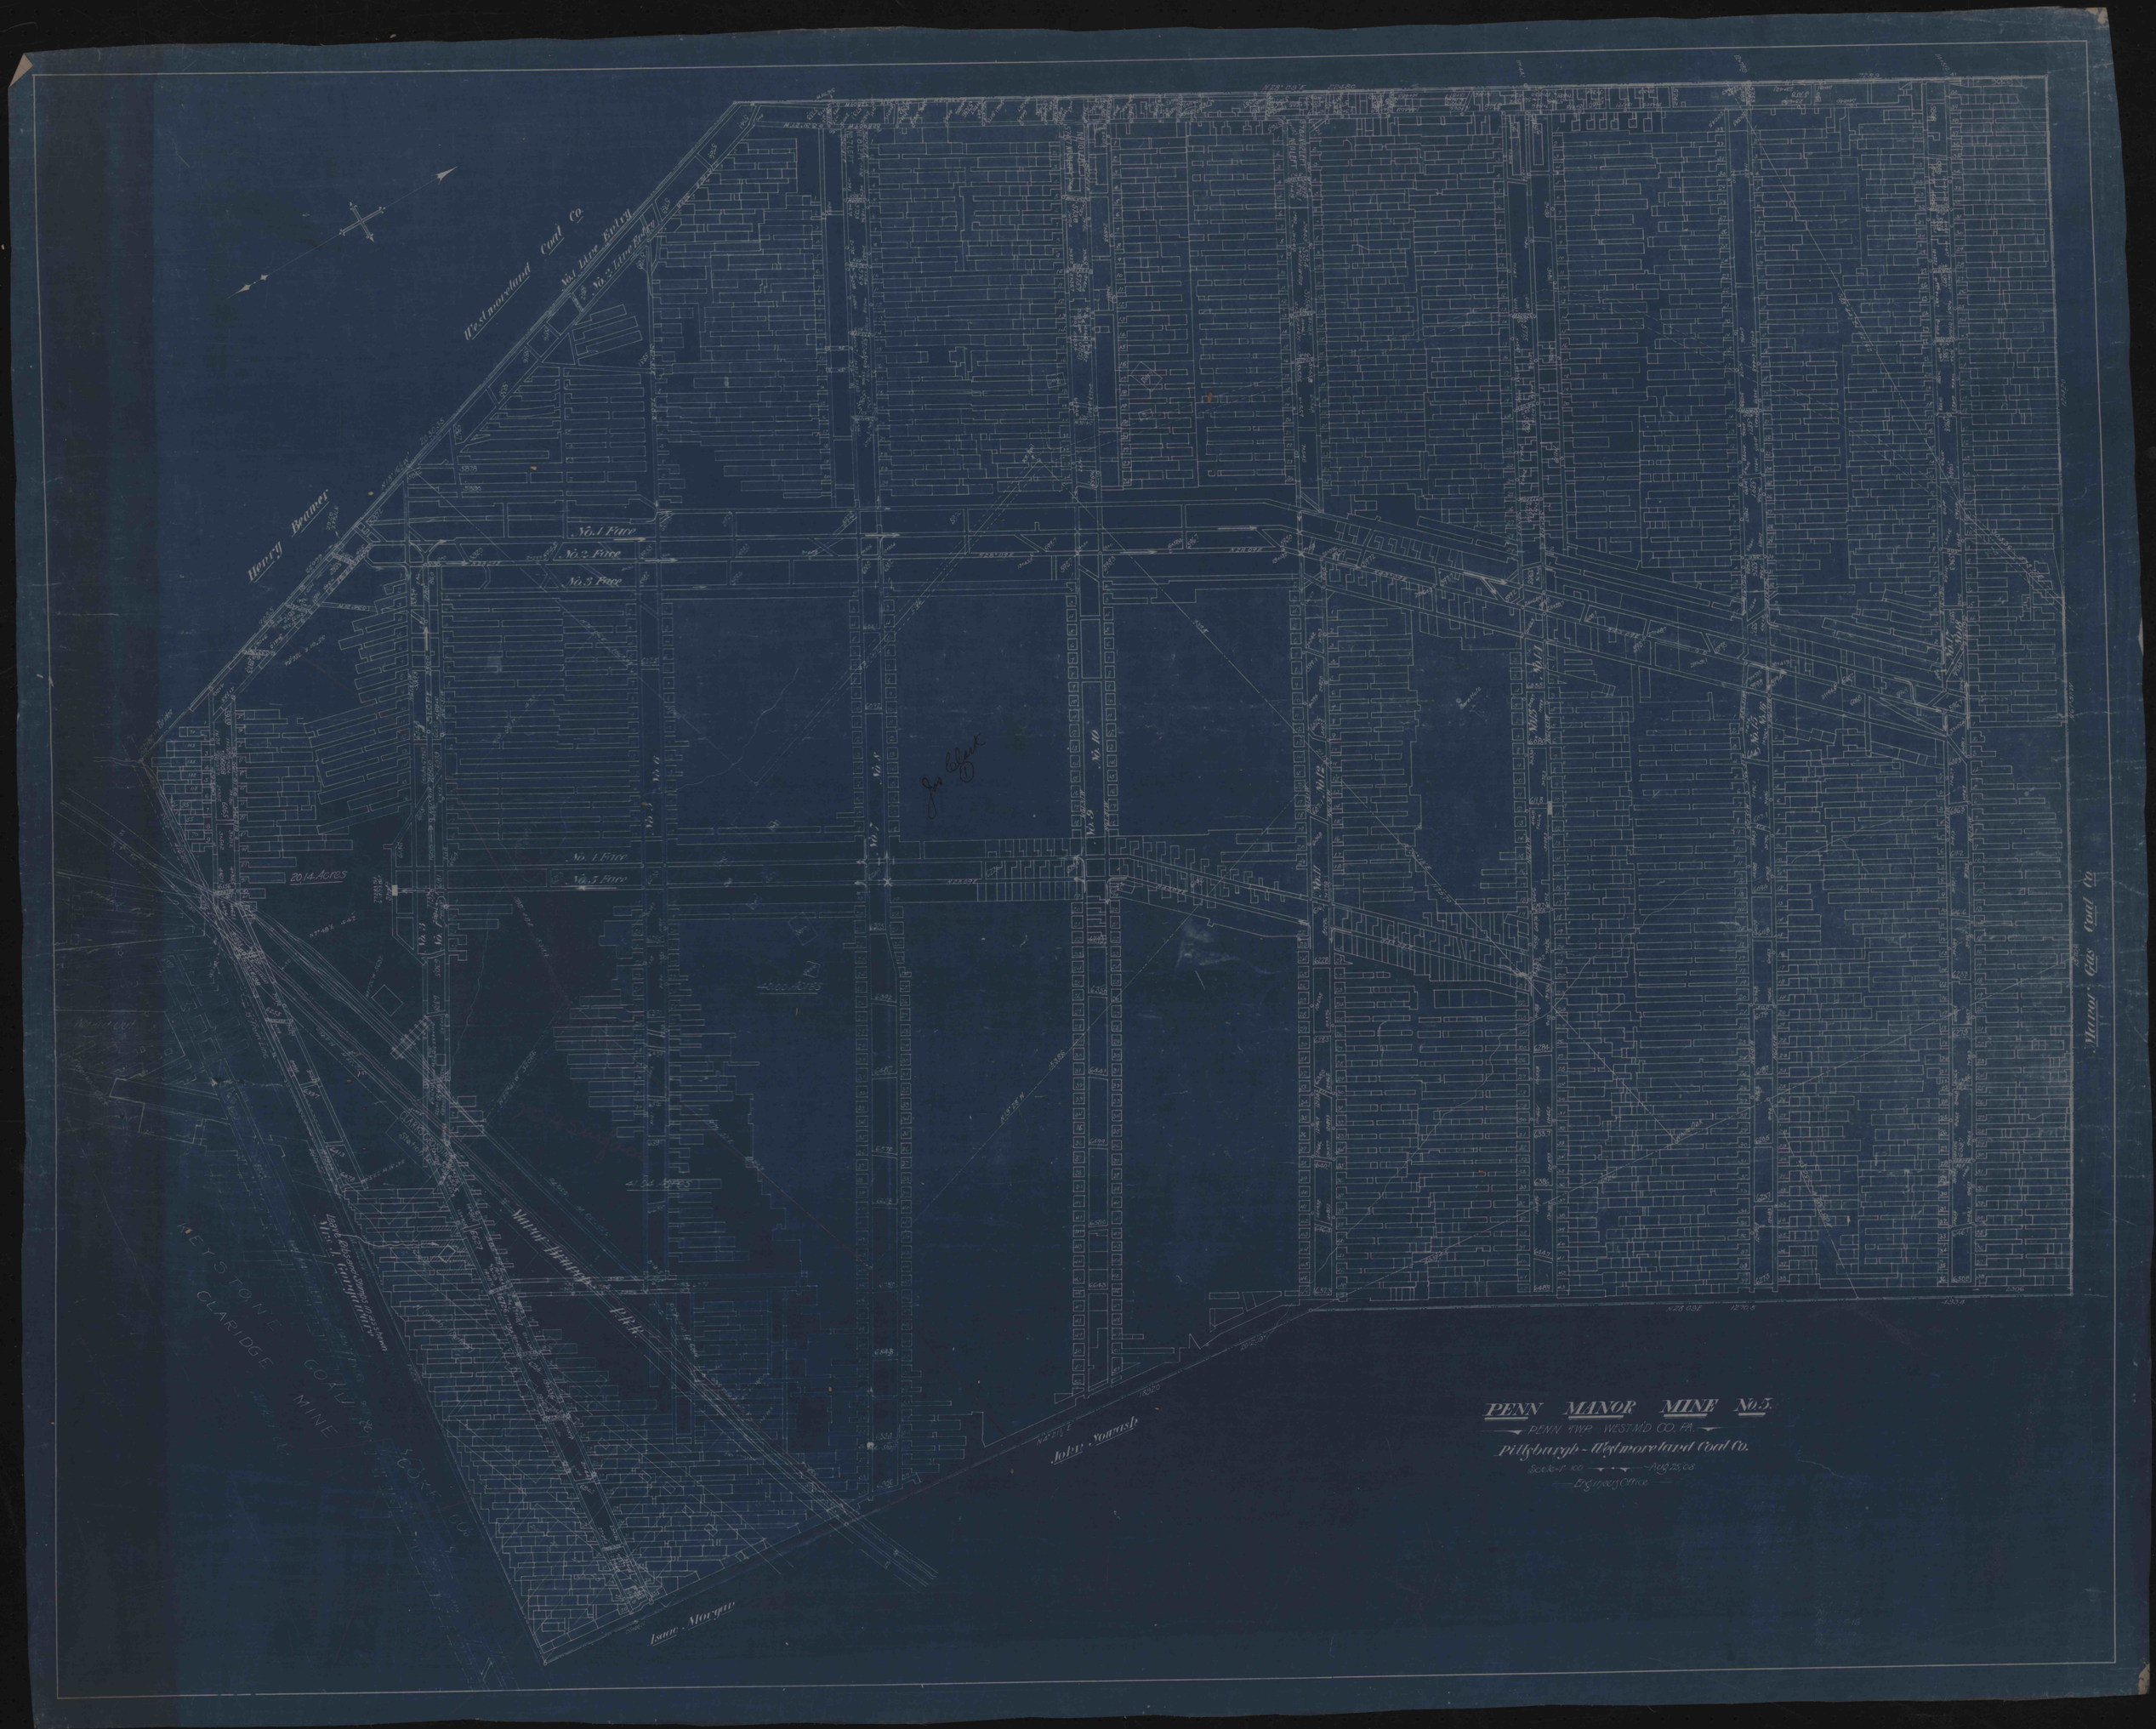
PENN MANOR MINE No.5.
PENN TWP. WEST'MD CO. PA.
Pittsburgh - Westmoreland Coal Co.
Engineers Office
Westmoreland Coal Co.
No.1 Fire Entry
No.2 Fire Entry
Henry Beaver
No.1 Face
No.2 Face
No.3 Face
No.1 Face
No.3 Face
2014 Acres
Manor Gas Coal Co.
John Somerset
Isaac Morgan
KEYSTONE CLARIDGE COAL & COKE CO.
Jas Clark