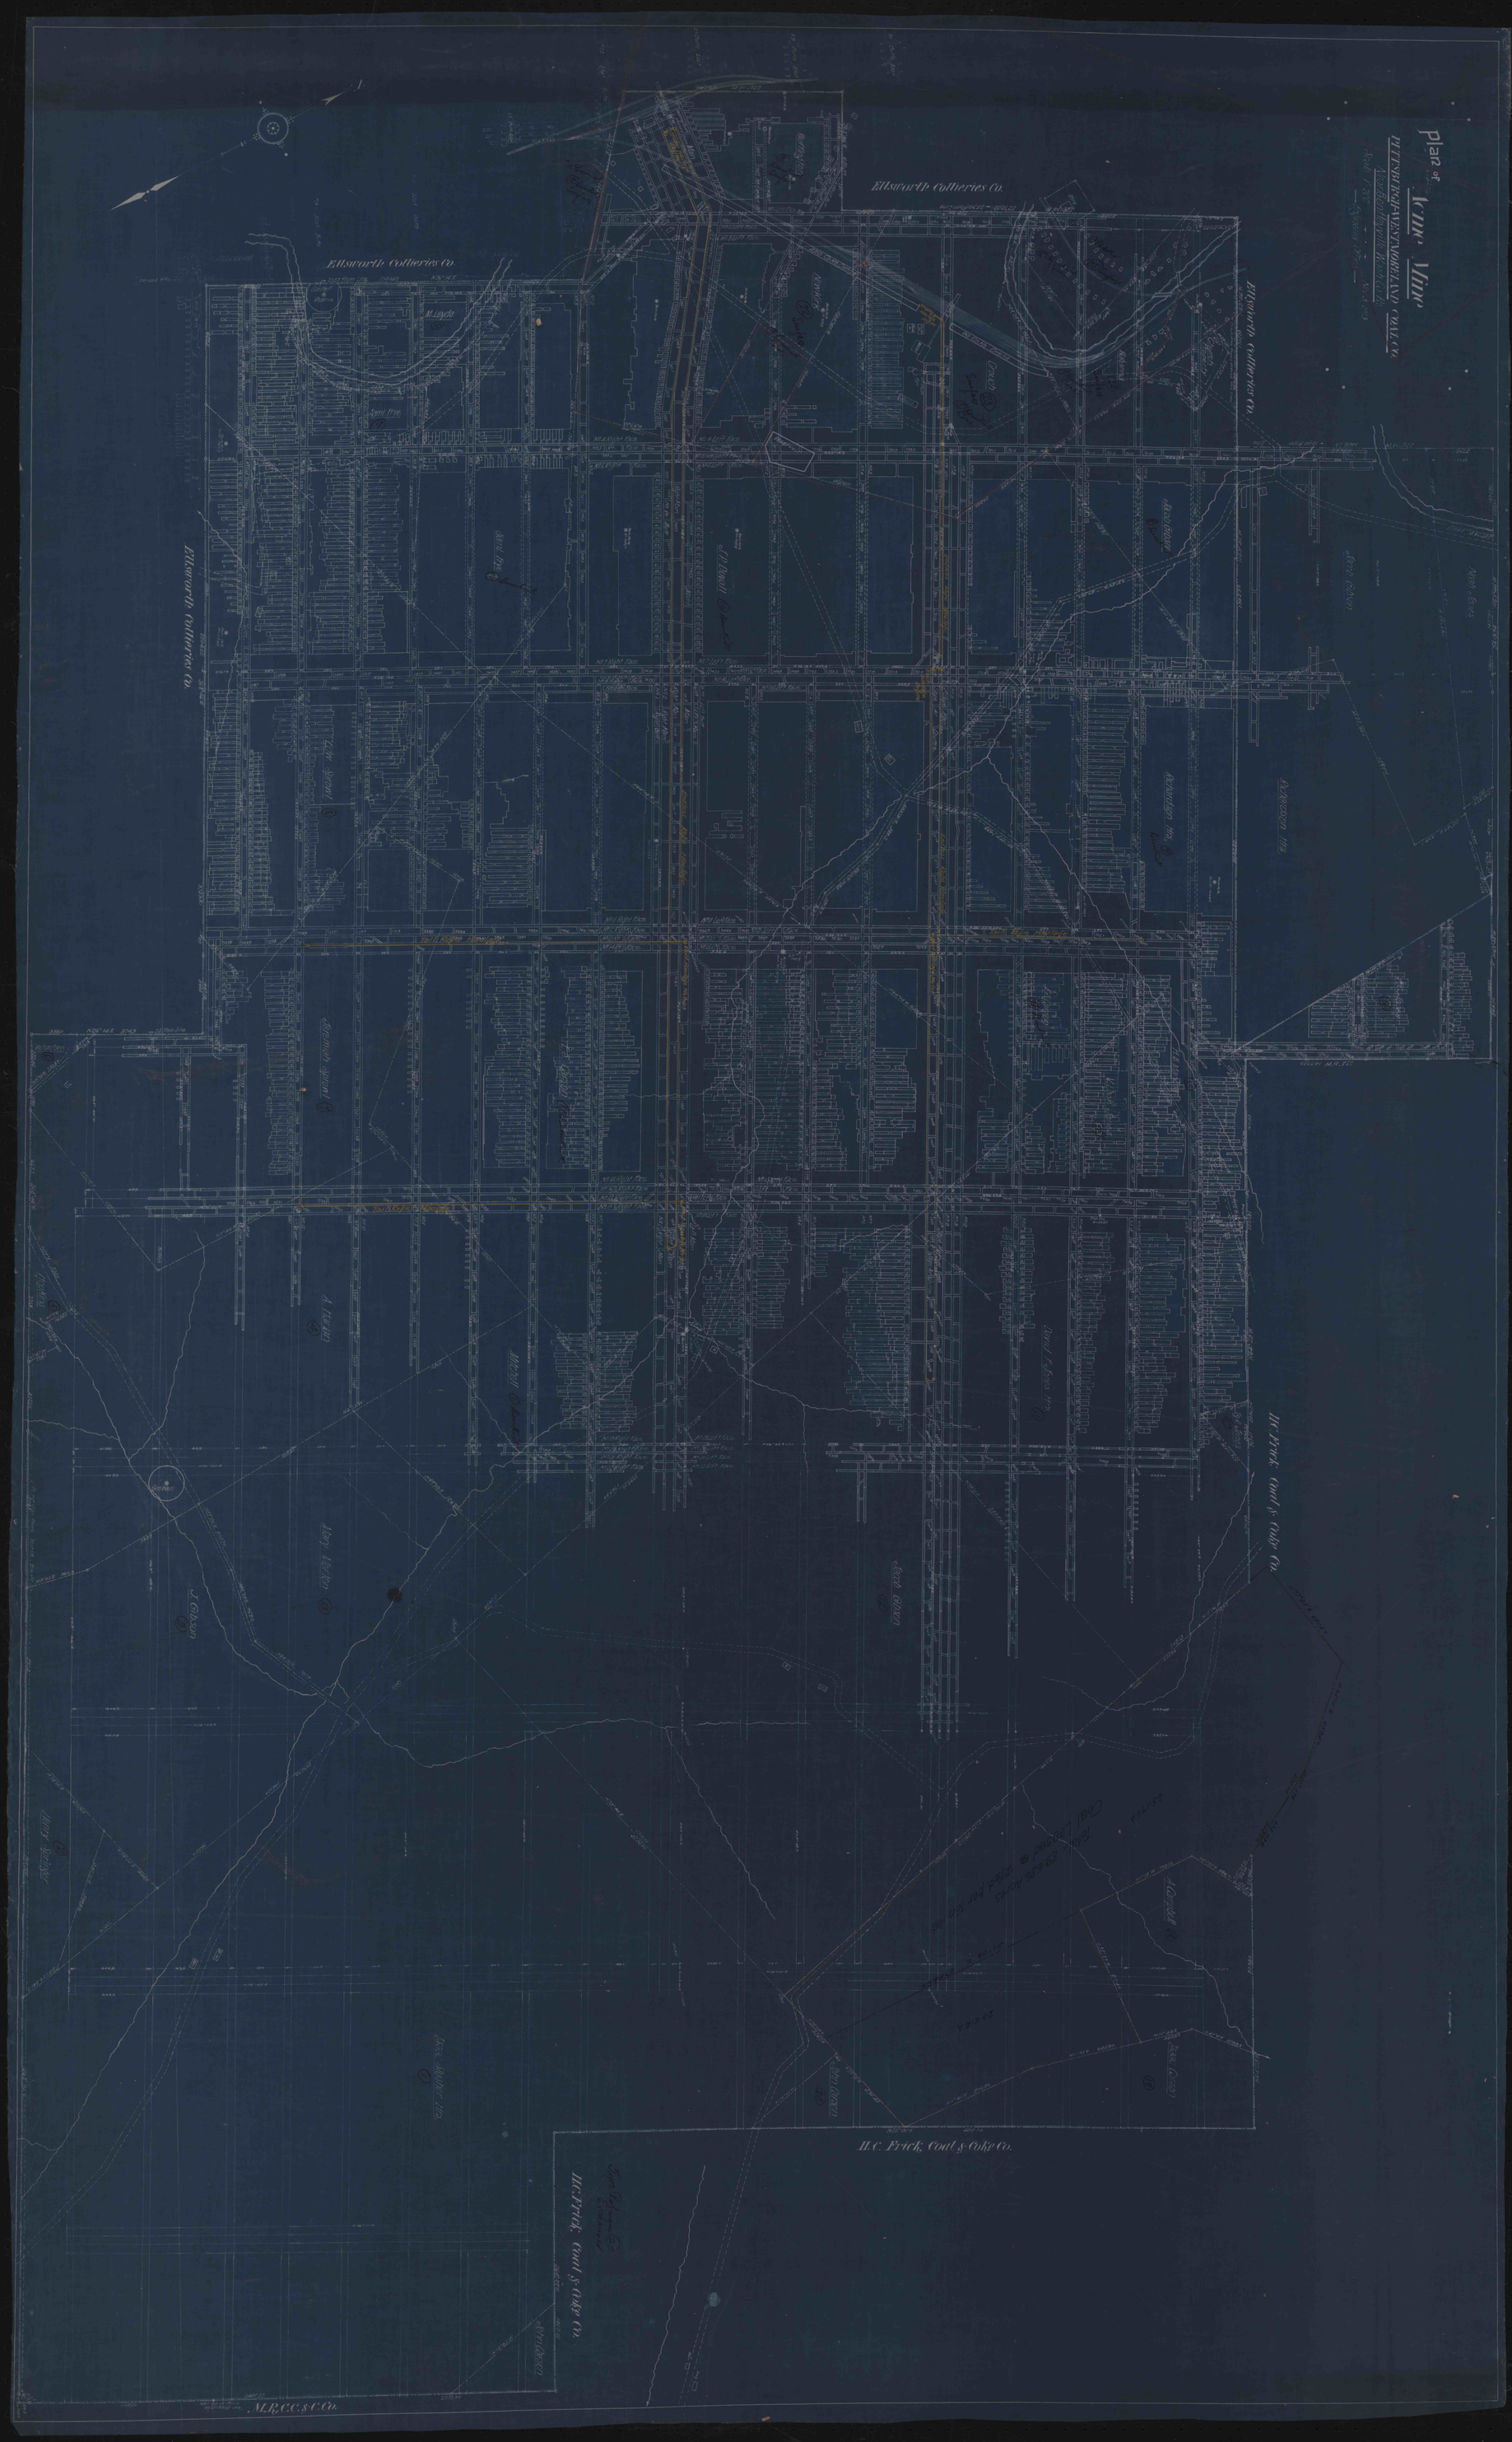
Plan of Mine
PITTSBURGH-WESTMORELAND COAL Co.
Ellsworth Collieries Co.
Ellsworth Collieries Co.
Ellsworth Collieries Co.
Ellsworth Collieries Co.
H.C. Frick Coal & Coke Co.
H.C. Frick Coal & Coke Co.
H.C. Frick Coal & Coke Co.
M.R.C.C.S.Co.