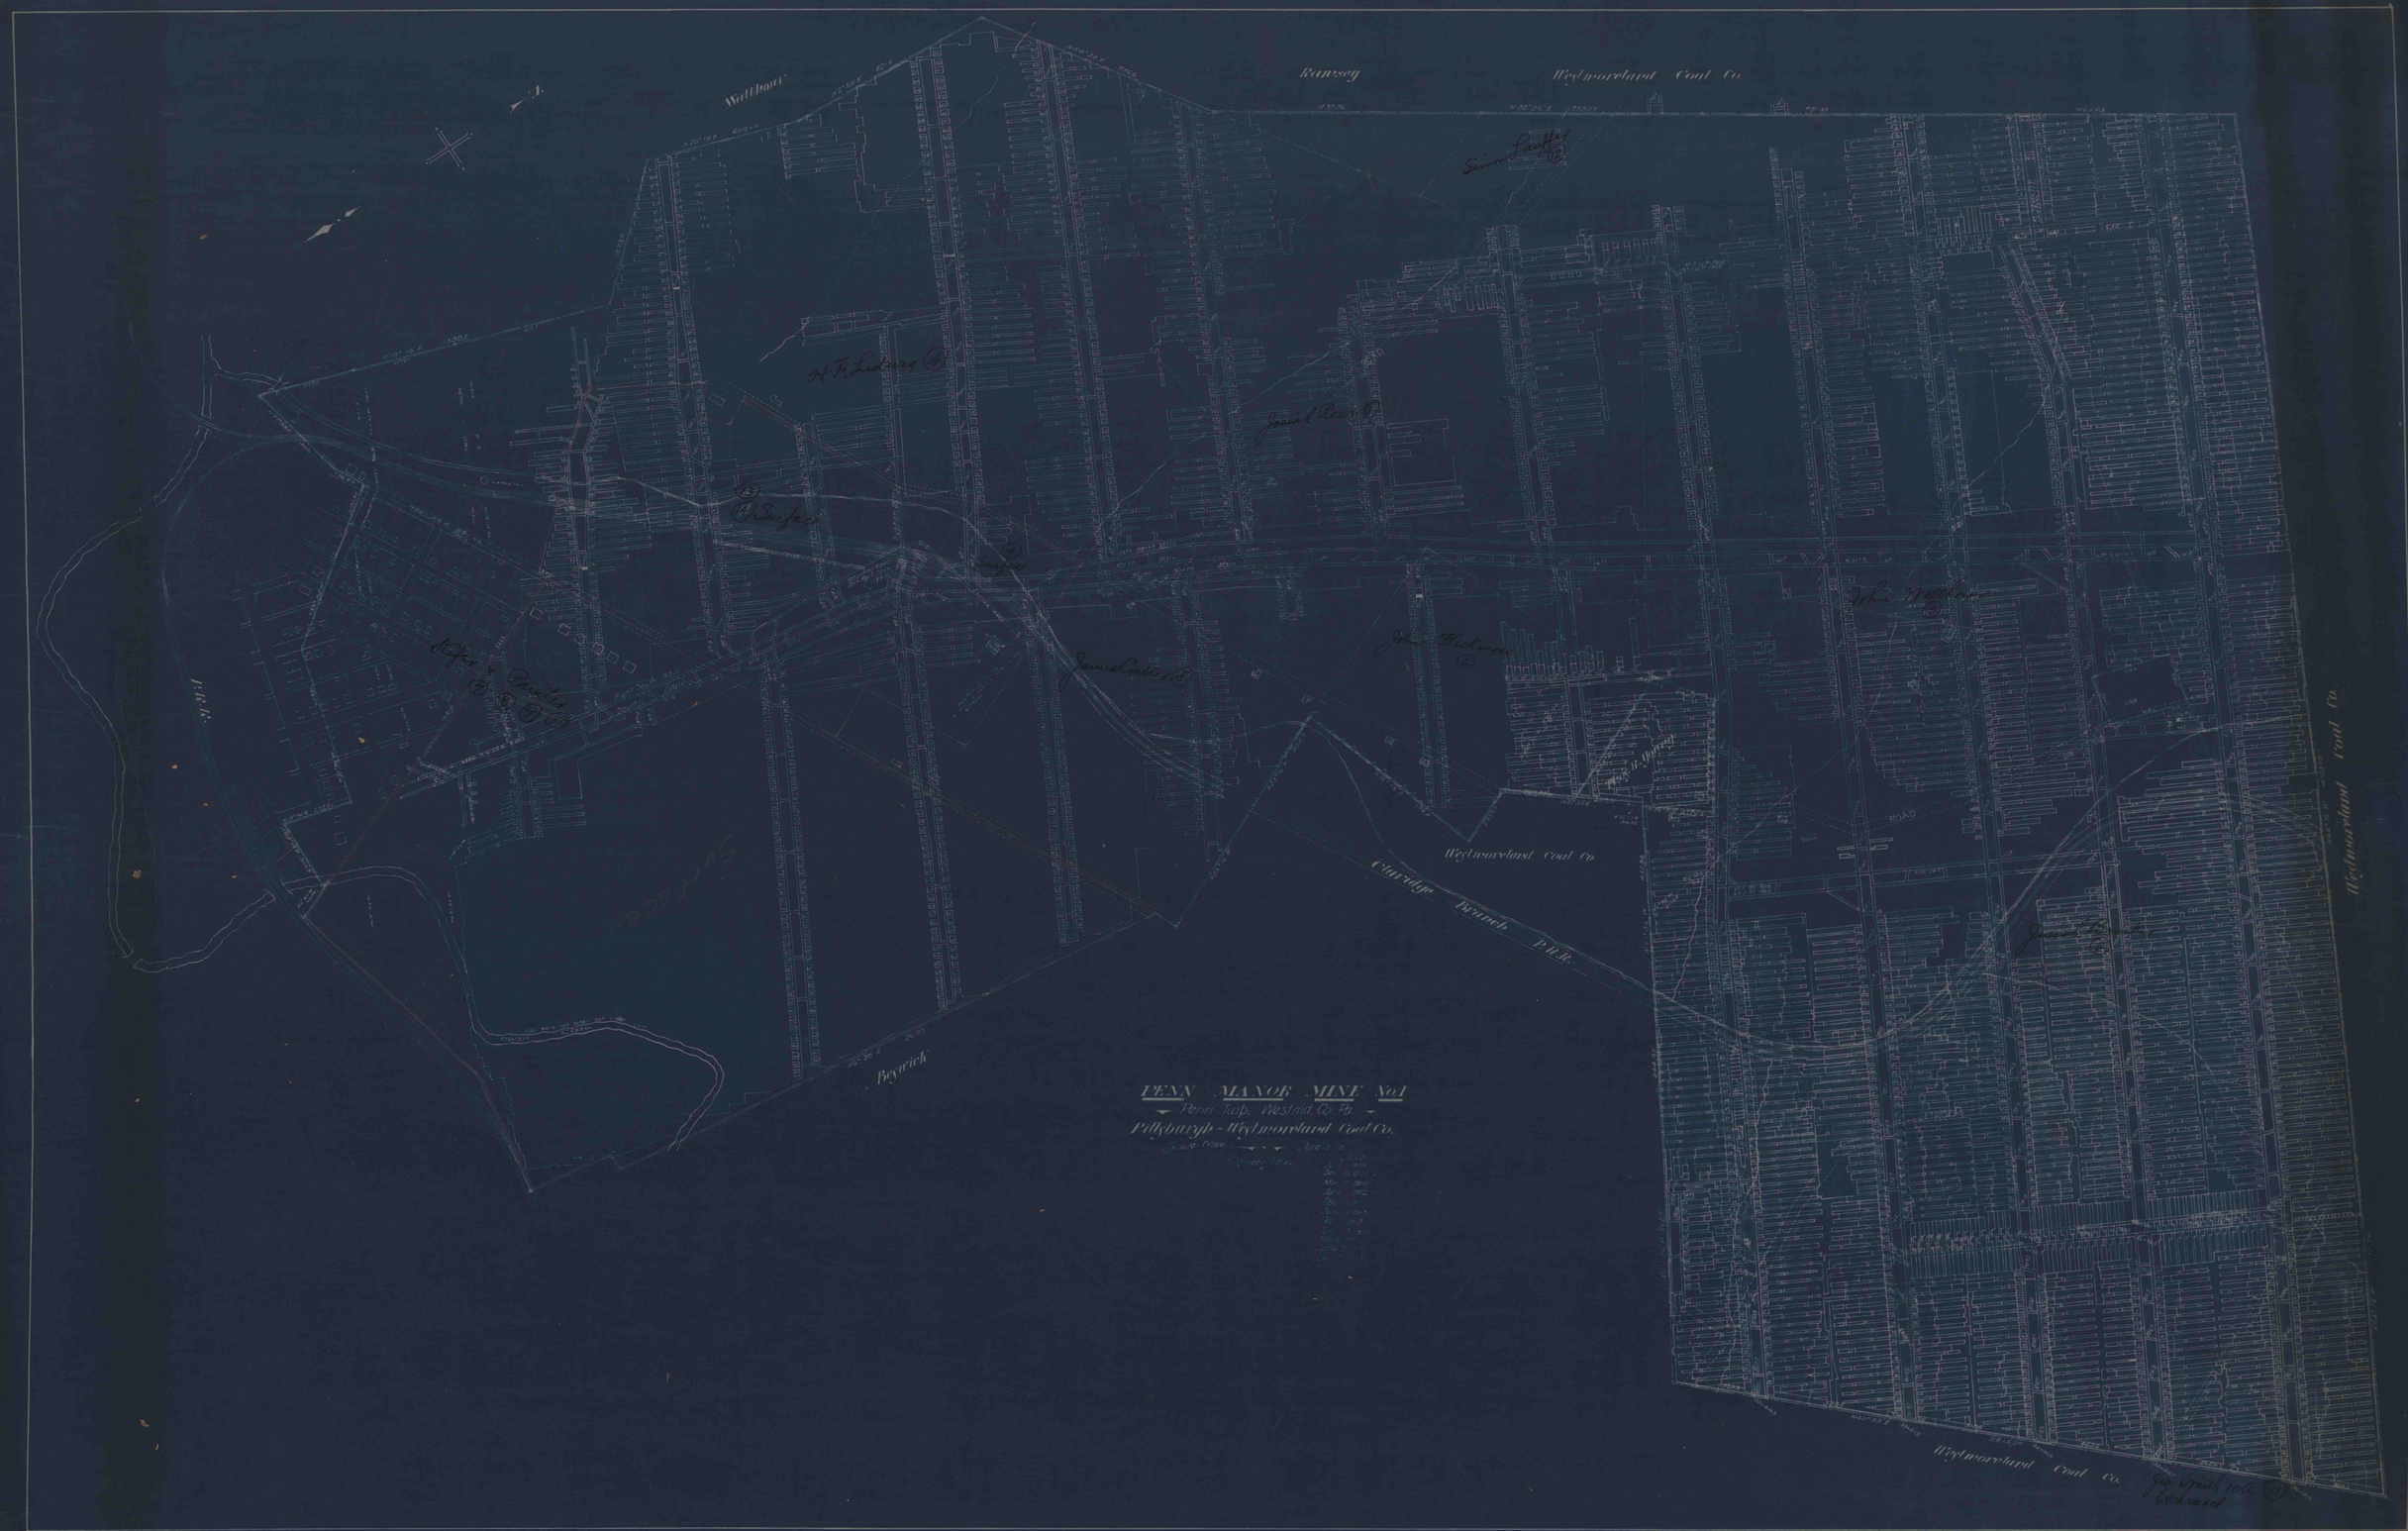
Wallbank
Ramsey
Westmoreland Coal Co.
Westmoreland Coal Co.
Clarridge Branch P.R.R.
Beyrich
Westmoreland Coal Co.
Westmoreland Coal Co.
PENN MANOR MINE No 1
Penn Twp. Westmd. Co. Pa.
Pittsburgh - Westmoreland Coal Co.