


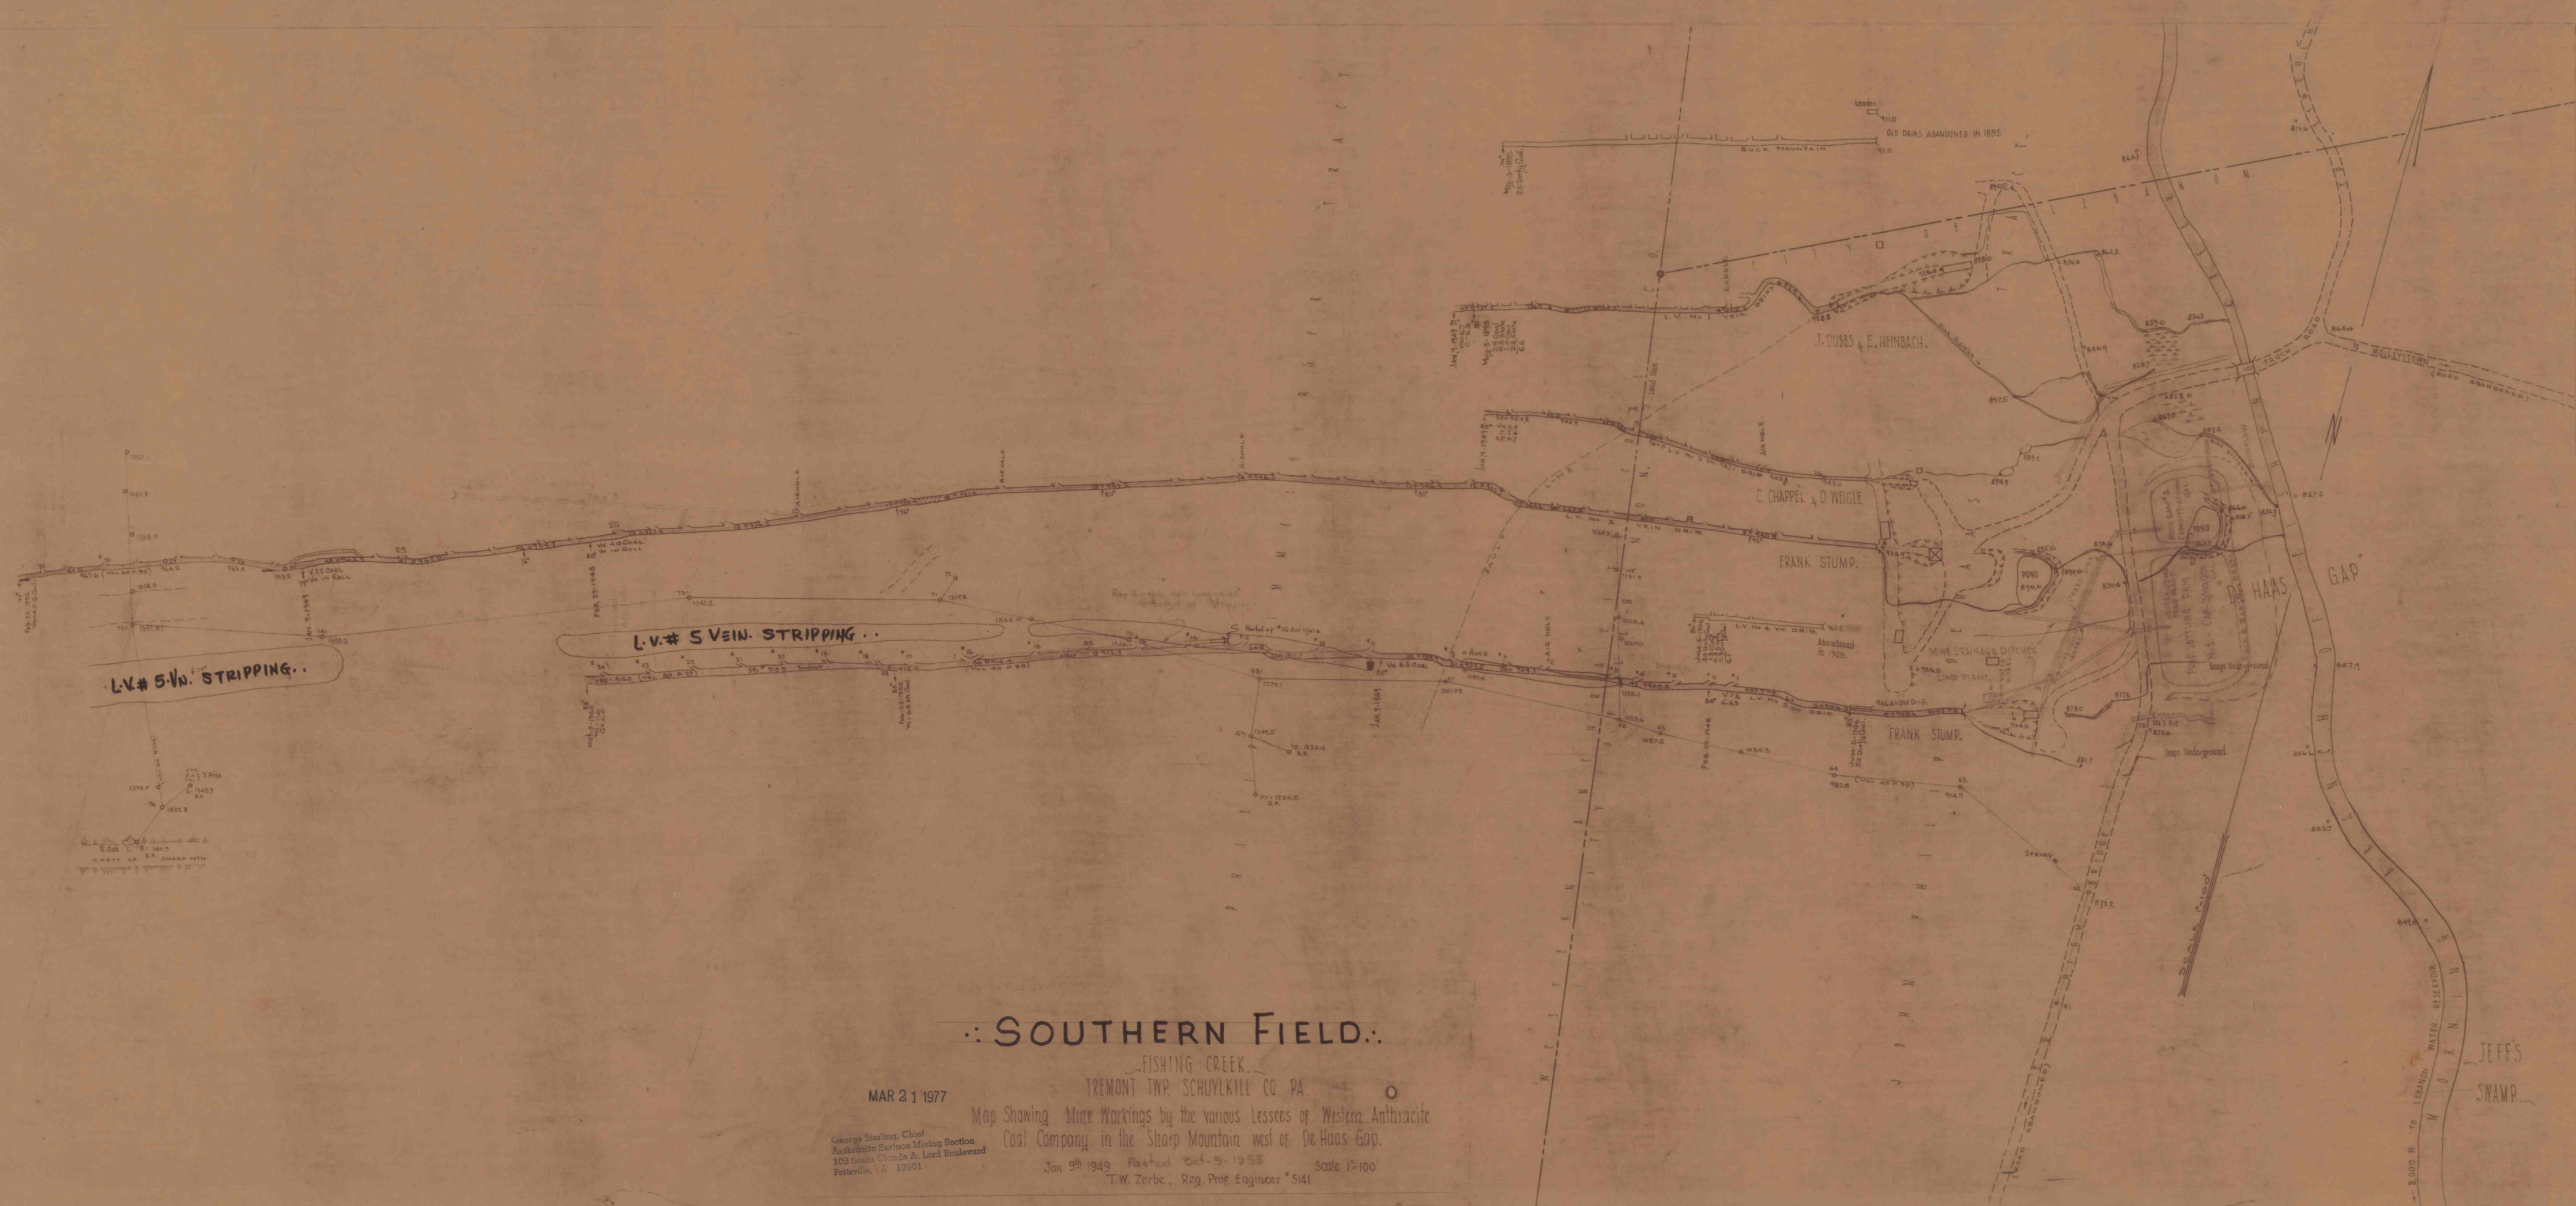

Southern field workings
by various lessees of
Western Anthracite Coal
Company in the Sharp
Mountain west of De Haas
Gap, Fishing Creek,
Tremont Twp., Schuylkill
Co., Pa.
Map by T.W. Zerbe
Jan. 9, 1949
Engineer
No. 541