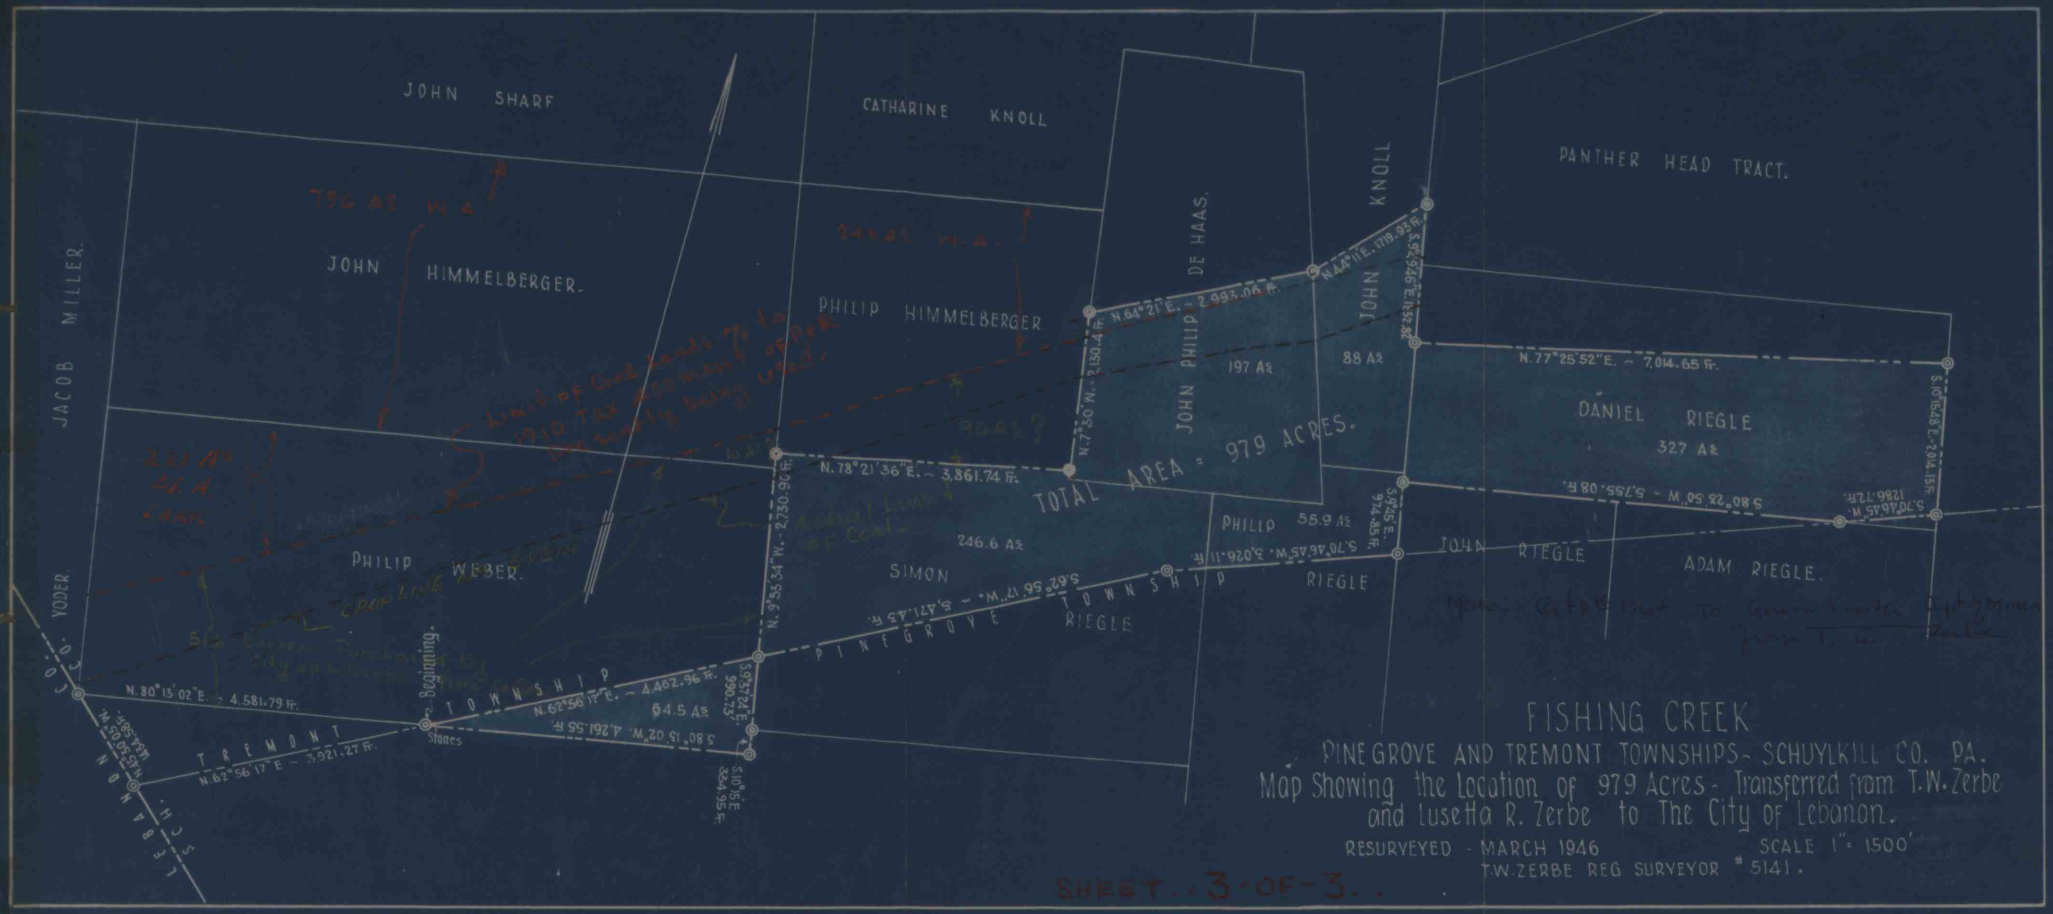
JOHN SHARF
CATHARINE KNOLL
PANTHER HEAD TRACT.
JACOB MILLER.
JOHN HIMMELBERGER.
PHILIP HIMMELBERGER
DE HAAS.
JOHN KNOLL
JOHN PHILIP
197 Ac
88 Ac
N.77°25'52"E. - 7,014.65 Ft.
DANIEL RIEGLE
327 Ac
S.80°23'50"W. - 5,755.08 Ft.
S.10°16'48"E. - 2,104.15 Ft.
S.70°16'45"W. 1286.72 Ft.
N.64°21'E. - 2,993.06 Ft.
N.44°11'E. 1719.95 Ft.
S.26°46'E. N.38°
N.7°20'W. - 2,130.4 Ft.
N.78°21'36"E. - 3,861.74 Ft.
TOTAL AREA = 979 ACRES.
PHILIP WEBER.
246.6 Ac
SIMON
PHILIP
55.9 Ac
RIEGLE
JOHN RIEGLE
ADAM RIEGLE.
S.70°16'45"W. 5,076.11 Ft.
S.62°56'17"W. - 5,471.45 Ft.
N.9°55'34"W. 2,730.96 Ft.
PINEGROVE TOWNSHIP
TREMONT TOWNSHIP
N.62°56'17"E. - 4,462.96 Ft.
S.80°15'02"W. 4,261.55 Ft.
64.5 Ac
S.10°16'E. 2,990.73
S.10°16'E. 2,634.95 Ft.
N.30°13'02"E. - 4,581.79 Ft.
N.62°56'17"E - 3,921.27 Ft.
Beginning.
Stones
JACOB YODER
FISHING CREEK
PINE GROVE AND TREMONT TOWNSHIPS - SCHUYLKILL CO. PA.
Map Showing the Location of 979 Acres - Transferred from T.W. Zerbe and Lusetta R. Zerbe to The City of Lebanon.
RESURVEYED - MARCH 1946
SCALE 1" = 1500'
T.W. ZERBE REG SURVEYOR # 5141.
SHEET - 3 - OF - 3.