


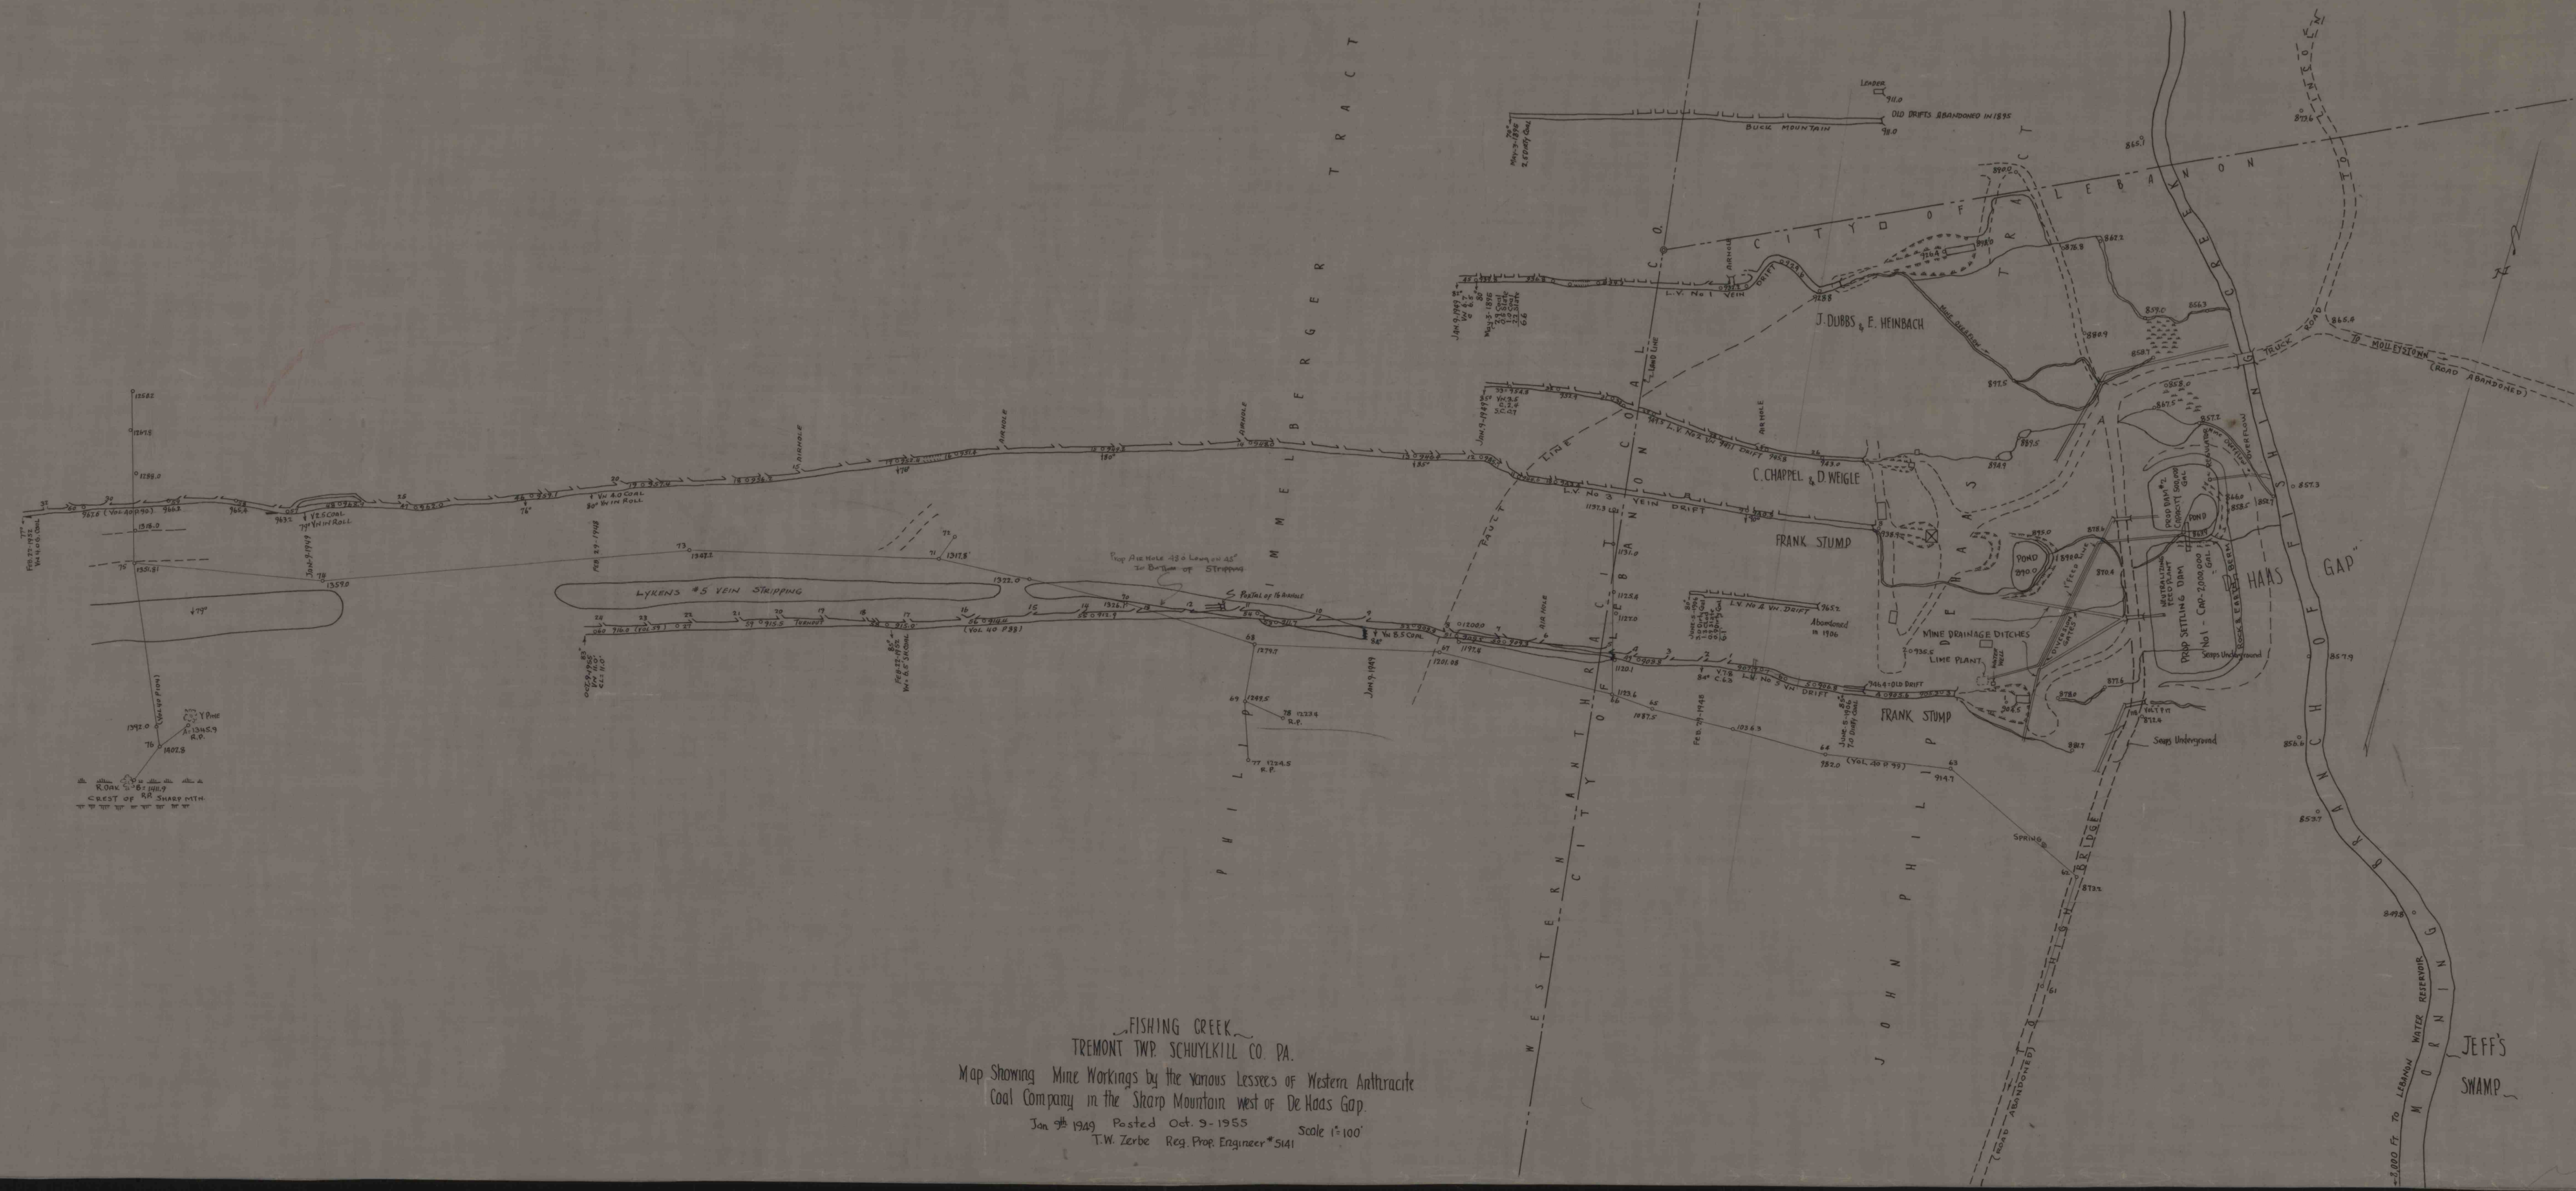

FISHING CREEK
TREMONT TWP. SCHUYLKILL CO. PA.
Map Showing Mine Workings by the various Lessees of Western Anthracite
Coal Company in the Sharp Mountain west of De Haas Gap.
Jan 9th 1949 Posted Oct. 9-1955 Scale 1"=100'
T.W. Zerbe Reg. Prof. Engineer #5141

Fishing Creek
Tracing
1949