


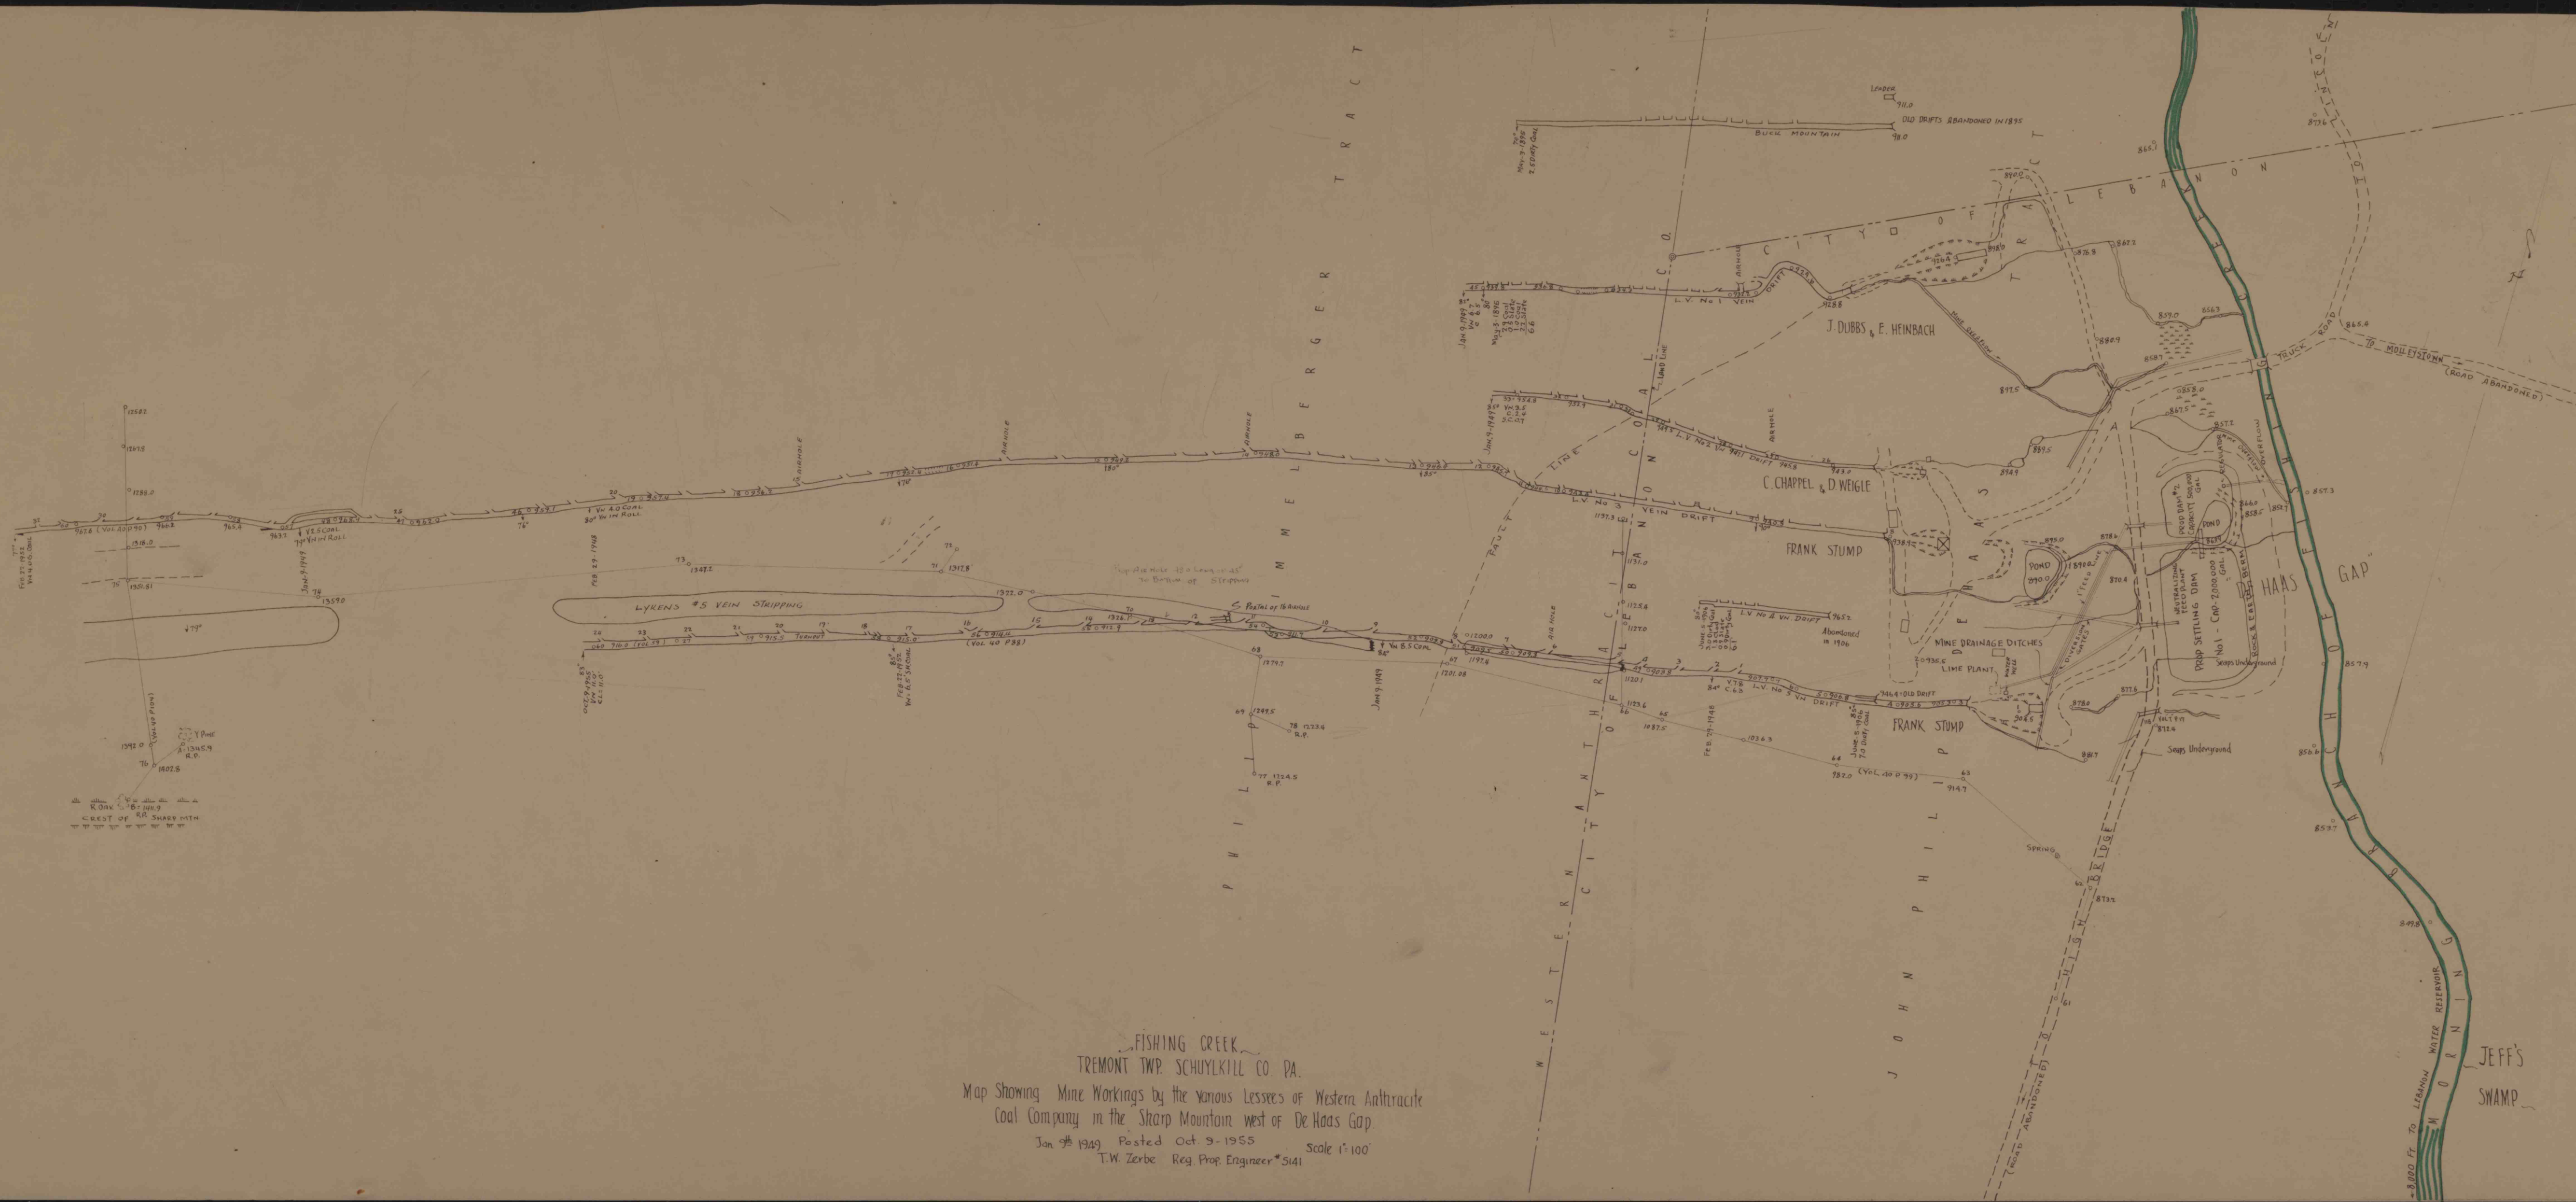

FISHING CREEK  
 TREMONT TWP. SCHUYLKILL CO. PA.  
 Map Showing Mine Workings by the various Lessees of Western Anthracite  
 Coal Company in the Sharp Mountain west of De Haas Gap.  
 Jan 9th 1949 Posted Oct 9-1955 Scale 1"=100'  
 T.W. Zerbe Reg. Prop. Engineer #5141