


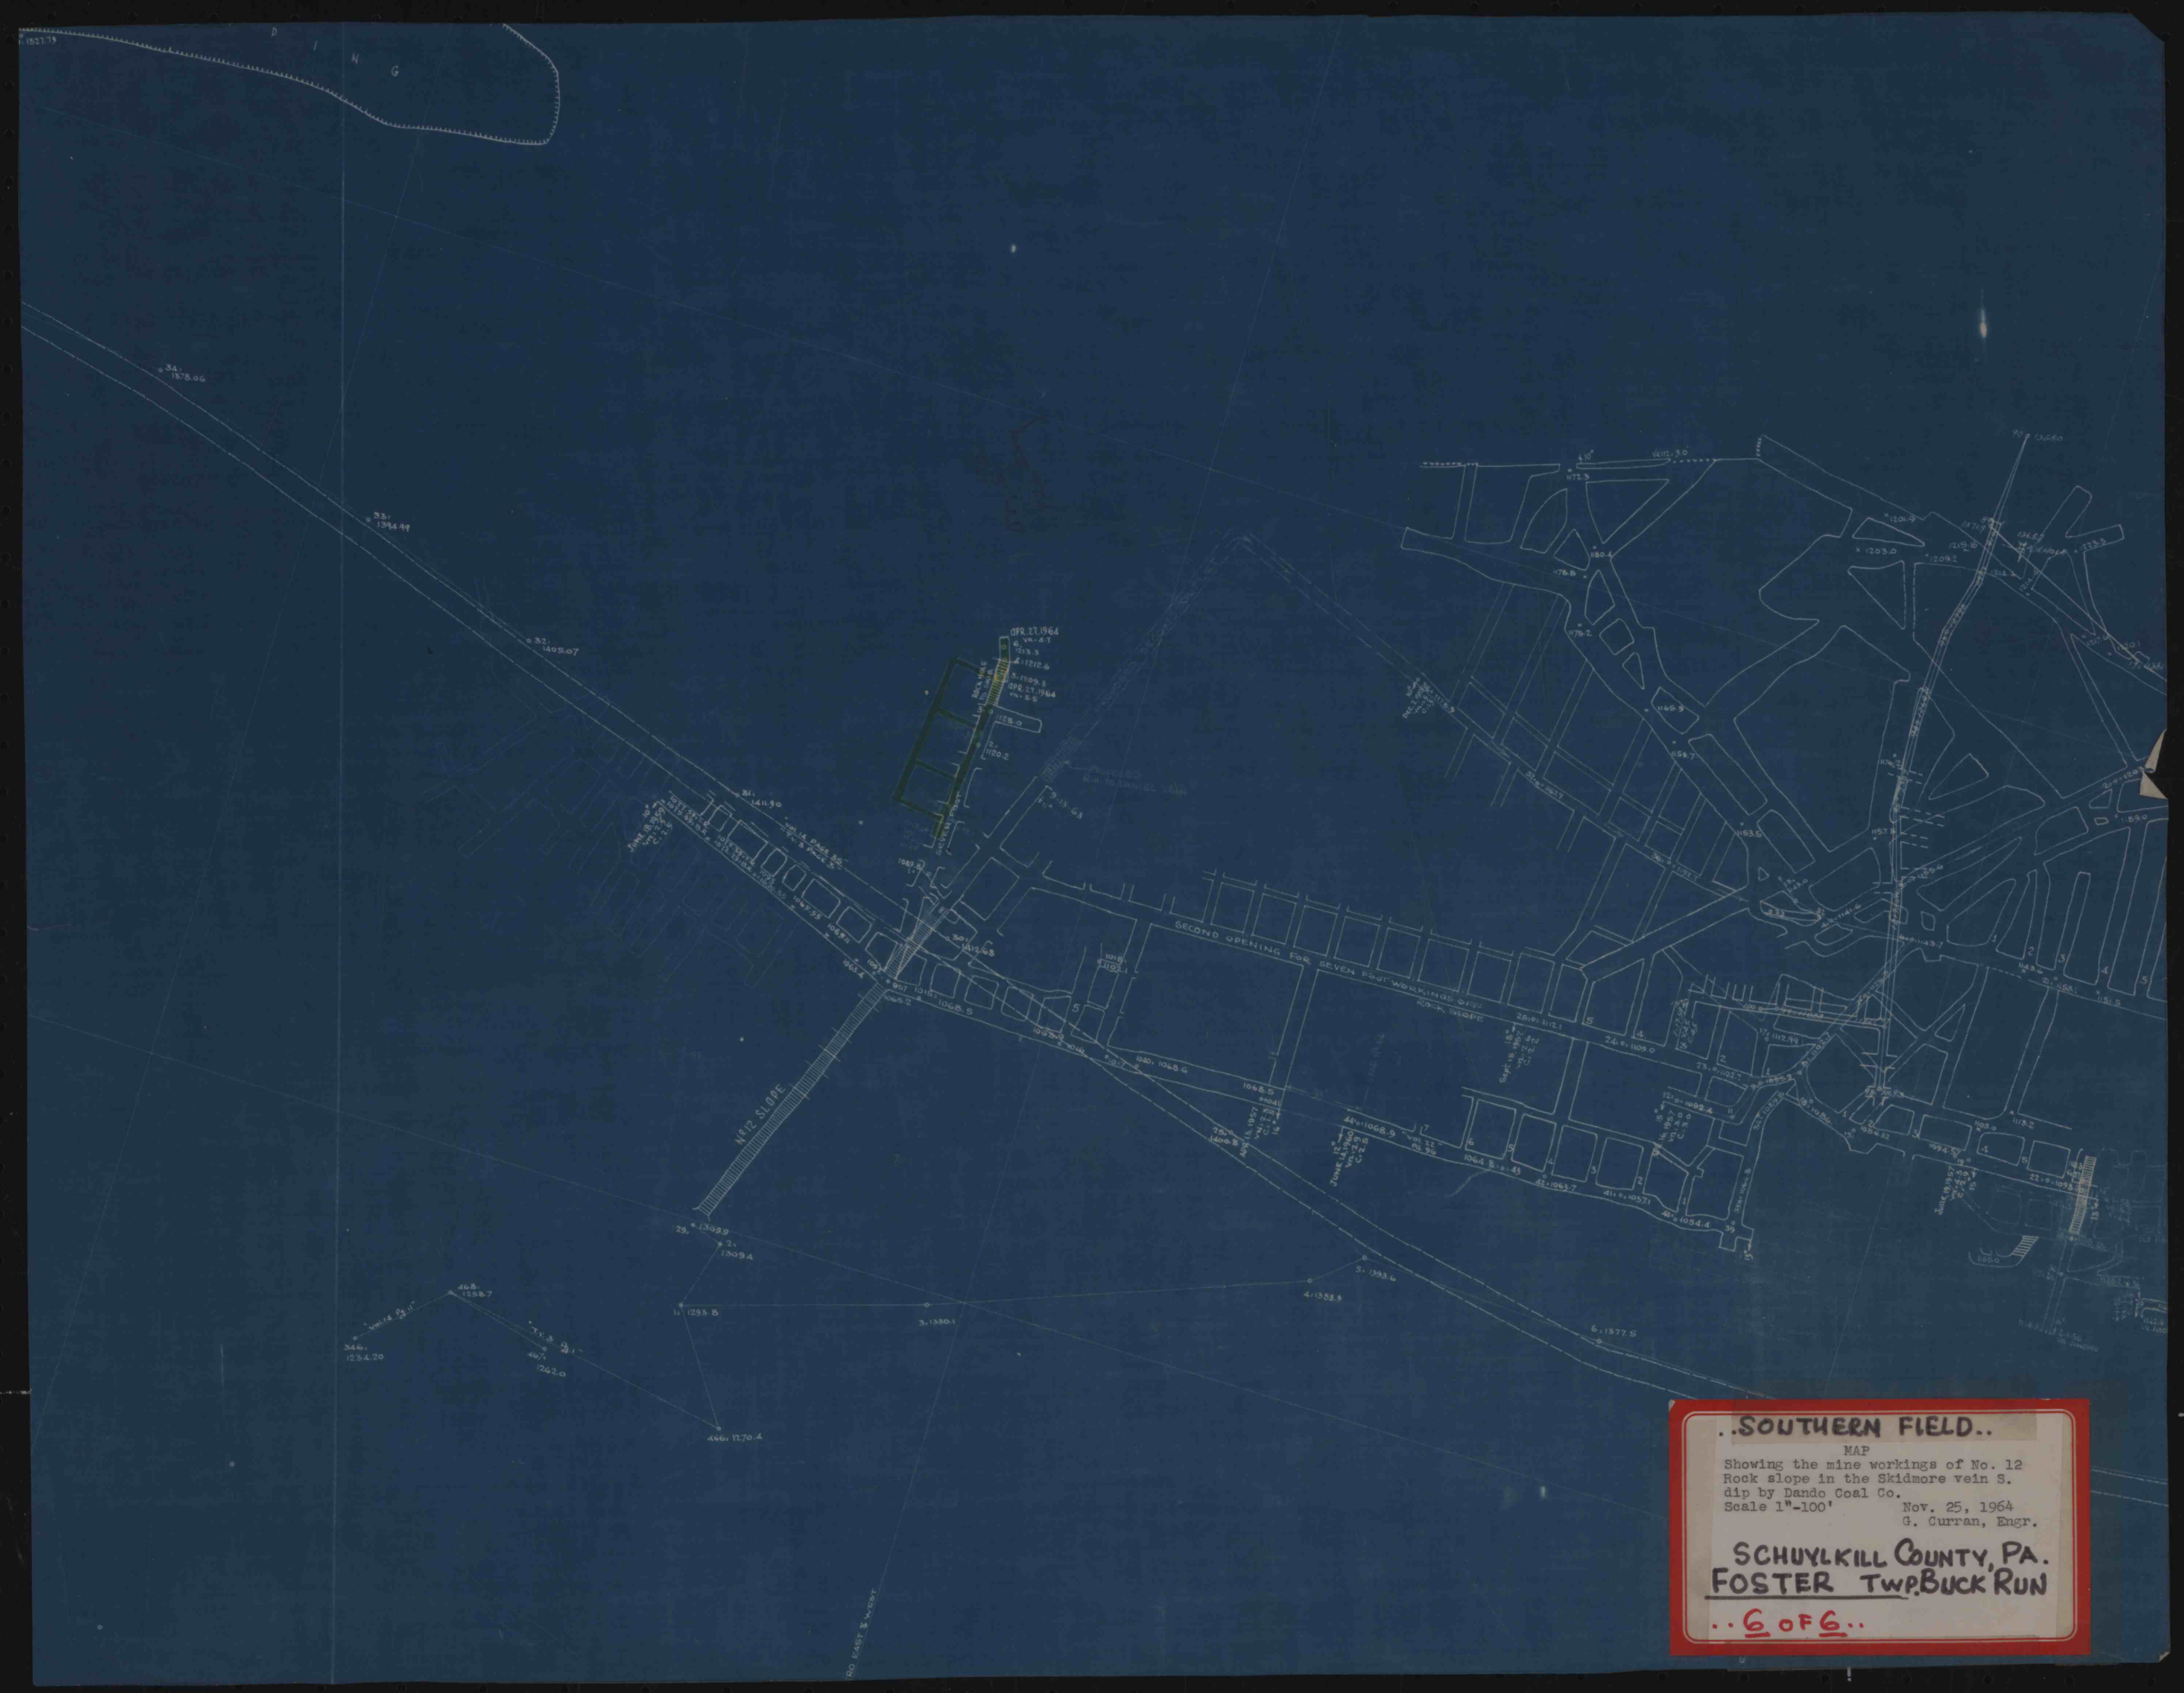

..SOUTHERN FIELD..

MAP
Showing the mine workings of No. 12
Rock slope in the Skidmore vein S.
dip by Dando Coal Co.
Scale 1"=100'

Nov. 25, 1964
G. Curran, Engr.

**SCHUYLKILL COUNTY, PA.
FOSTER TWP. BUCK RUN**