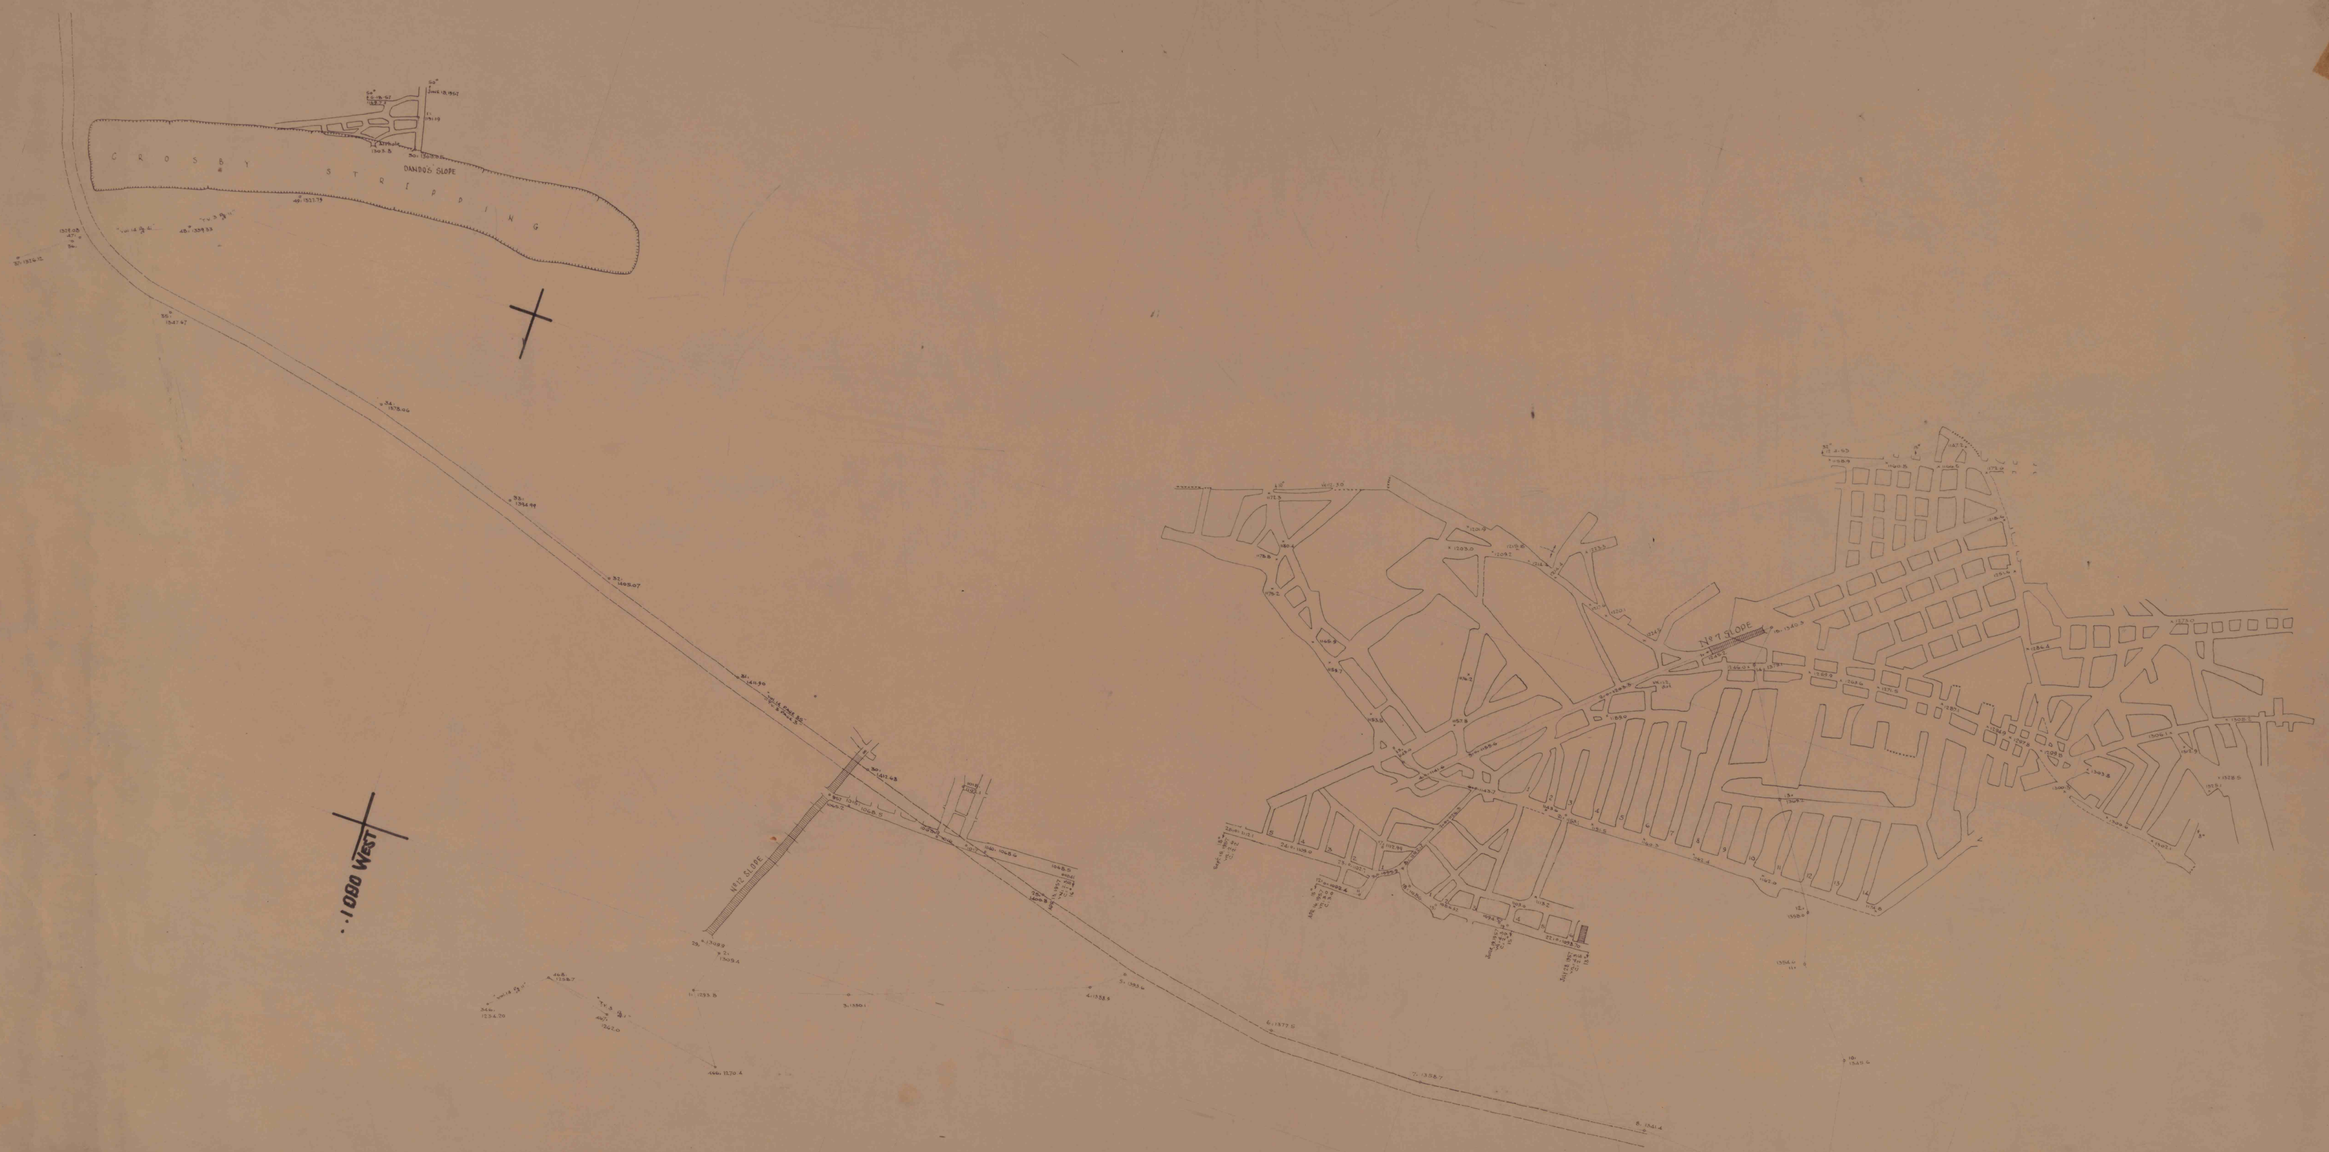

SOUTHERN COAL FIELD · JAMES DANDO..
· WORKINGS.. 1" = 100' · SCHUYLKILL COUNTY,
MINERSVILLE, PA. #7-SLOPE-OCT. 27, 1957

Mine Workings
James Dando
Scale 1" = 100' 10-21-57

..2 OF 6..