


COMMONWEALTH OF PENNSYLVANIA
DEPARTMENT OF MINES &
MINERAL INDUSTRIES

ANTHRACITE MAP
OF THE
MIDDLE AND SOUTHERN FIELDS
OUTLINING THE
MINE INSPECTION DISTRICTS

1 INCH = 1 MILE

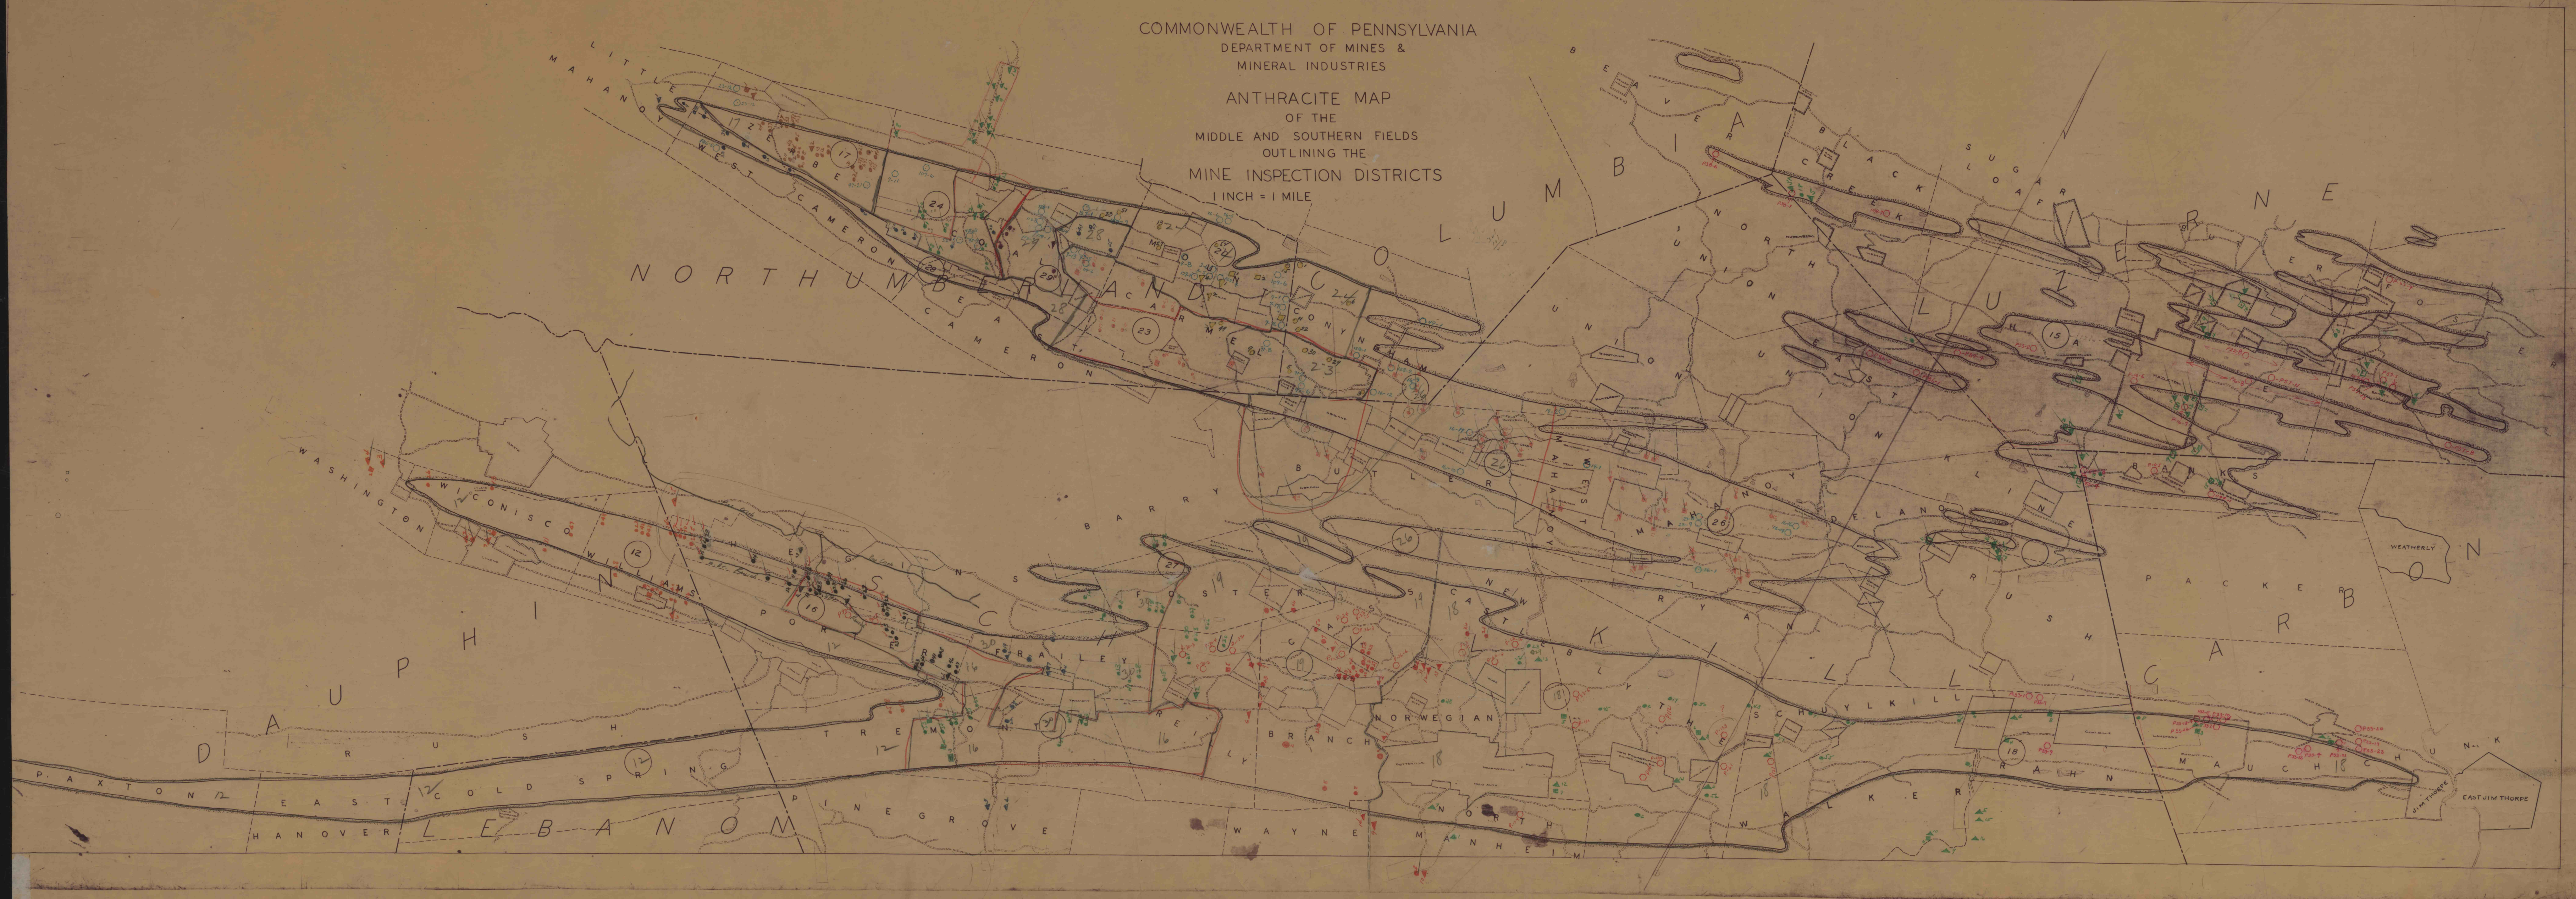

"OLD-LISTINGS"
DISTRICTS-CHANGED.

Stoppings

Mines
Bank
Branch