


North Side of Berry's Mountain.

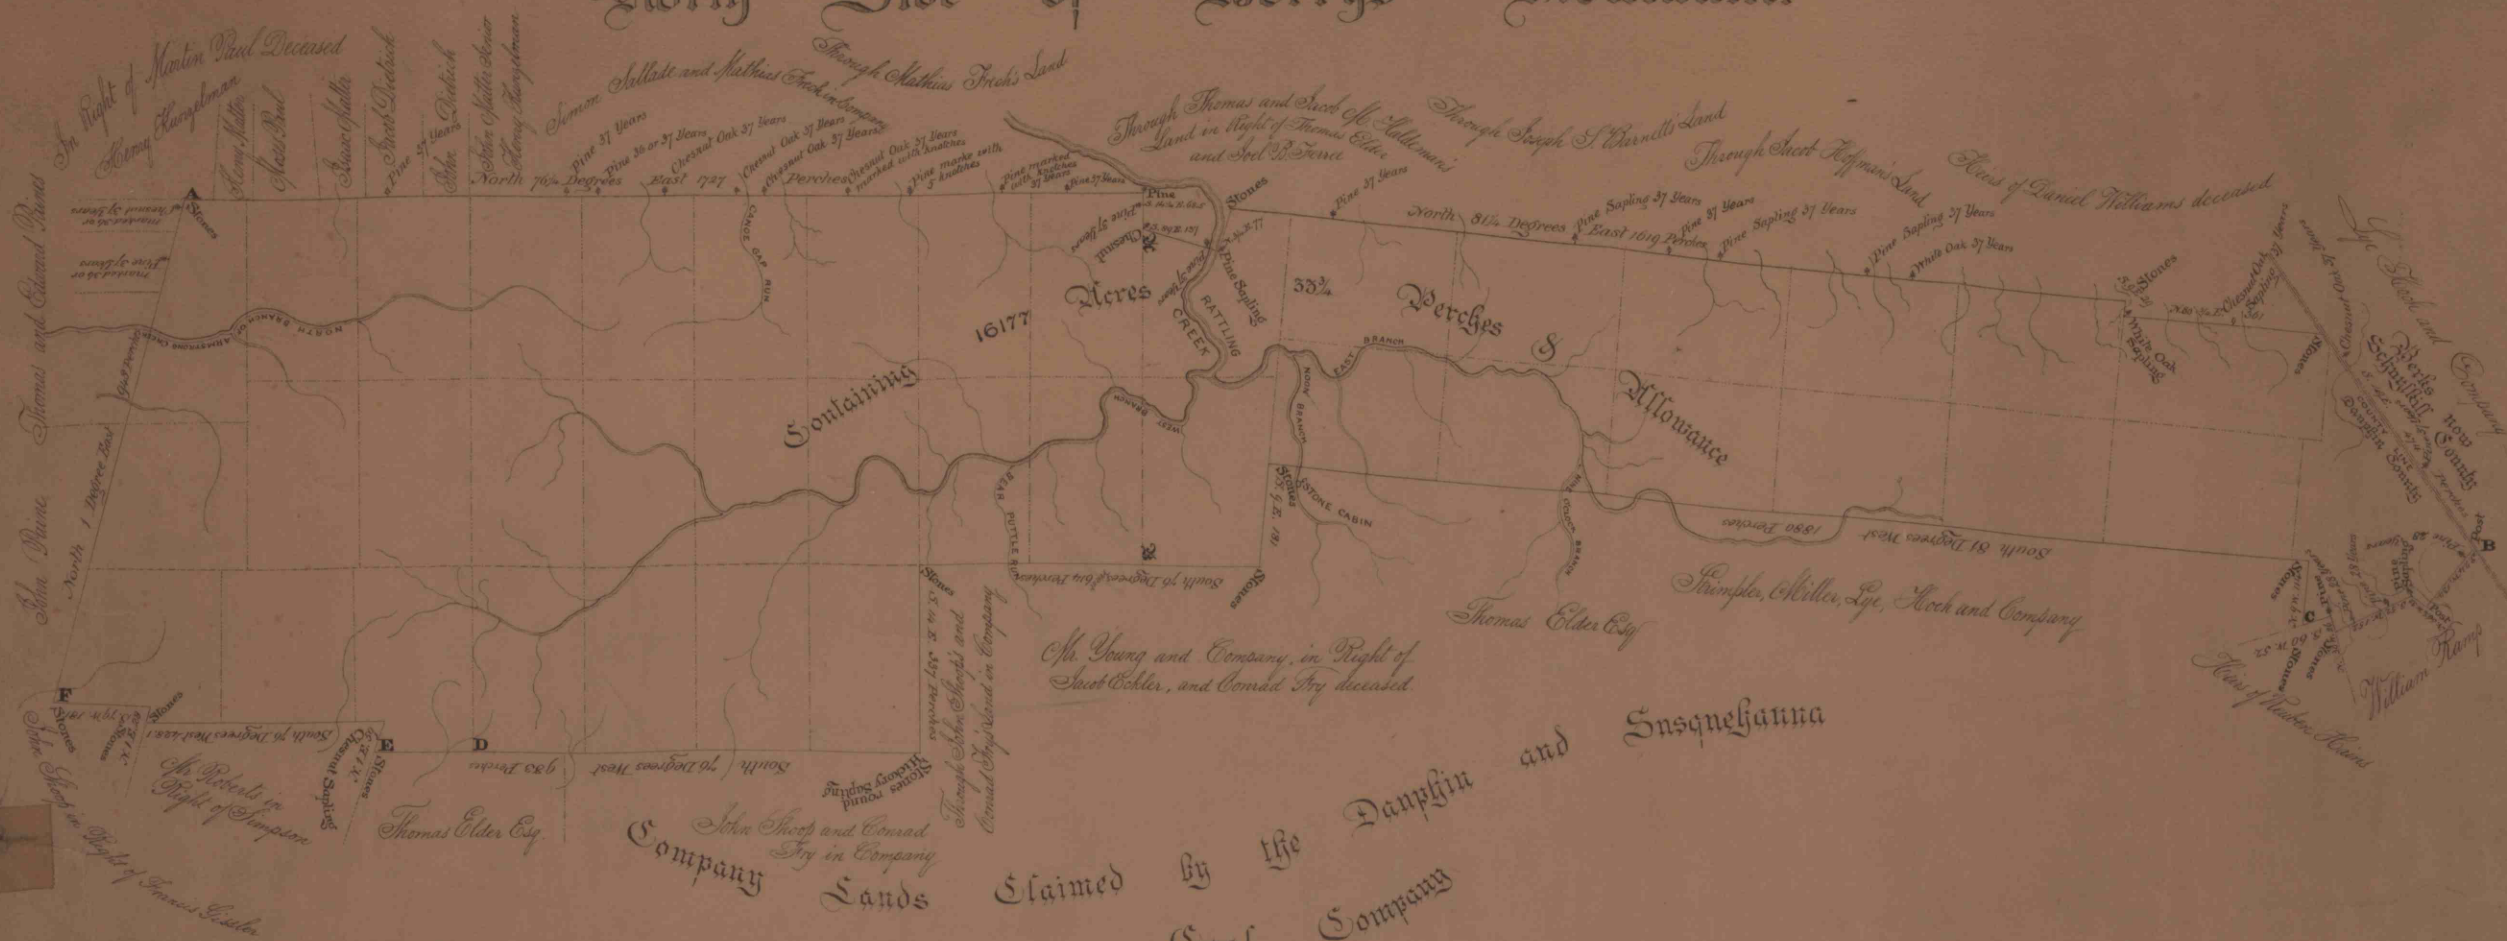

Resurveyed for the Heirs of Bartram Galbraith deceased, between the seventeenth day of June, and the twelfth day of July, Anno Domini, One Thousand Eight Hundred and Thirty One. By Virtue of an Order of the Board of Property bearing date the Twenty Fourth day of March, Anno Domini, One Thousand Eight Hundred and Thirty One; Entered in the Minute Book Number Nine, Page Two Hundred and Fifty; By the Petition of Jane Elder, of the Borough of Harrisburg Widow, Samuel Morris in Right of his Wife Sarah, formerly Sarah Galbraith, of Harrisburg aforesaid, and Henry Carpenter in Right of his Wife Mary Ann, formerly Mary Ann Cook of the City of Lancaster, in behalf of themselves, and the other Heirs of the said Bartram Galbraith, formerly of Lancaster County deceased; the Tracts of Land in the above Diagram, Situate in Millers, Lanes, Jackson, and Rush Townships, in the County of Dauphin and Commonwealth of Pennsylvania: Containing Sixteen Thousand One Hundred Seventy Seven Acres Thirty Three Perches and three Quarters of a Perch, and the Usual Allowance of six hundred for Road and so forth, On Forty Warrants bearing date the Twenty Ninth Day of January, Anno Domini, One Thousand Seven Hundred and Ninety four, in the following Names Viz John Smith, Evan Dand, James Cook, John Cook, James Egan, David Gray, Samuel Cook, John Field, John Elder, David Elder, John DeFrance, Frederick Bower, Anthony Hains, John Hains, Frederick Stamp, Jacob Whisman, Robert Ballance, John Taylor, Samuel Taylor, Thomas Spencer, John Wetch, John Lytle, William Johnston, John Field, Sim Chambers, Samuel Bross, Alexander Roags, Andrew Bross, and Abraham Scott.

Reference From the letter A. on the North West Corner of the above Diagram to letter B. on the County Line, on the South East Corner of the above Diagram being a Regular Line found on the Ground, and marked as the above Diagram will show, by the marked Trees which I Block, and a Number more found on the Line, I have counted the Growths, and found them to be Thirty Seven Including this Year's Growth, makes the Survey to be made Thirty Six Years Ago. From the Letter B. aforesaid, to the Letter in the above Diagram C. on the Southern Corner, a Line on the Ground, the first three Lines, from the Letter B. aforesaid, the Growths Count twenty eight Including this Year's Growth, as in the above Diagram, and the Remaining two Lines about forty eight or fifty Growths. From the Letter C. aforesaid, to the Letter D. in the above Diagram, I have found no Line on the Ground. From the Letter D. aforesaid, to the Letter E. in the above Diagram, found a Line made about five Years ago. From the Letter E. aforesaid, to the Letter F. in the above Diagram, down the End of the Mountain, thence along John Shoop's Fence and through his Field. And from the Letter aforesaid F. to aforesaid Letter A. a Regular Line on the Ground, which was Run late in the Fall or Autumn in the Year, One thousand seven hundred and ninety five, or Early in the Spring, one thousand seven hundred and ninety six, as the Diagram will show, by the marked Trees. The first Division Line on the West Side of Rattling Creek, marked with the Letters A and B was Run fifteen or sixteen Years ago, supposed to have been Run by Thomas Smith.

N.B. It is impossible at present to lay down the Interference, but I have to Remark, that part of the Land on the West End, is in Actual possession of John Shupp, Daniel Shupp, John Straw, George Shupp, Jacob Paul, and the Heirs of Richard Kelly, and on the Southeast Corner in actual Possession of Peter Brown. And the following persons Claim in the above Diagram by Titles without Possession Viz Henry Kumpelman, Henry Matter and Moses Paul, in right of Martin Paul deceased Jacob Dietrich, John Dietrich, Henry Kumpelman in Right of Jacob Dietrich, Thomas Elder, Simon Elder and Henry Schuman, Nicholas Snager, Simon Ballade, Mathias Frech, Jacob Mc Waldeman, Joseph Bonett, Christian Baddorf Young and Company in Right of Fry and Eckler, Jacob Hoffman, Lye Hock and Company, John Shoop, Conrad Fry and Company, Peter Dietrich and Company and Peter Dietrich, Son of Peter and Mathias Frech in Company.

To Jacob Spangler Esq
Surveyor General of the Commonwealth of Pennsylvania.



I hereby Certify that the foregoing is a Copy of the Draft by John Paul Juni, Deputy Surveyor for Dauphin County, ordered "Dauphin County, Heirs of Bartram Galbraith, mark B." copied from, and compared with the Original Draft remaining on file in the Department of Internal Affairs of Pennsylvania.

In Testimony whereof, I have hereunto set my hand, and caused the Seal of said Department to be affixed at Harrisburg, this Sixth day of February, A.D. 1882.

Lucius Rogers
Dep. Secy. Int. Affs.

..Southern Field..
Company Lands Claimed by the
Dauphin & Susquehanna Coal Co.,
..North Side of BERRY'S
Mountain..
6th. February 1882. A.D.
..Cloth Map..(No scale noted)..