


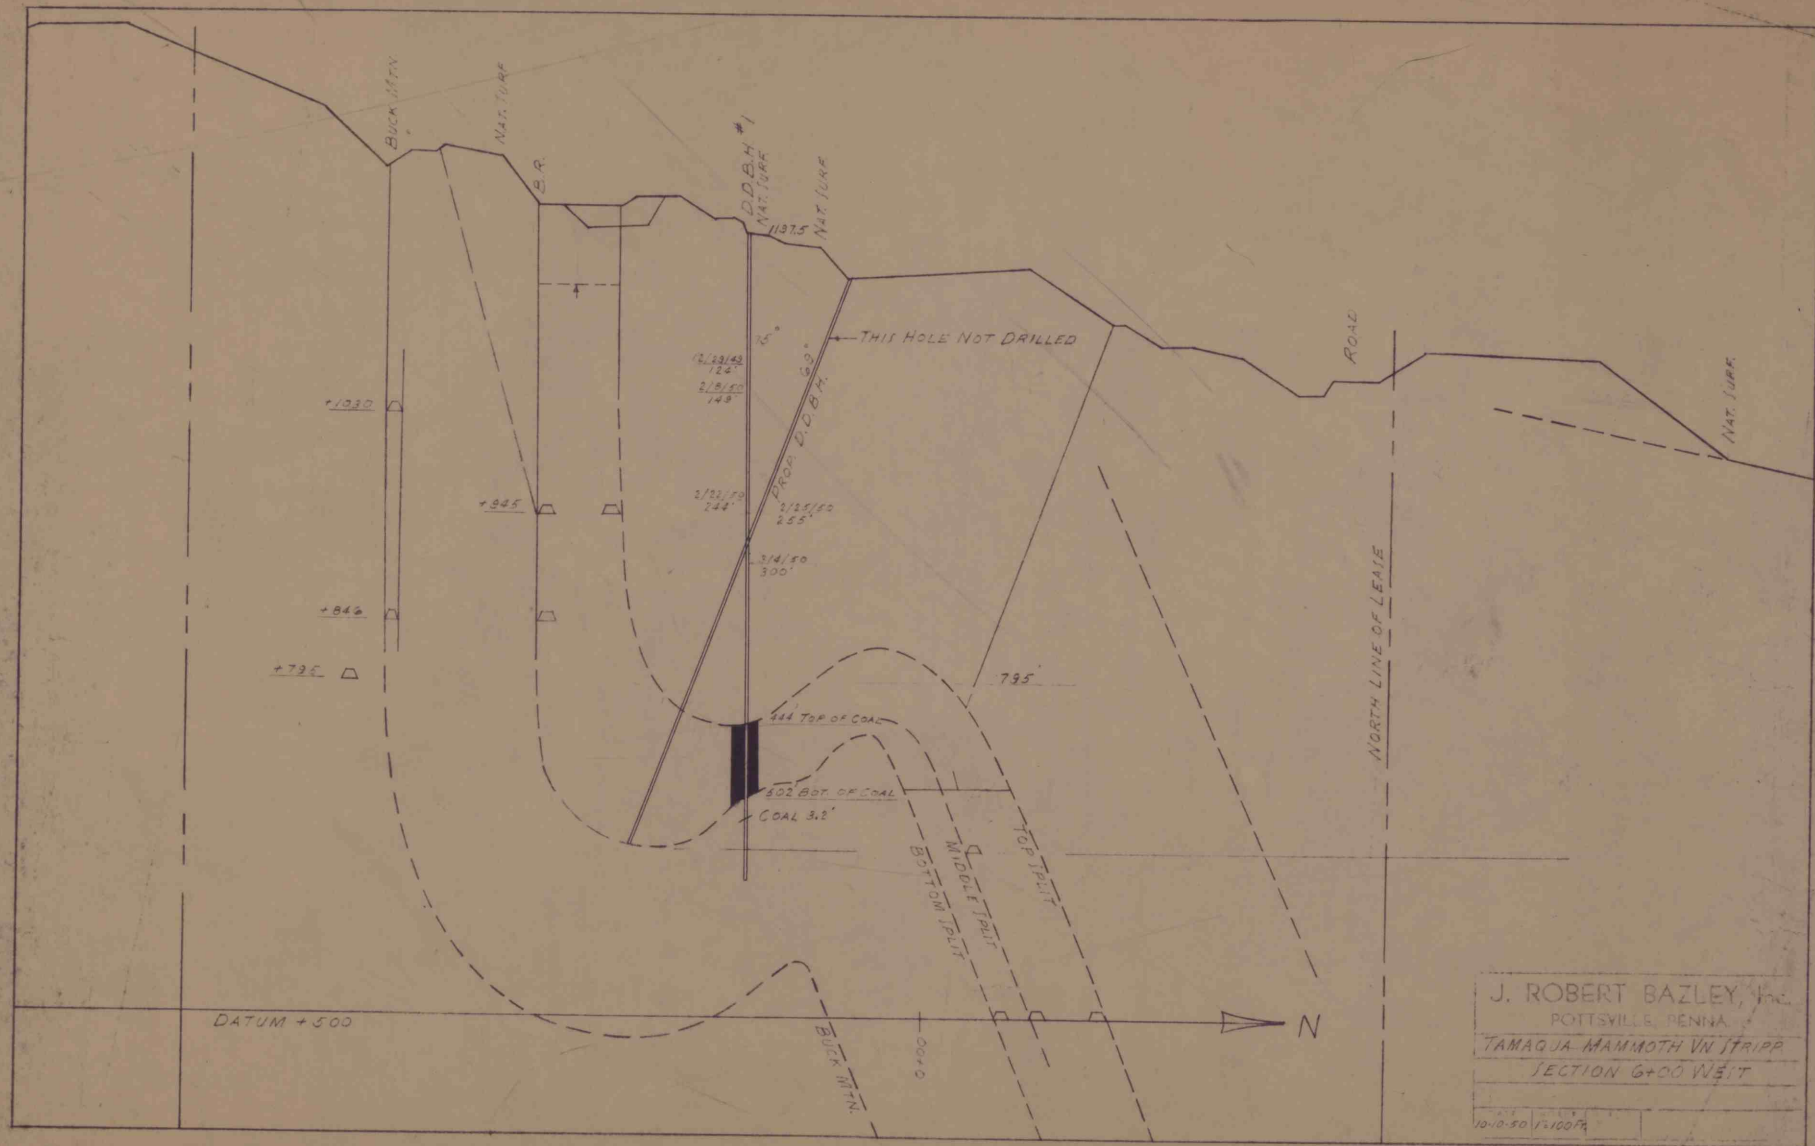

J. ROBERT BAZLEY, Inc.  
 POTTSVILLE, PENNA.  
 TAMAJA-MAMMOTH VN STRIPP  
 SECTION 6+00 WEST

10-0-50 1/100%