


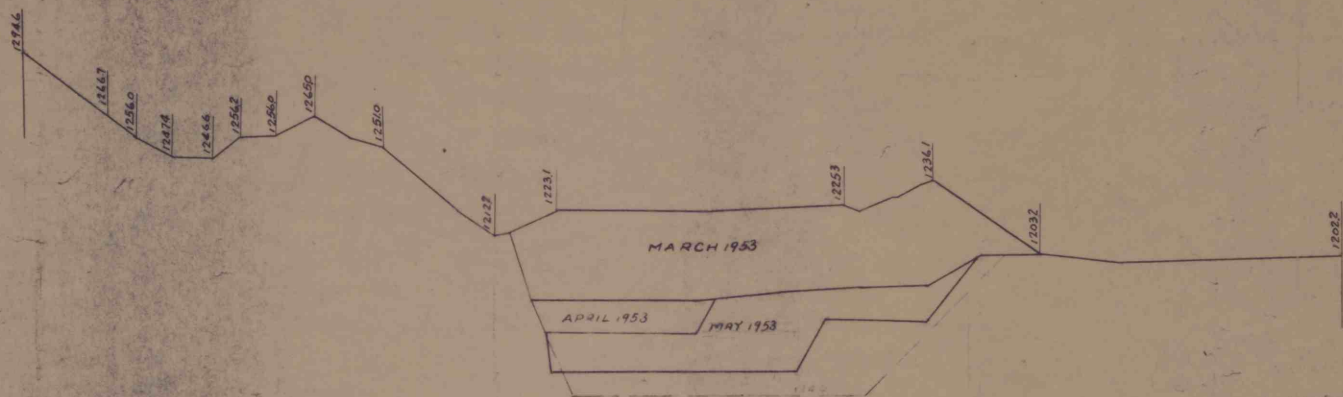

J. ROBERT BAZLEY, Inc.			
POTTSVILLE, PENNA.			
ASHTON SOUTH SIDE			
STRIPPING			
SECTION 11+00 WEST			
DATE 5-26-53	SCALE 1"=50'	BY	83.12.20