


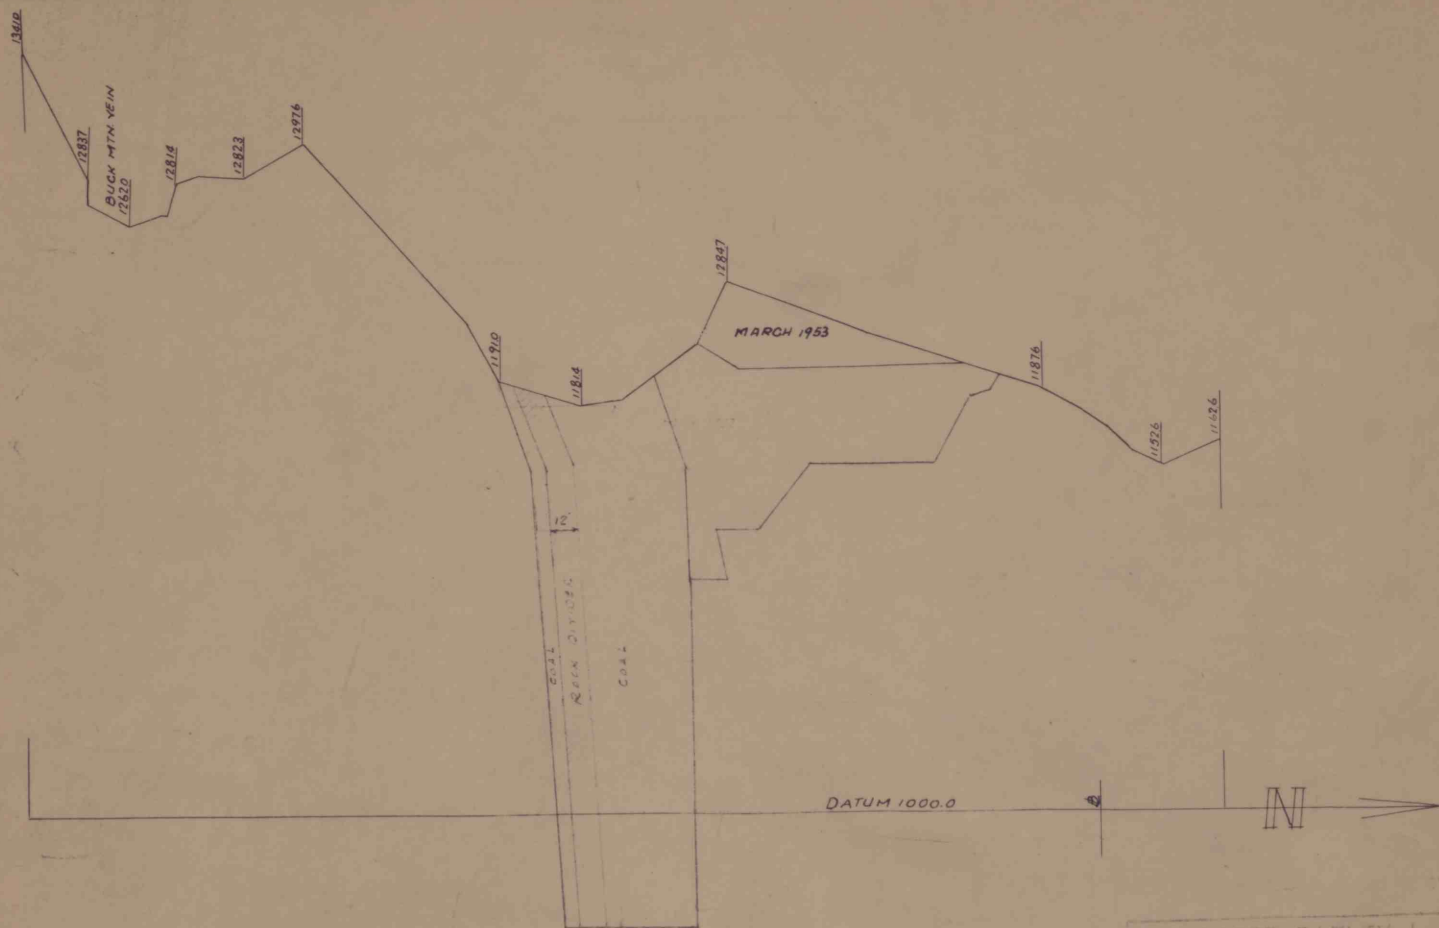

J. ROBERT BAZLEY, Inc.	
POTTSVILLE PENNA.	
ASHTON SOUTH SIDE	
STRIPPING	
SECTION 13+00 WEST	
4-53	1'-50'