


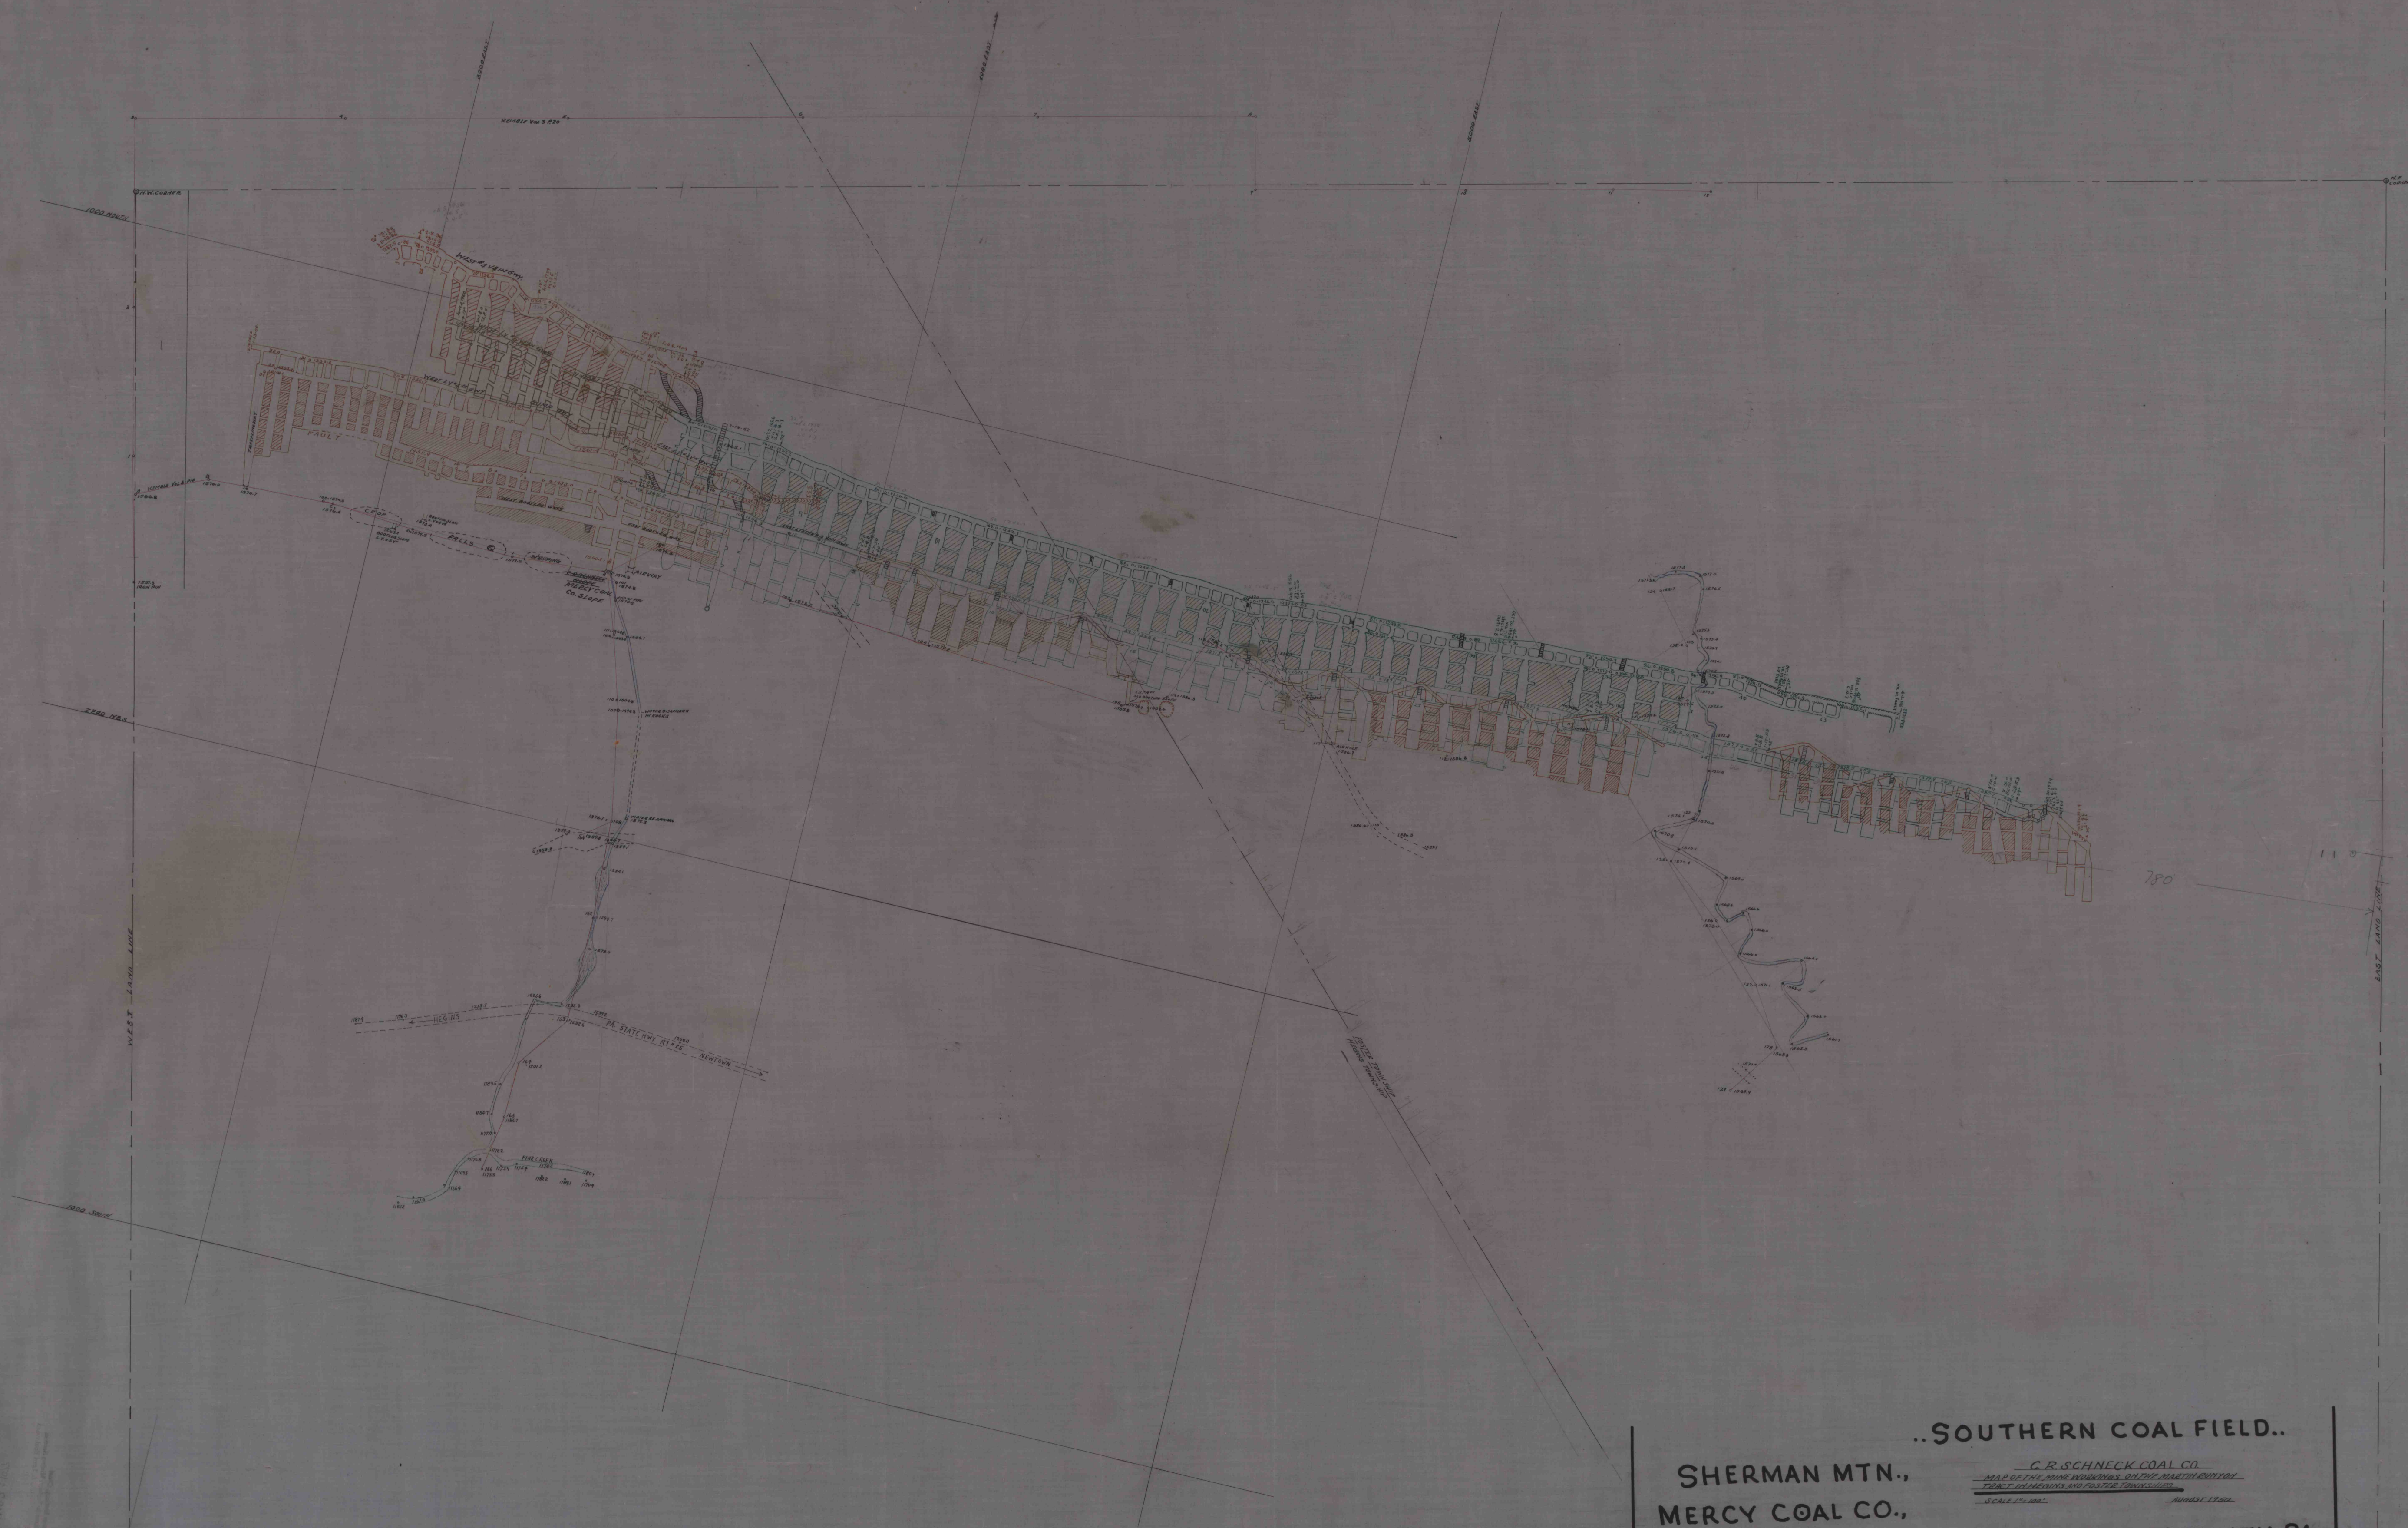

..SOUTHERN COAL FIELD..
 SHERMAN MTN.,
 MERCY COAL CO.,
 SCHUYLKILL COUNTY, PA.


