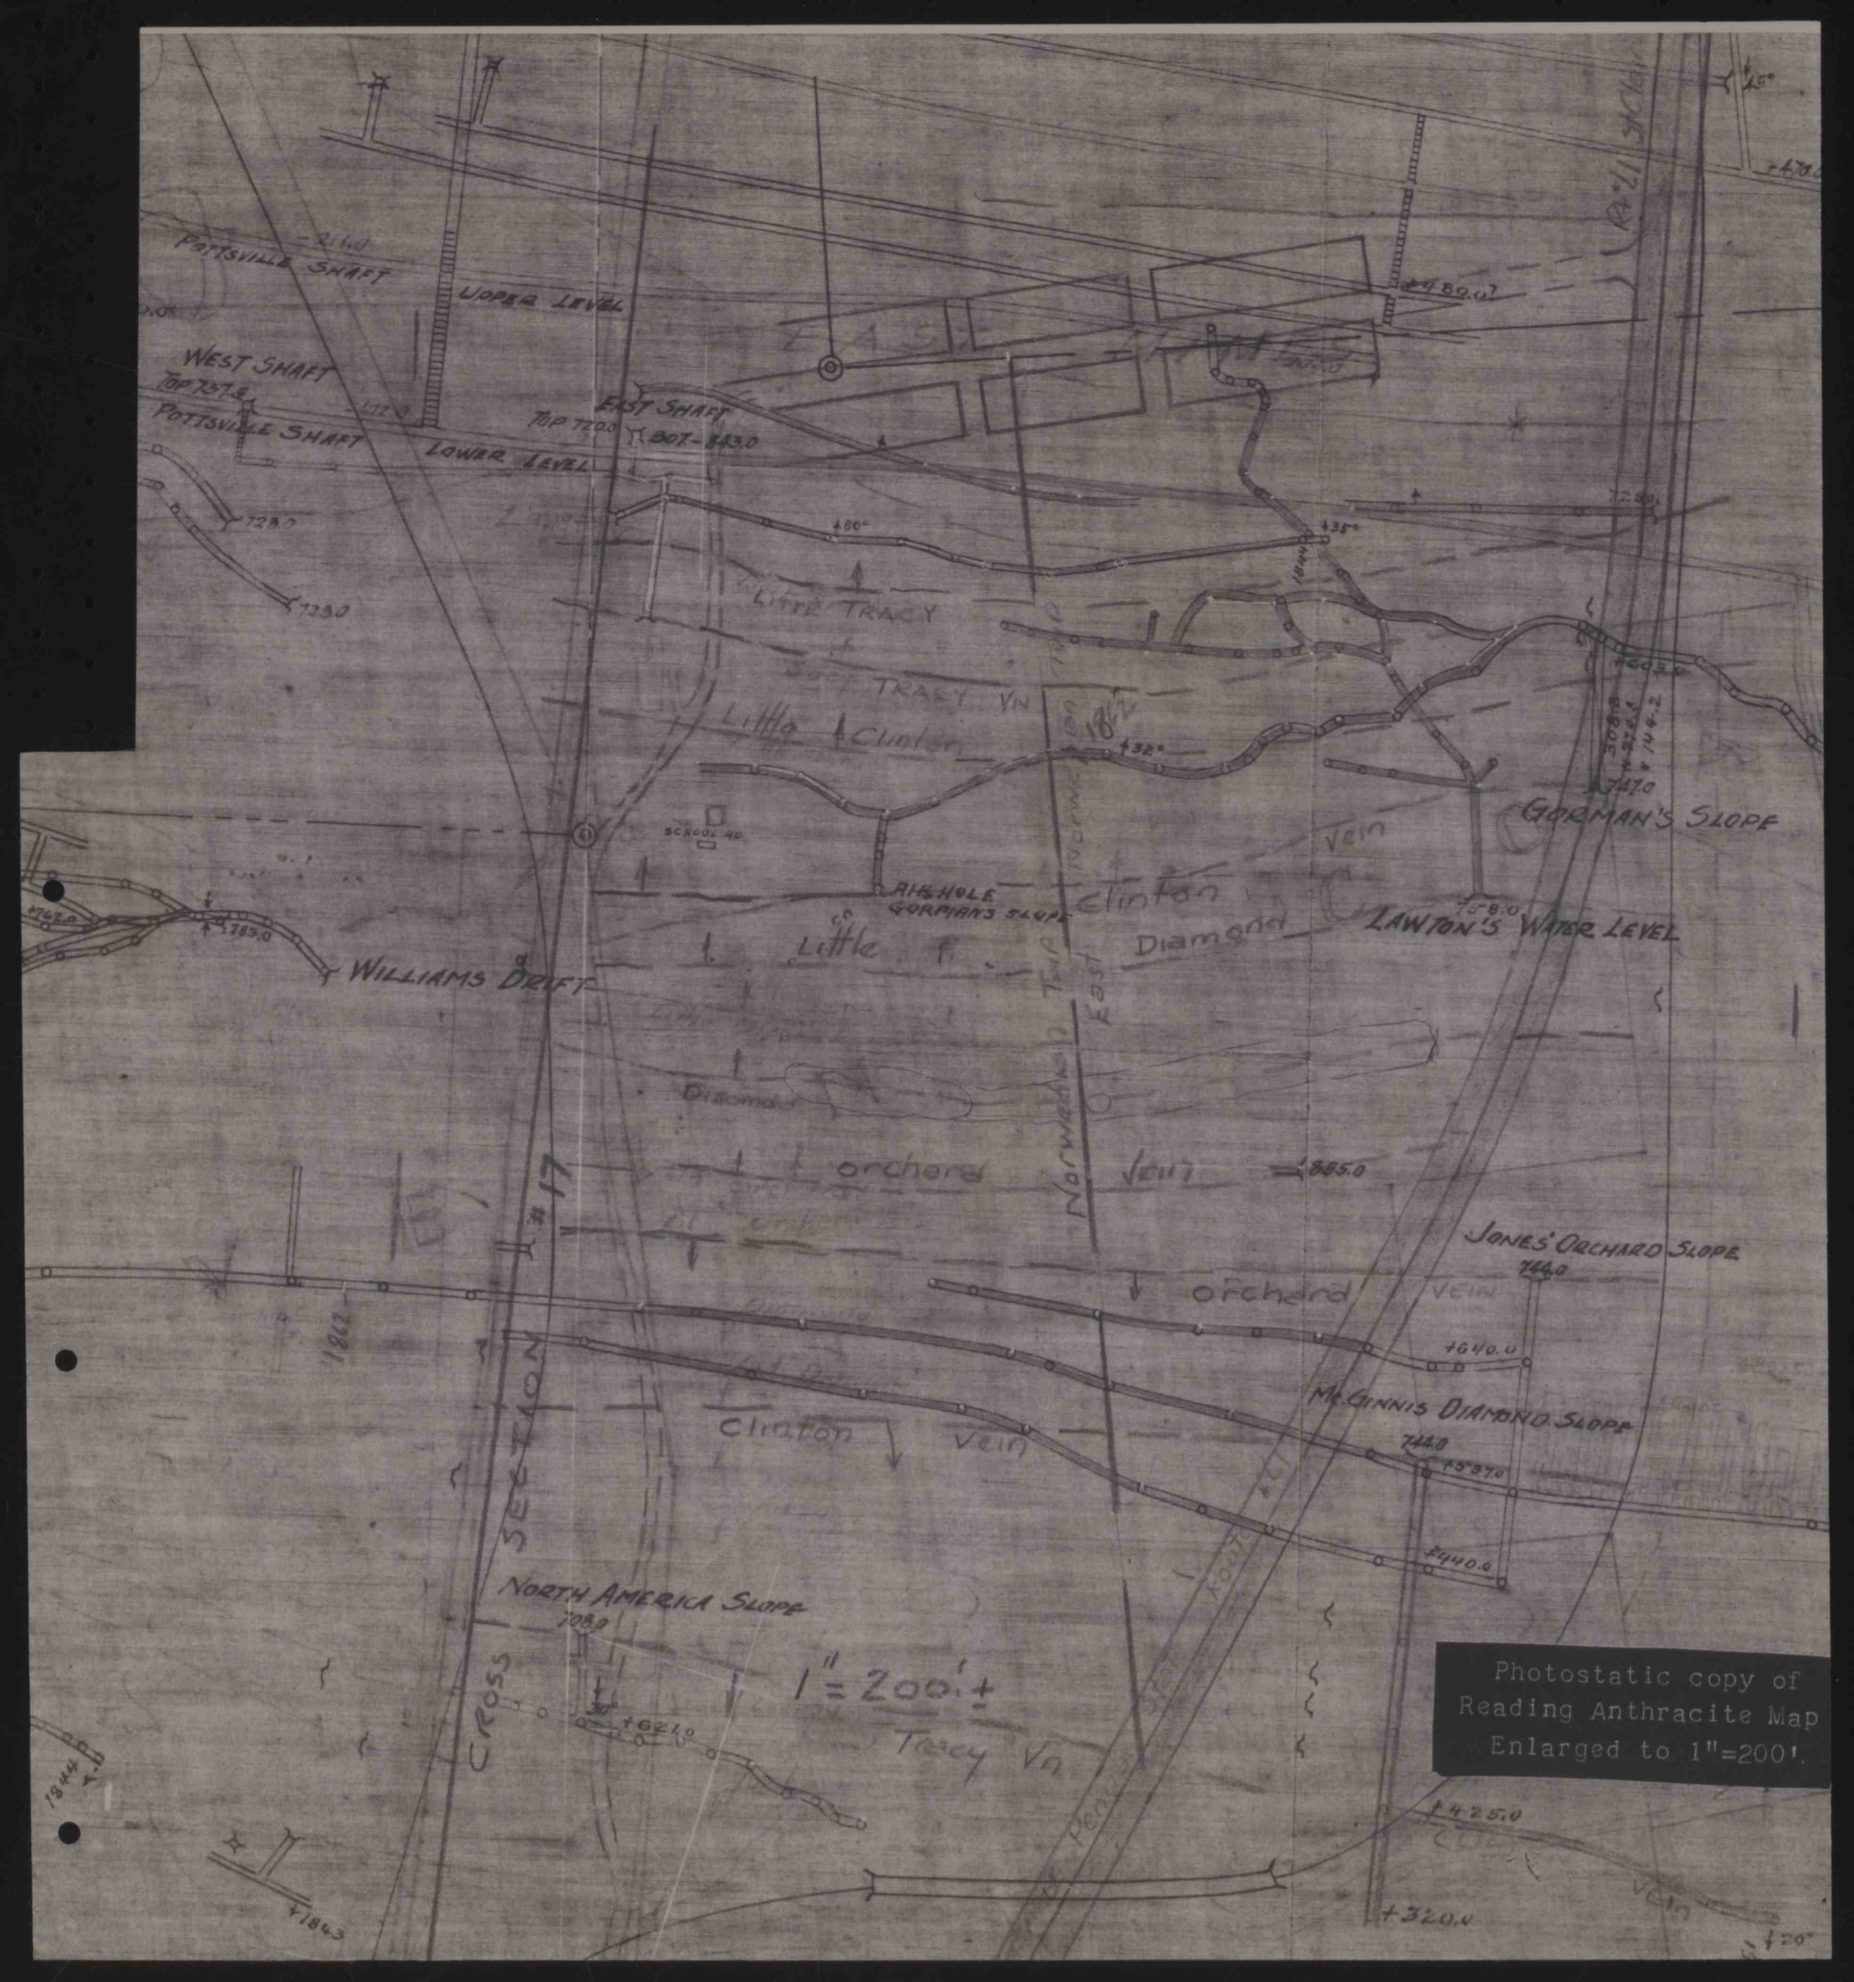

Photostatic copy of Reading Anthracite Map Enlarged to 1"=200'.