


6-9

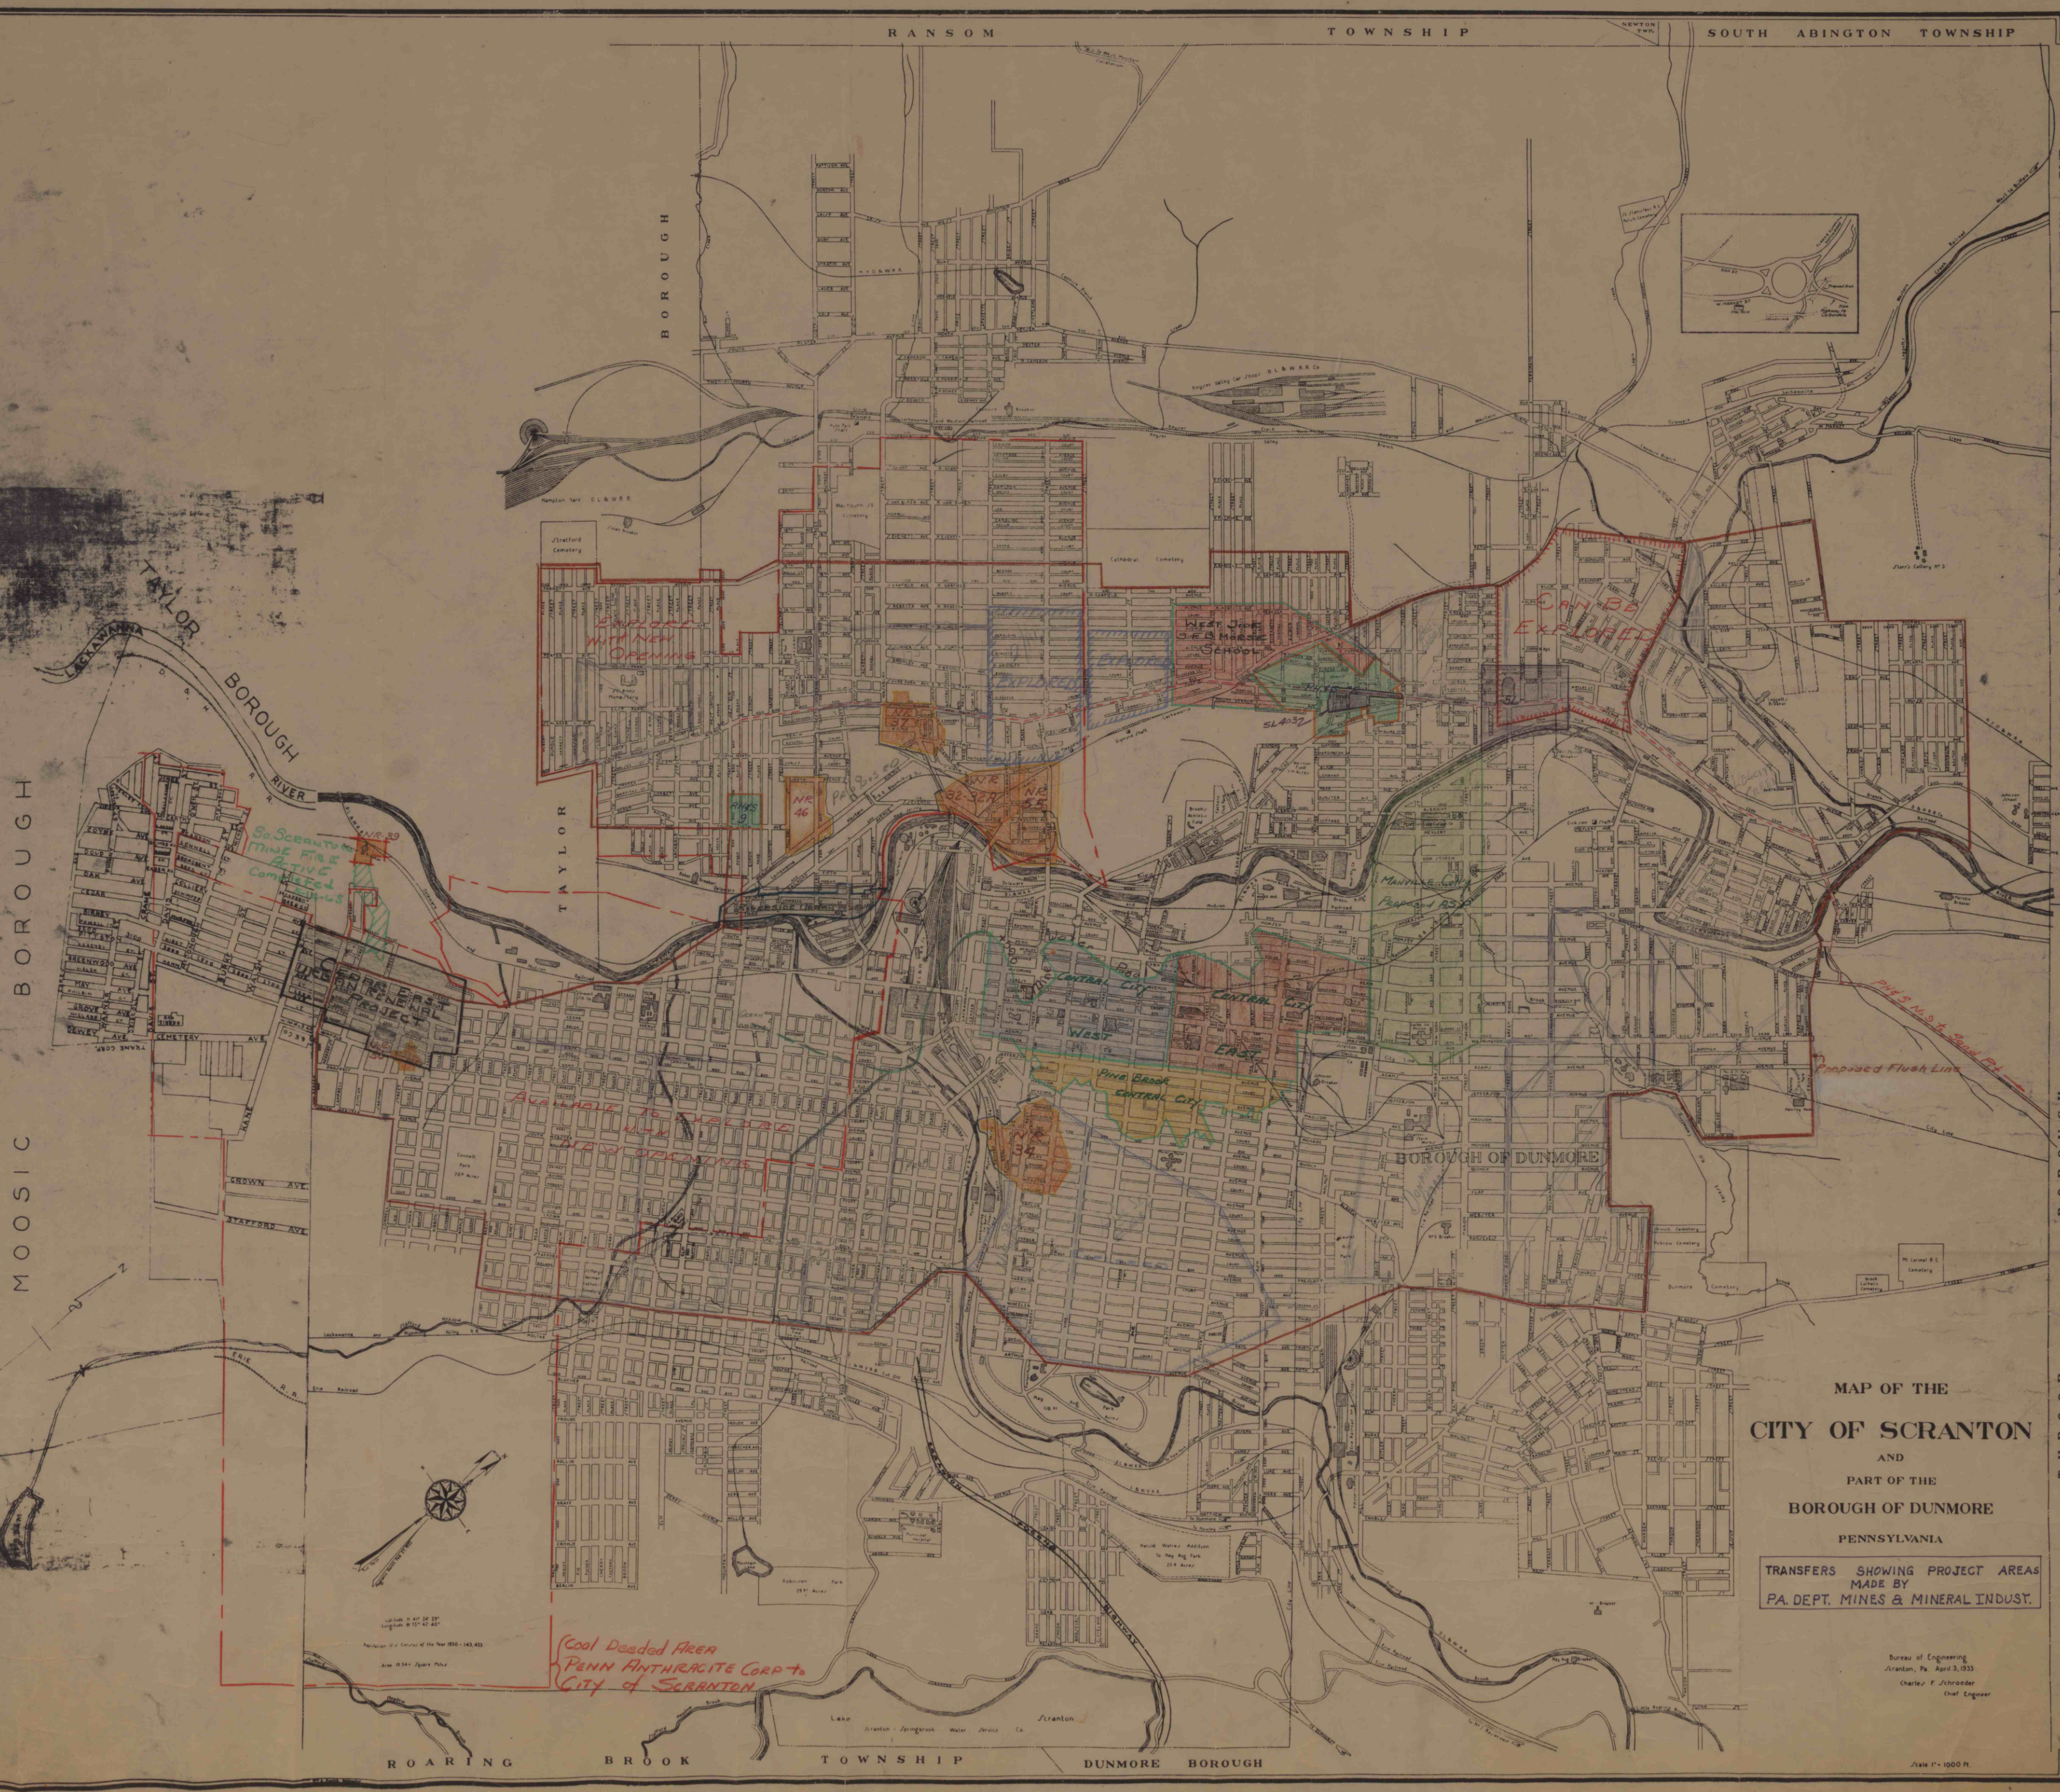

MAP OF THE
CITY OF SCRANTON
AND
PART OF THE
BOROUGH OF DUNMORE
PENNSYLVANIA

TRANSFERS SHOWING PROJECT AREAS
MADE BY
PA. DEPT. MINES & MINERAL INDUSTRY.

Bureau of Engineering
Scranton, Pa. April 3, 1933
Charles F. Schroeder
Chief Engineer

Scale 1" = 1000 Ft.

Lackawanna County
City of Scranton
Surface Northern Coal Field
1-1-1933
April 3, 1933

4140