



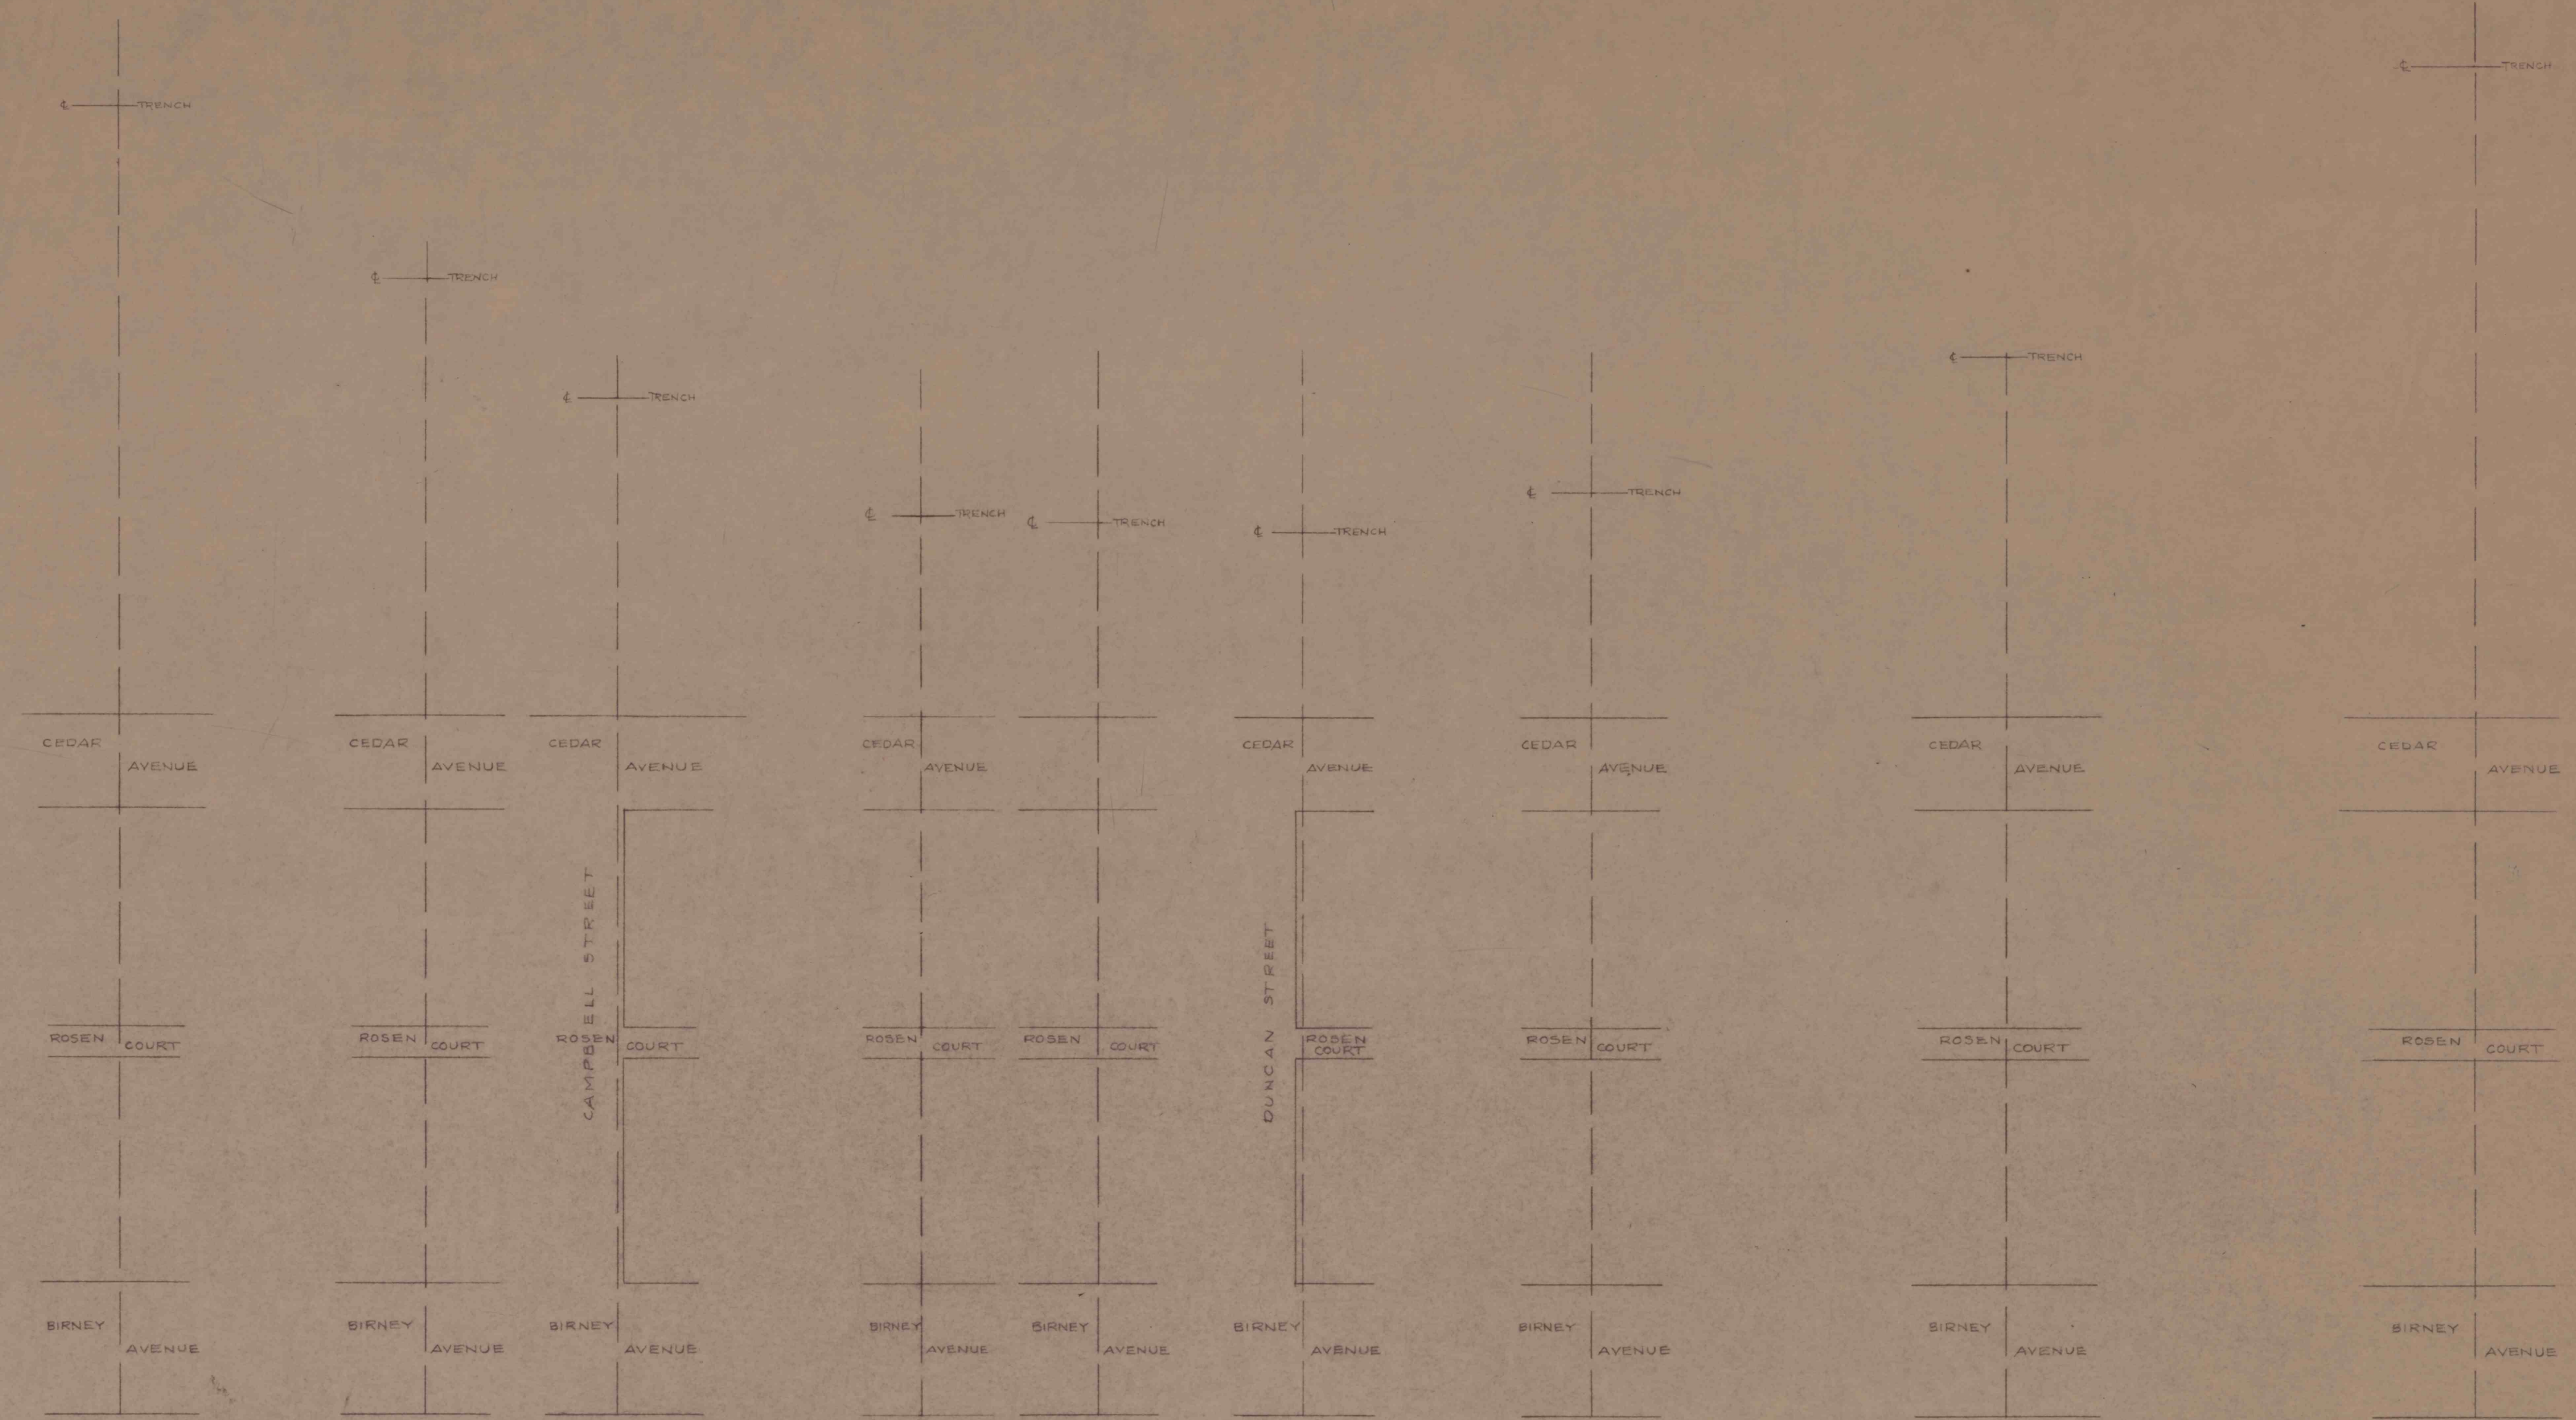

PLAN RELATIVE POSITION

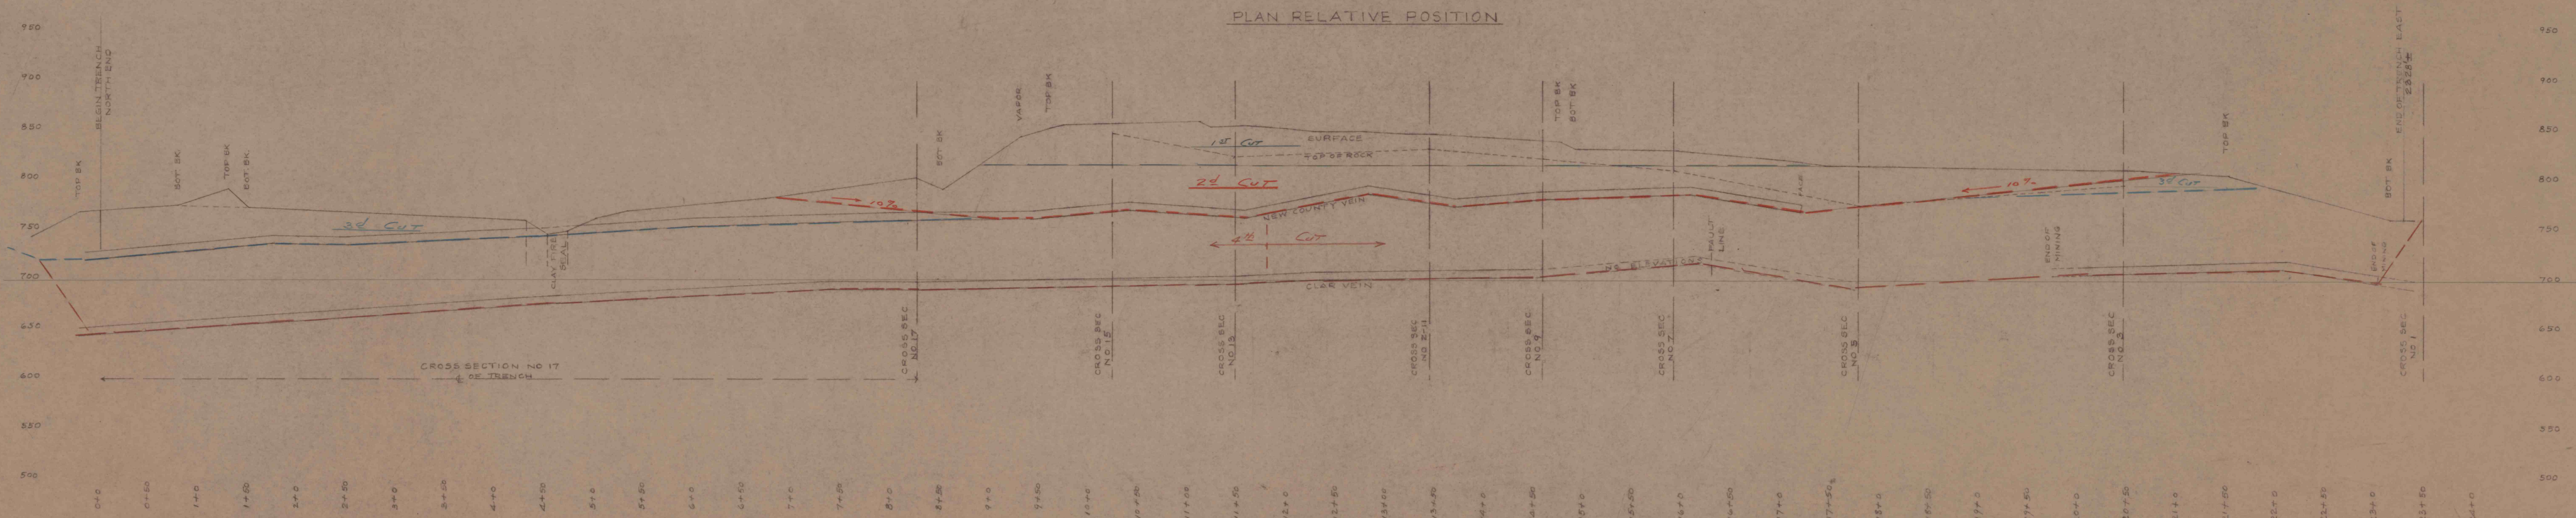

DEPARTMENT OF MINES & MINERAL INDUSTRIES

PROFILE ALONG & OF PROPOSED TRENCH

"CEDAR AVENUE" FIRE AREA

SCALE HOR. & VERT. "1" = 50'

DEC. 12-1966

BUREAU OF ENGINEERING

WILKES-BAKKE, INC.