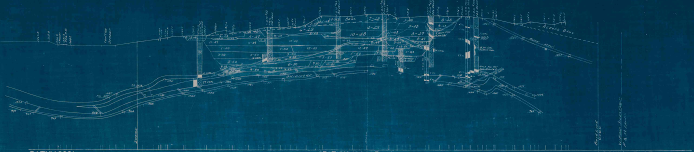

DATUM 800' SECTION 18+00E LOOKING EAST

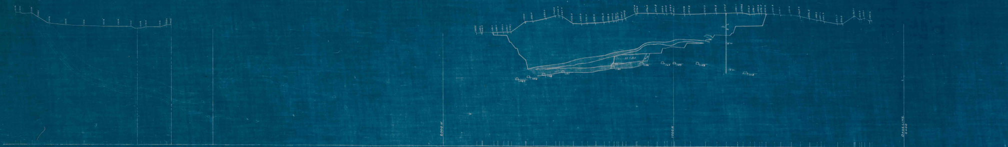

DATUM 800' SECTION 19+00E LOOKING EAST

Western Middle Field.

SHEN-PENN STRIPPING, WEST MAHANOY TWP.,
11 W. MAHANOY DISTRICT, Shenandoah BORO.,
SCHUYLKILL COUNTY PA.

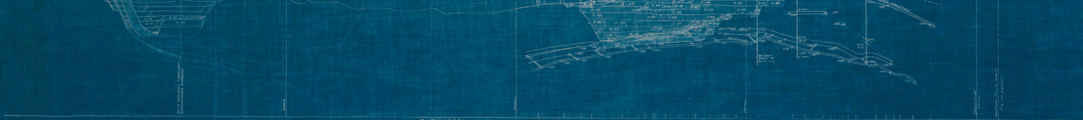

DATUM 800' SECTION 20+00E LOOKING EAST

SHEN-PENN 4110 CROSS SECT

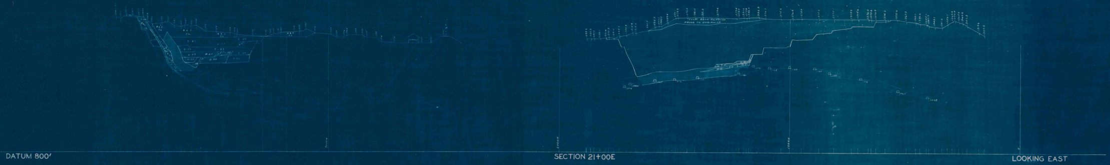
DATUM 800'
SECTION 21+00E
LOOKING EAST

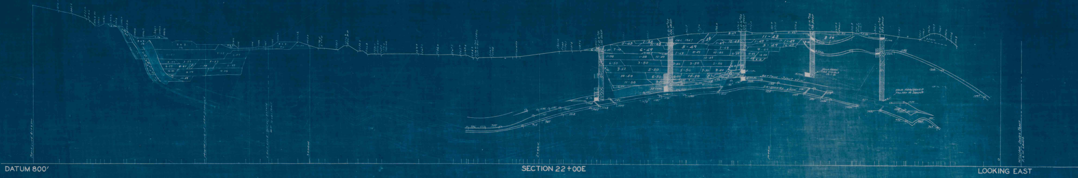
DATUM 800'
SECTION 22+00E
LOOKING EAST

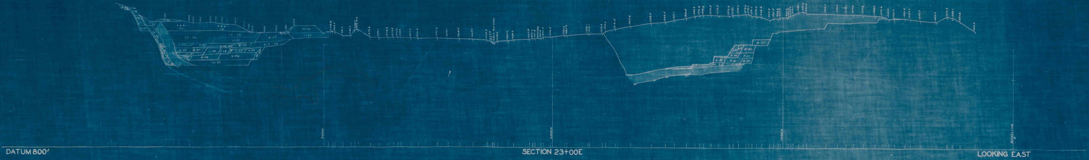
DATUM 800'
SECTION 23+00E
LOOKING EAST

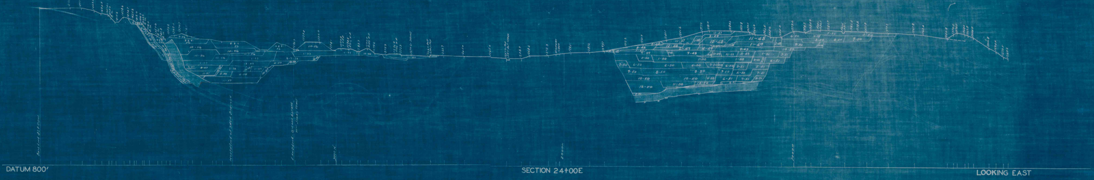
DATUM 800'
SECTION 24+00E
LOOKING EAST

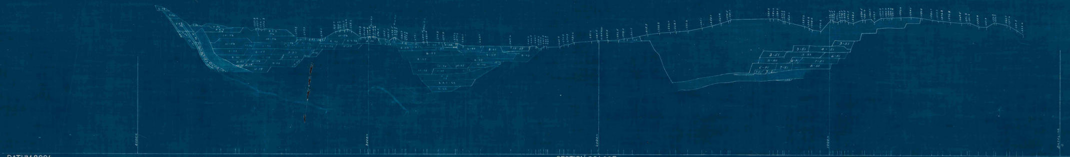

DATUM 800'

SECTION 25+00E

LOOKING EAST

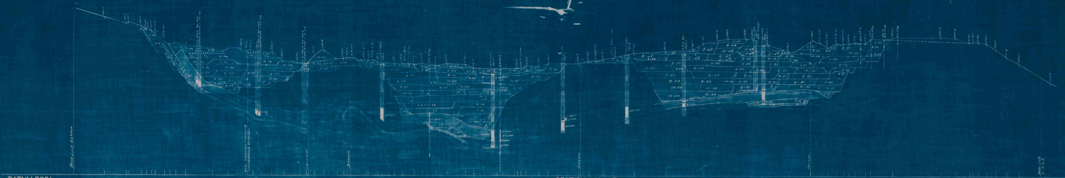

DATUM 800'

SECTION 26+00E

LOOKING EAST

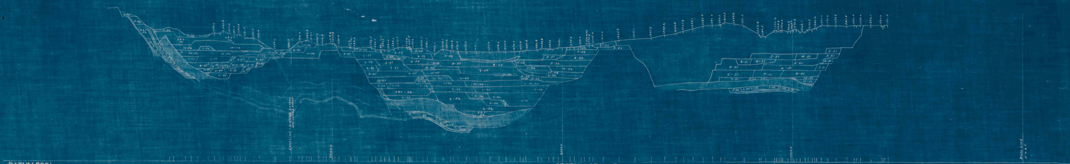

DATUM 800'

SECTION 27+00E

LOOKING EAST

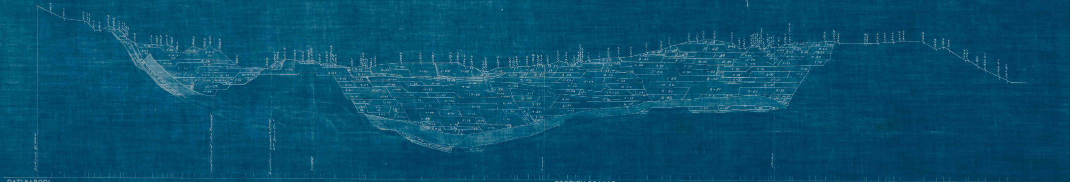

DATUM 800'

SECTION 28+00E

LOOKING EAST

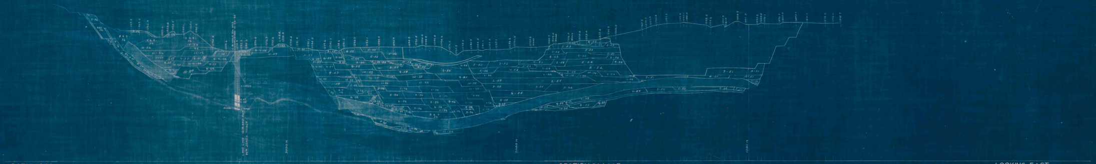

DATUM 800′ SECTION 29+00E LOOKING EAST

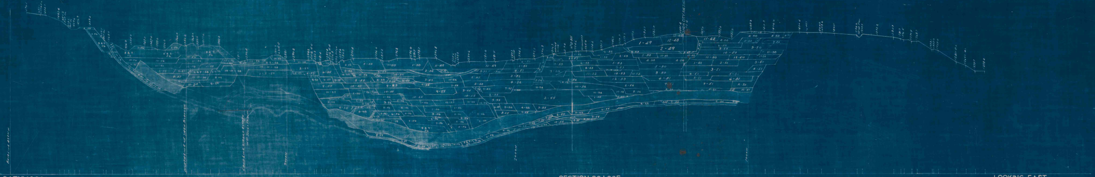

DATUM 800′ SECTION 30+00E LOOKING EAST

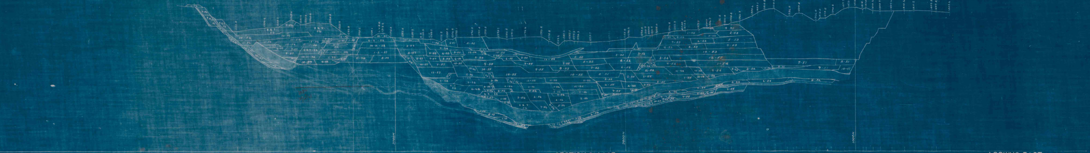

DATUM 800′ SECTION 31+00E LOOKING EAST

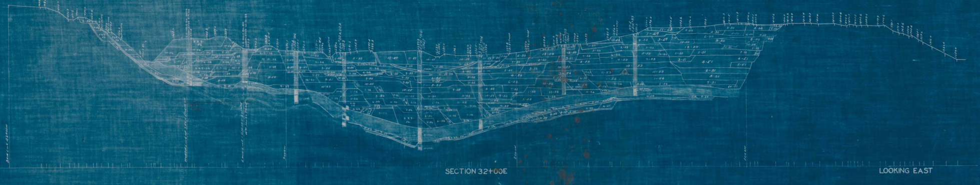

DATUM 800′ SECTION 32+00E LOOKING EAST

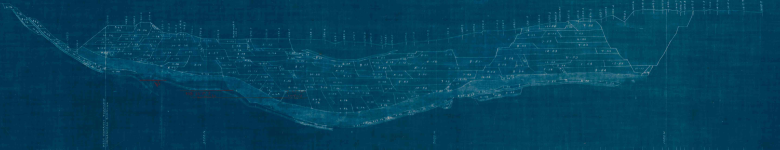

DATUM 800′ SECTION 33+00E LOOKING EAST

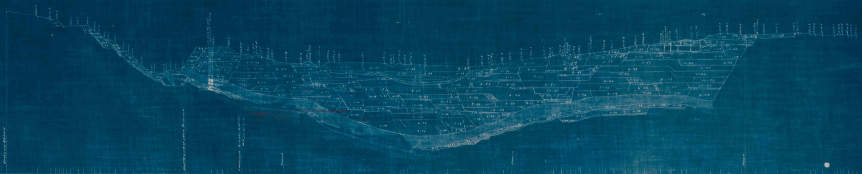

DATUM 800′ SECTION 34+00E LOOKING EAST

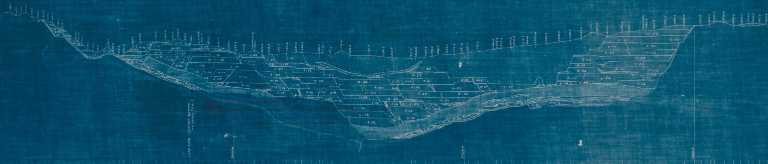

DATUM 800′ SECTION 35+00E LOOKING EAST

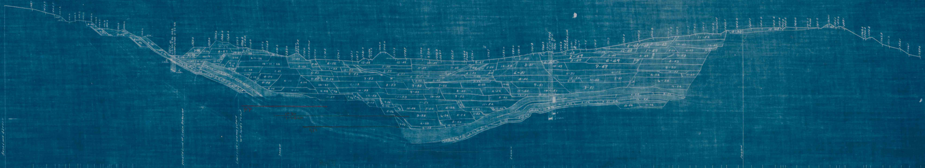

DATUM 800′ SECTION 36+00E LOOKING EAST

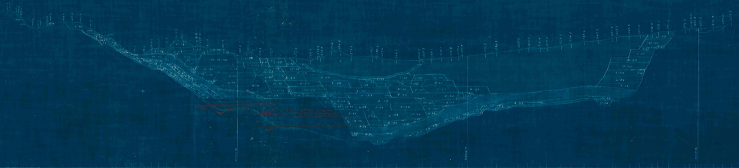

DATUM 800' SECTION 37+00E LOOKING EAST

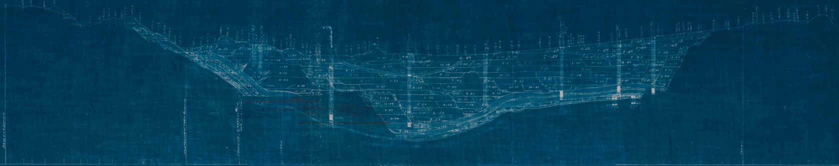

DATUM 800' SECTION 38+00E LOOKING EAST

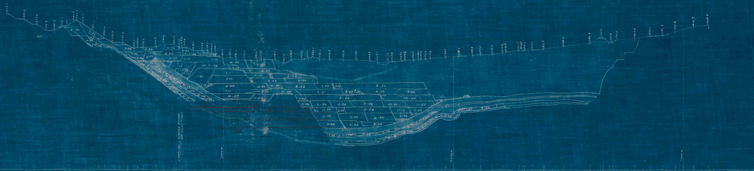

DATUM 800' SECTION 39+00E LOOKING EAST

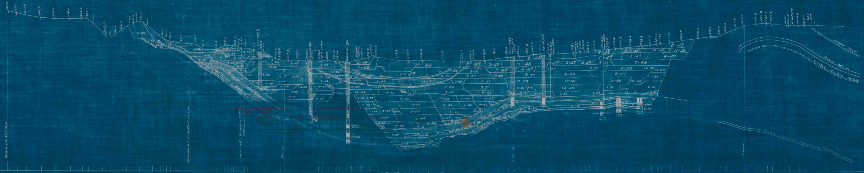

DATUM 800' SECTION 40+00E LOOKING EAST

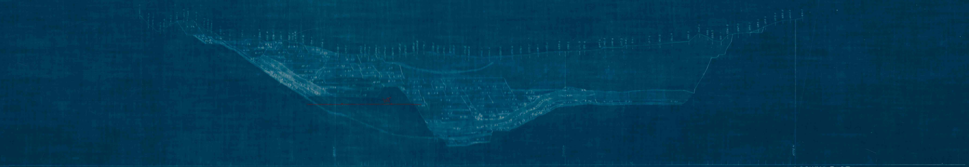

DATUM 800' SECTION 41+00E LOOKING EAST

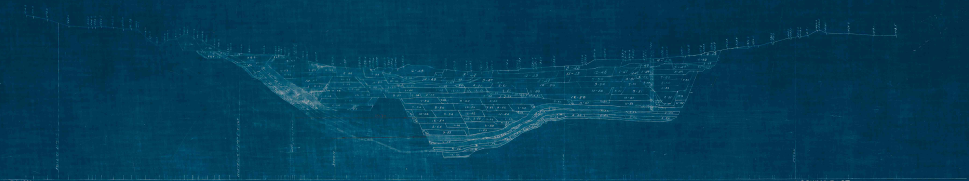

DATUM 800' SECTION 42+00E LOOKING EAST

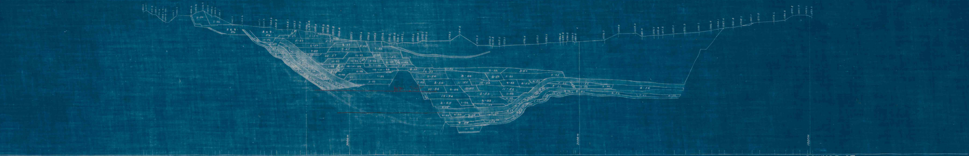

DATUM 800' SECTION 43+00E LOOKING EAST

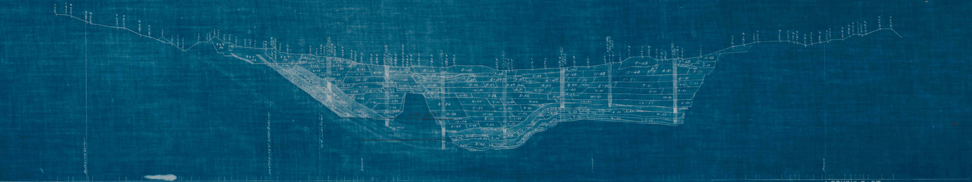

DATUM 800' SECTION 44+00E LOOKING EAST

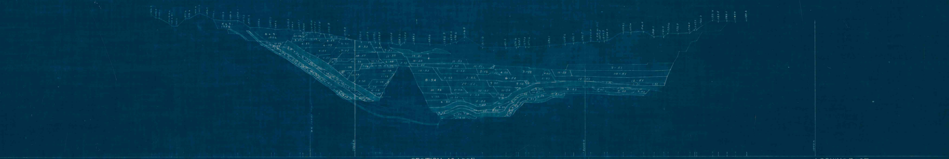

DATUM 800′ SECTION 45+00E LOOKING EAST

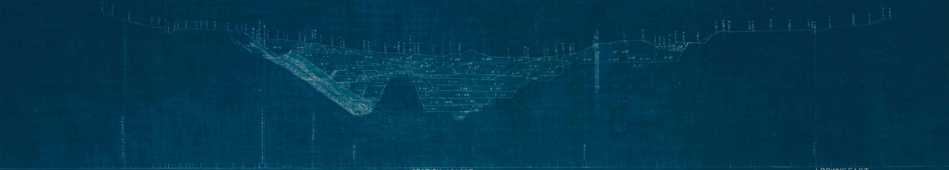

DATUM 800′ SECTION 46+00E LOOKING EAST

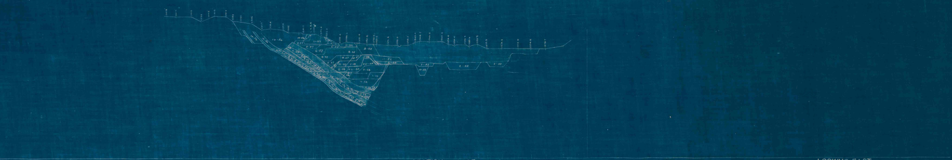

DATUM 800′ SECTION 47+00E LOOKING EAST

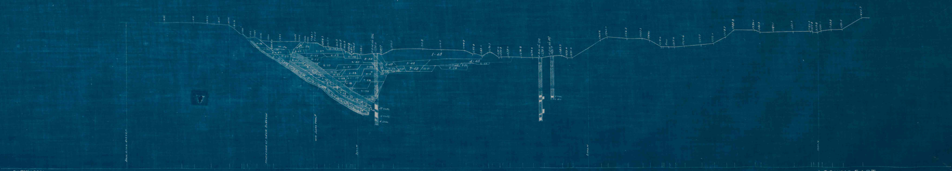

DATUM 800′ SECTION 48+00E LOOKING EAST