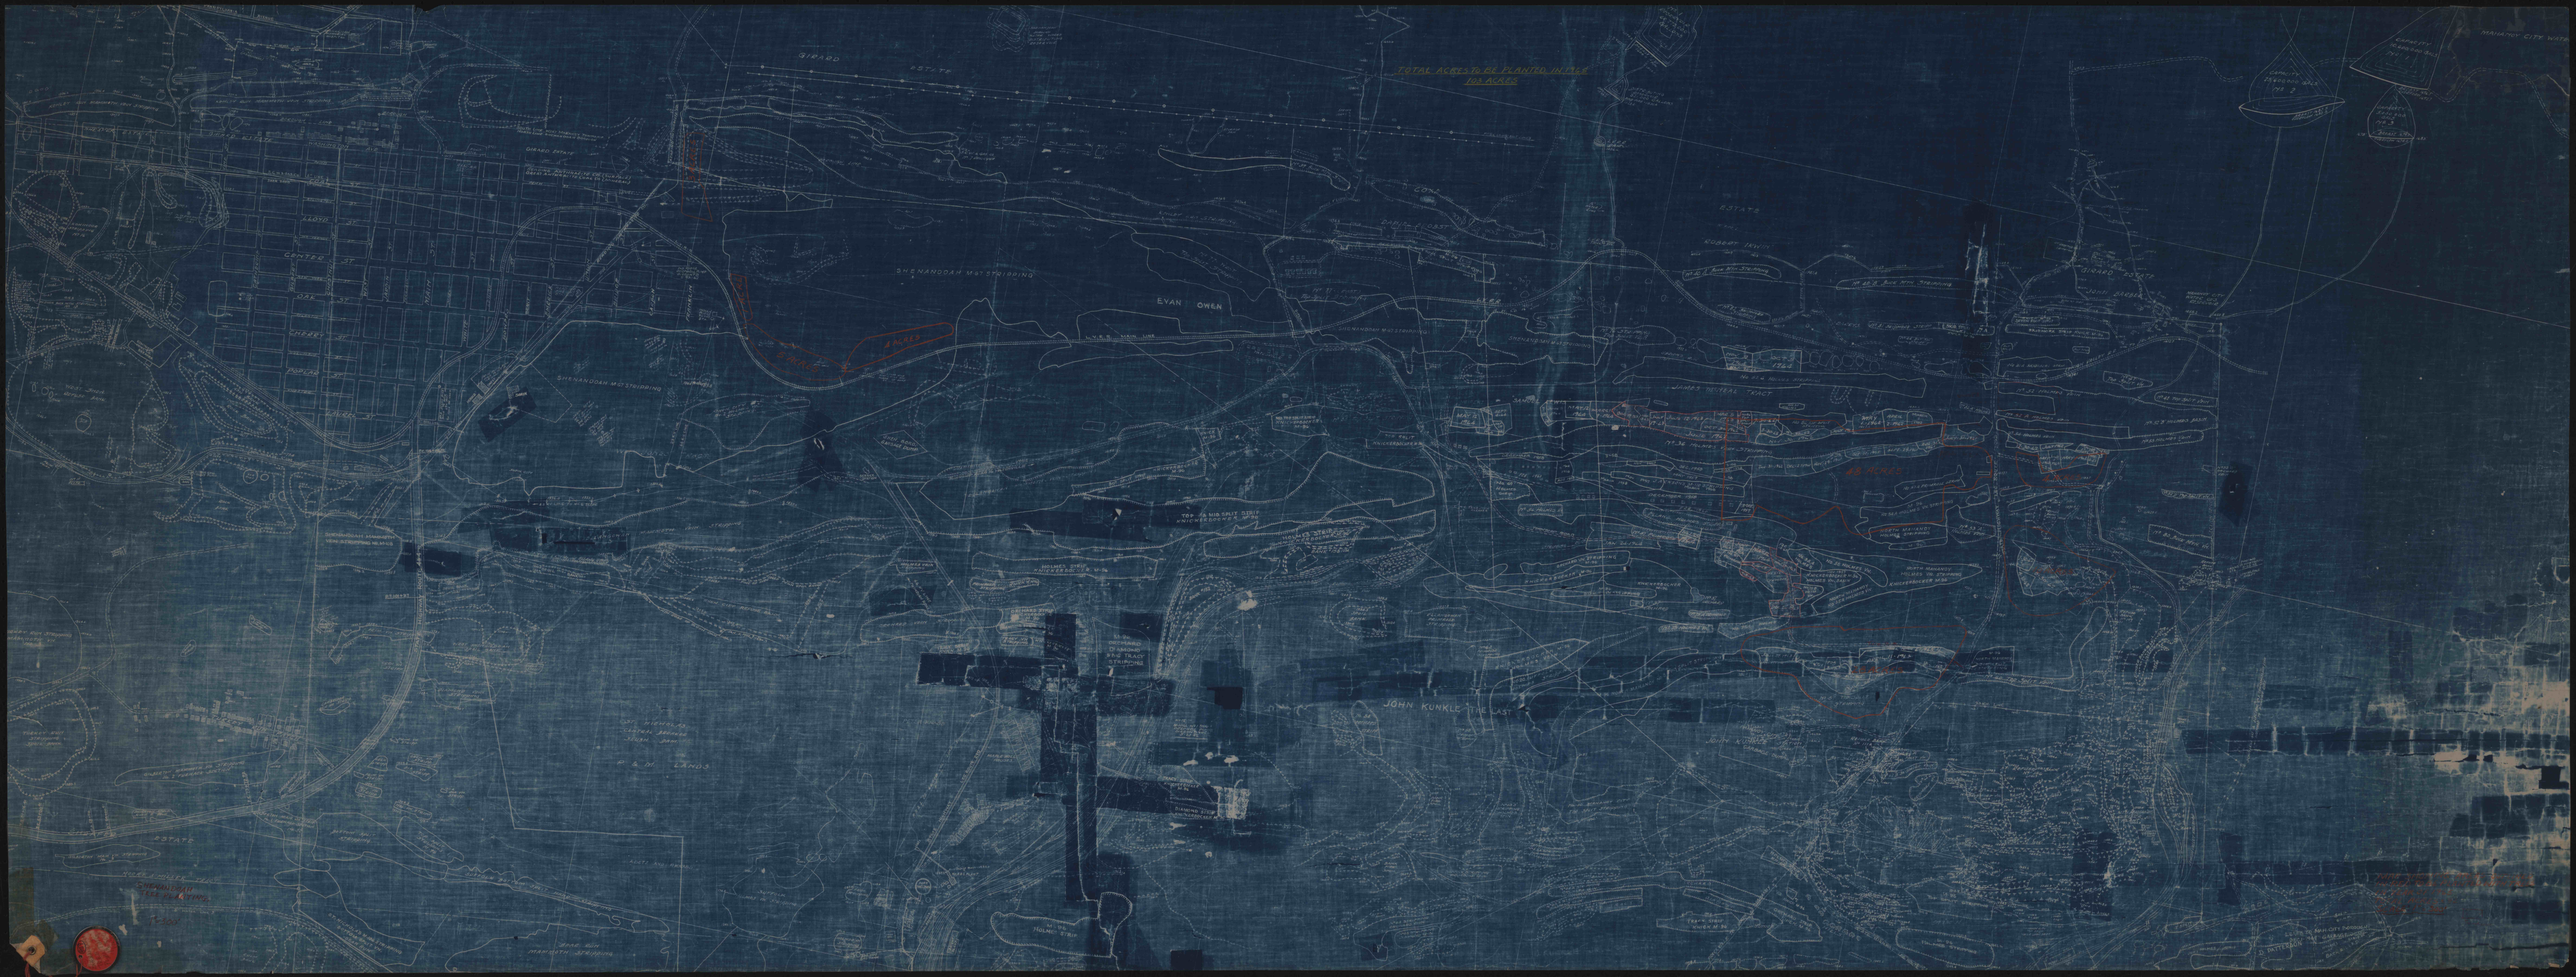
TOTAL ACRES TO BE PLANTED IN THE 100 ACRES
GIRARD ESTATE
CENTER ST
OAK ST
SHENANDOAH WOOD STRIPPING
EVAN OWEN
JOHN KUNKLE
ESTATE
GIRARD
MANAYUNK CITY WATER