


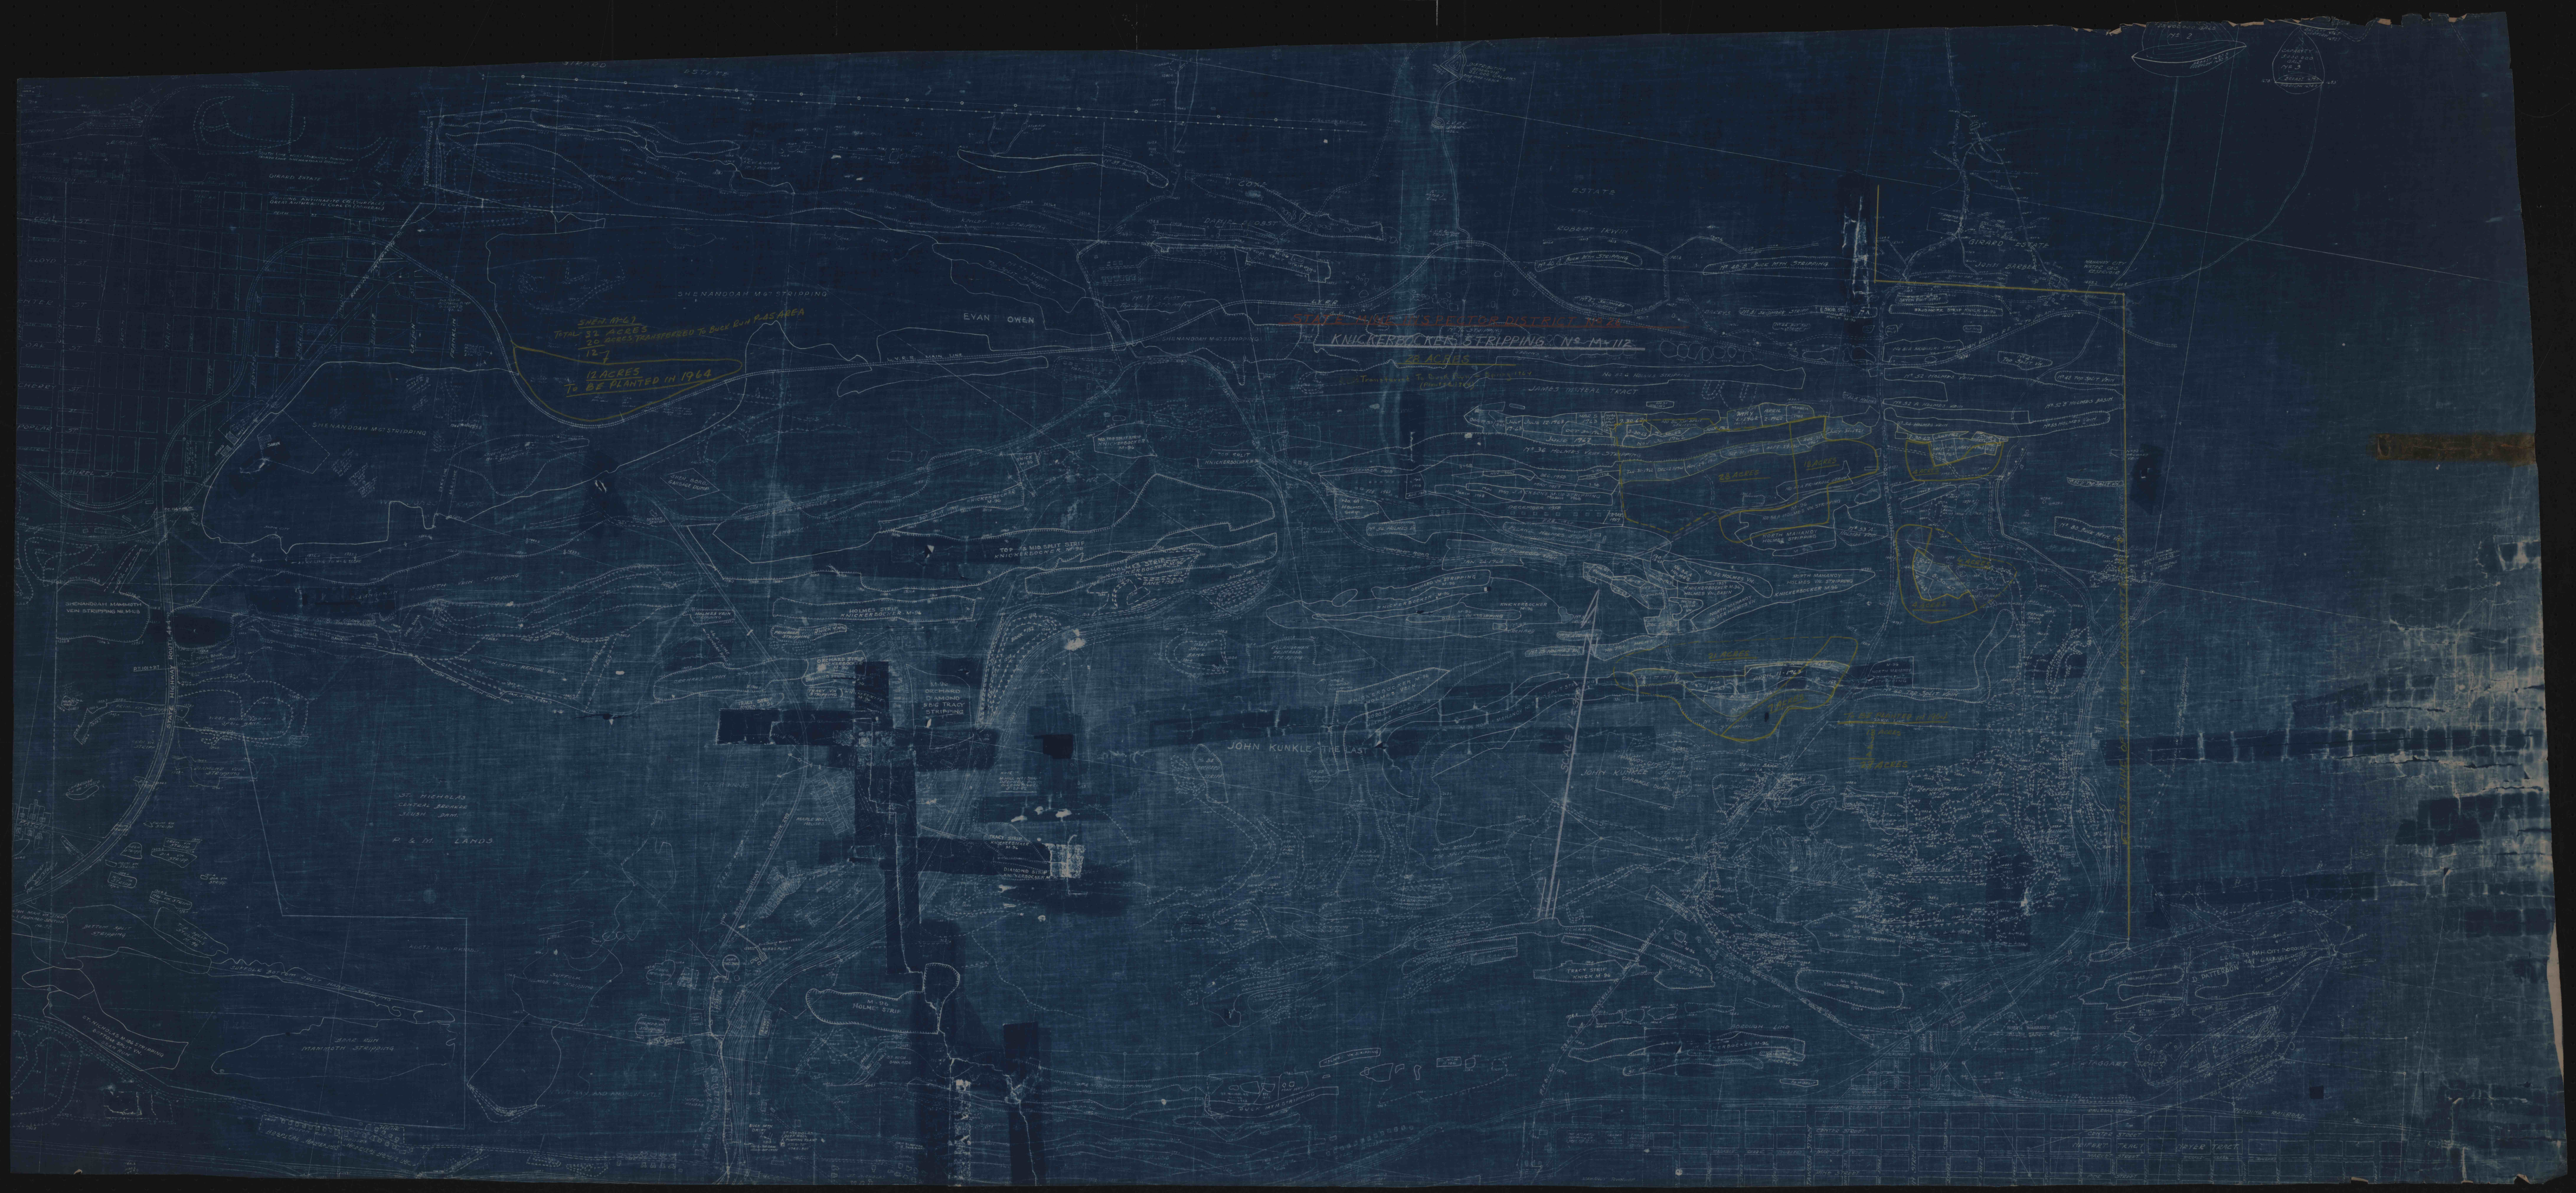

SHEN M-61
TOTAL 32 ACRES
20 ACRES TRANSFERRED TO BUCK RUN BASIN AREA
12-7
12 ACRES
TO BE PLANTED IN 1964

STATE MINE INSPECTOR DISTRICT NO. 12
KNICKERBOCKER STRIPPING NO. M-112
28 ACRES
Transferred to Buck Run Basin Area
(Holloway)

EAST LINE OF SHENANDOAH MOUNTAIN STRIPPING

TO BE PLANTED IN 1964
15 ACRES