


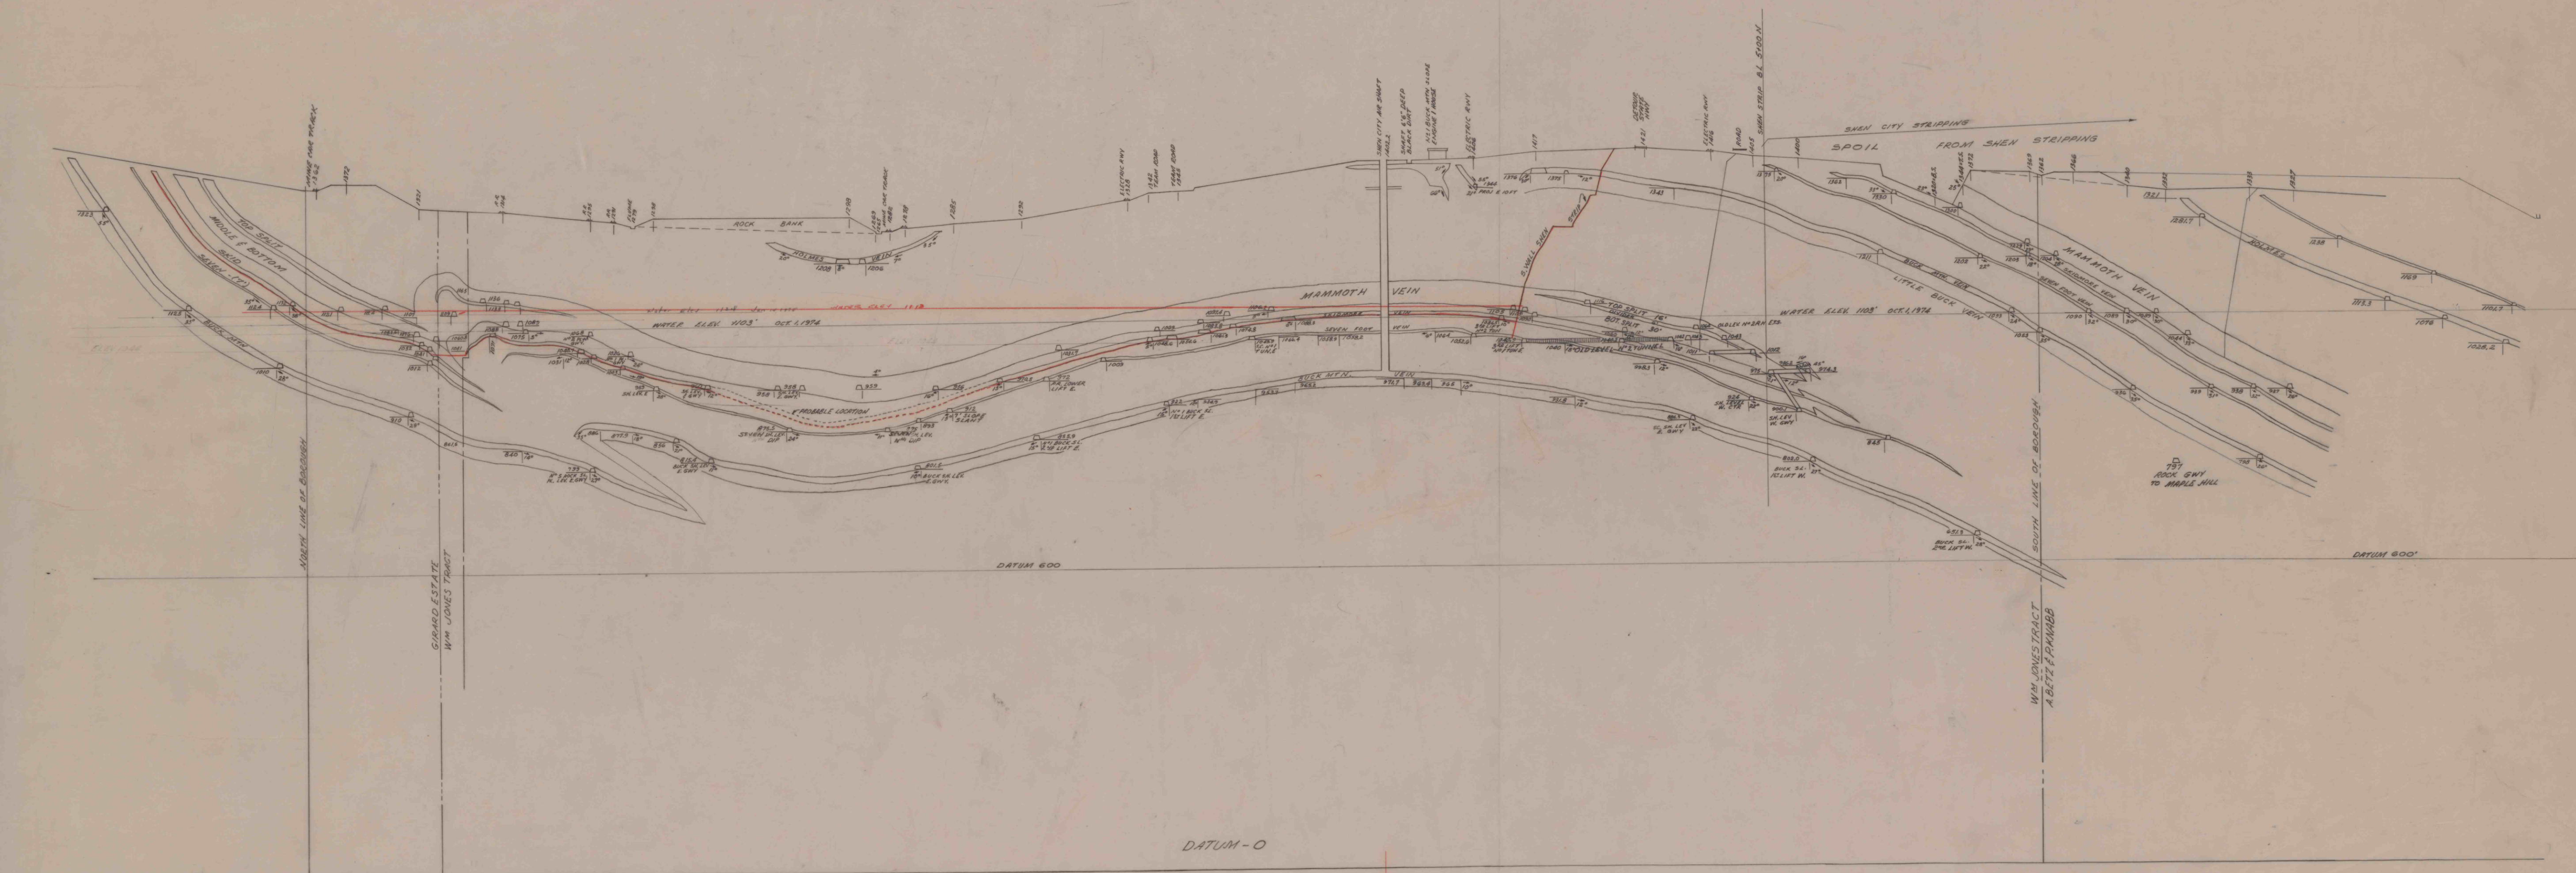

..SOUTHERN COAL FIELD..
 CROSS SECTION THROUGH SHENANDOAN CITY AIR SHAFT AND
 PARALLEL TO WEST LINE OF WILLIAM JONES TRACT
 SCHUYLKILL COUNTY..SCALE 1"=100'
 SHENANDOAN, PA. SECTION - 13 OFFICE DIVISION ENGINEER.
 TRACED DEC. 5, 1974. M.M. SELINSKY - DEB.

SOUTHERN CO. 1"=100..
 X-SECTION THROUGH SHENAND..
 OAH CITY AIR SHAFT &
 PARALLEL TO WEST LINE OF
 W. JONES TRACT
 SCHUYLKILL CO., PA.
 SECTION 13, SHENAND. PA.
 2-VELOCIMETER PRINT