


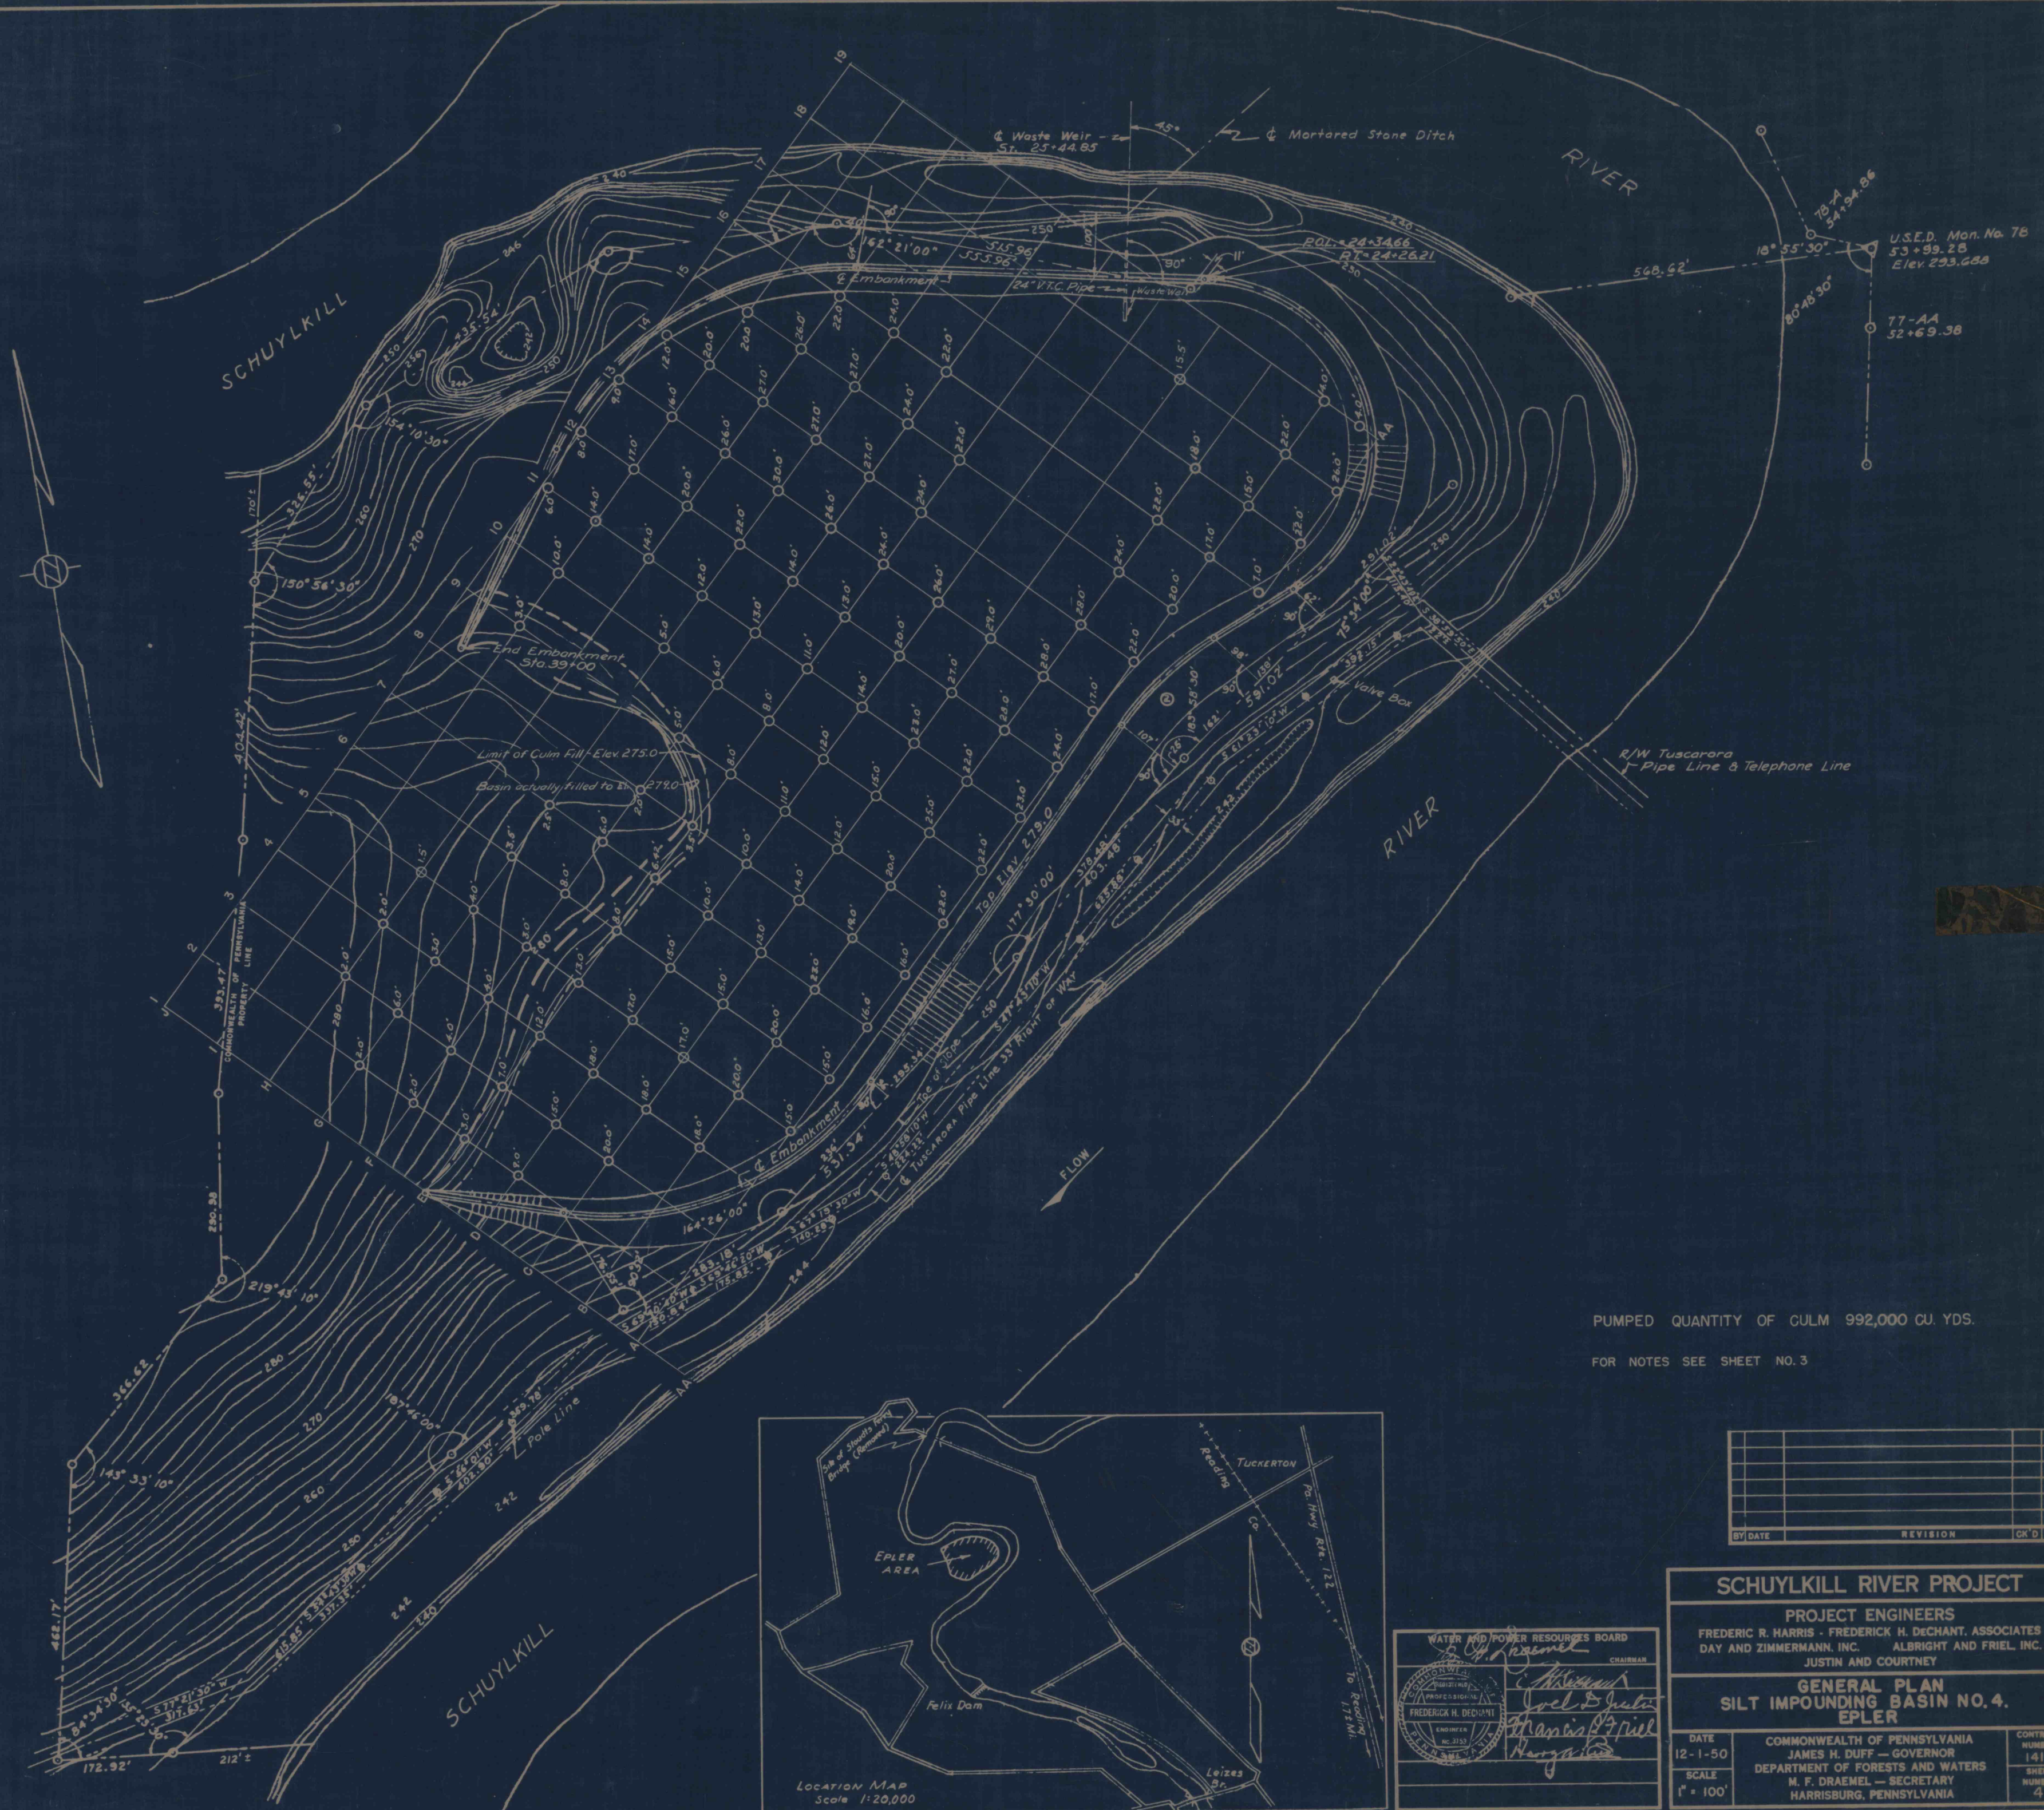

PUMPED QUANTITY OF CULM 992,000 CU. YDS.
FOR NOTES SEE SHEET NO. 3



WATER AND POWER RESOURCES BOARD	
CHAIRMAN	
FREDERICK H. DECHANT	
ENGINEER	
NO. 2150	
DATE	
12-1-50	
SCALE	
1" = 100'	

DATE	REVISION	CHK'D	APP

SCHUYLKILL RIVER PROJECT

PROJECT ENGINEERS

FREDERIC R. HARRIS - FREDERICK H. DECHANT, ASSOCIATES
DAY AND ZIMMERMANN, INC. ALBRIGHT AND FRIEL, INC.
JUSTIN AND COURTNEY

GENERAL PLAN SILT IMPOUNDING BASIN NO. 4. EPLER

DATE	COMMONWEALTH OF PENNSYLVANIA	CONTRACT
12-1-50	JAMES H. DUFF - GOVERNOR	NUMBER
SCALE	DEPARTMENT OF FORESTS AND WATERS	1416
1" = 100'	M. F. DRAEMEL - SECRETARY	SHEET
	HARRISBURG, PENNSYLVANIA	NUMBER
		4