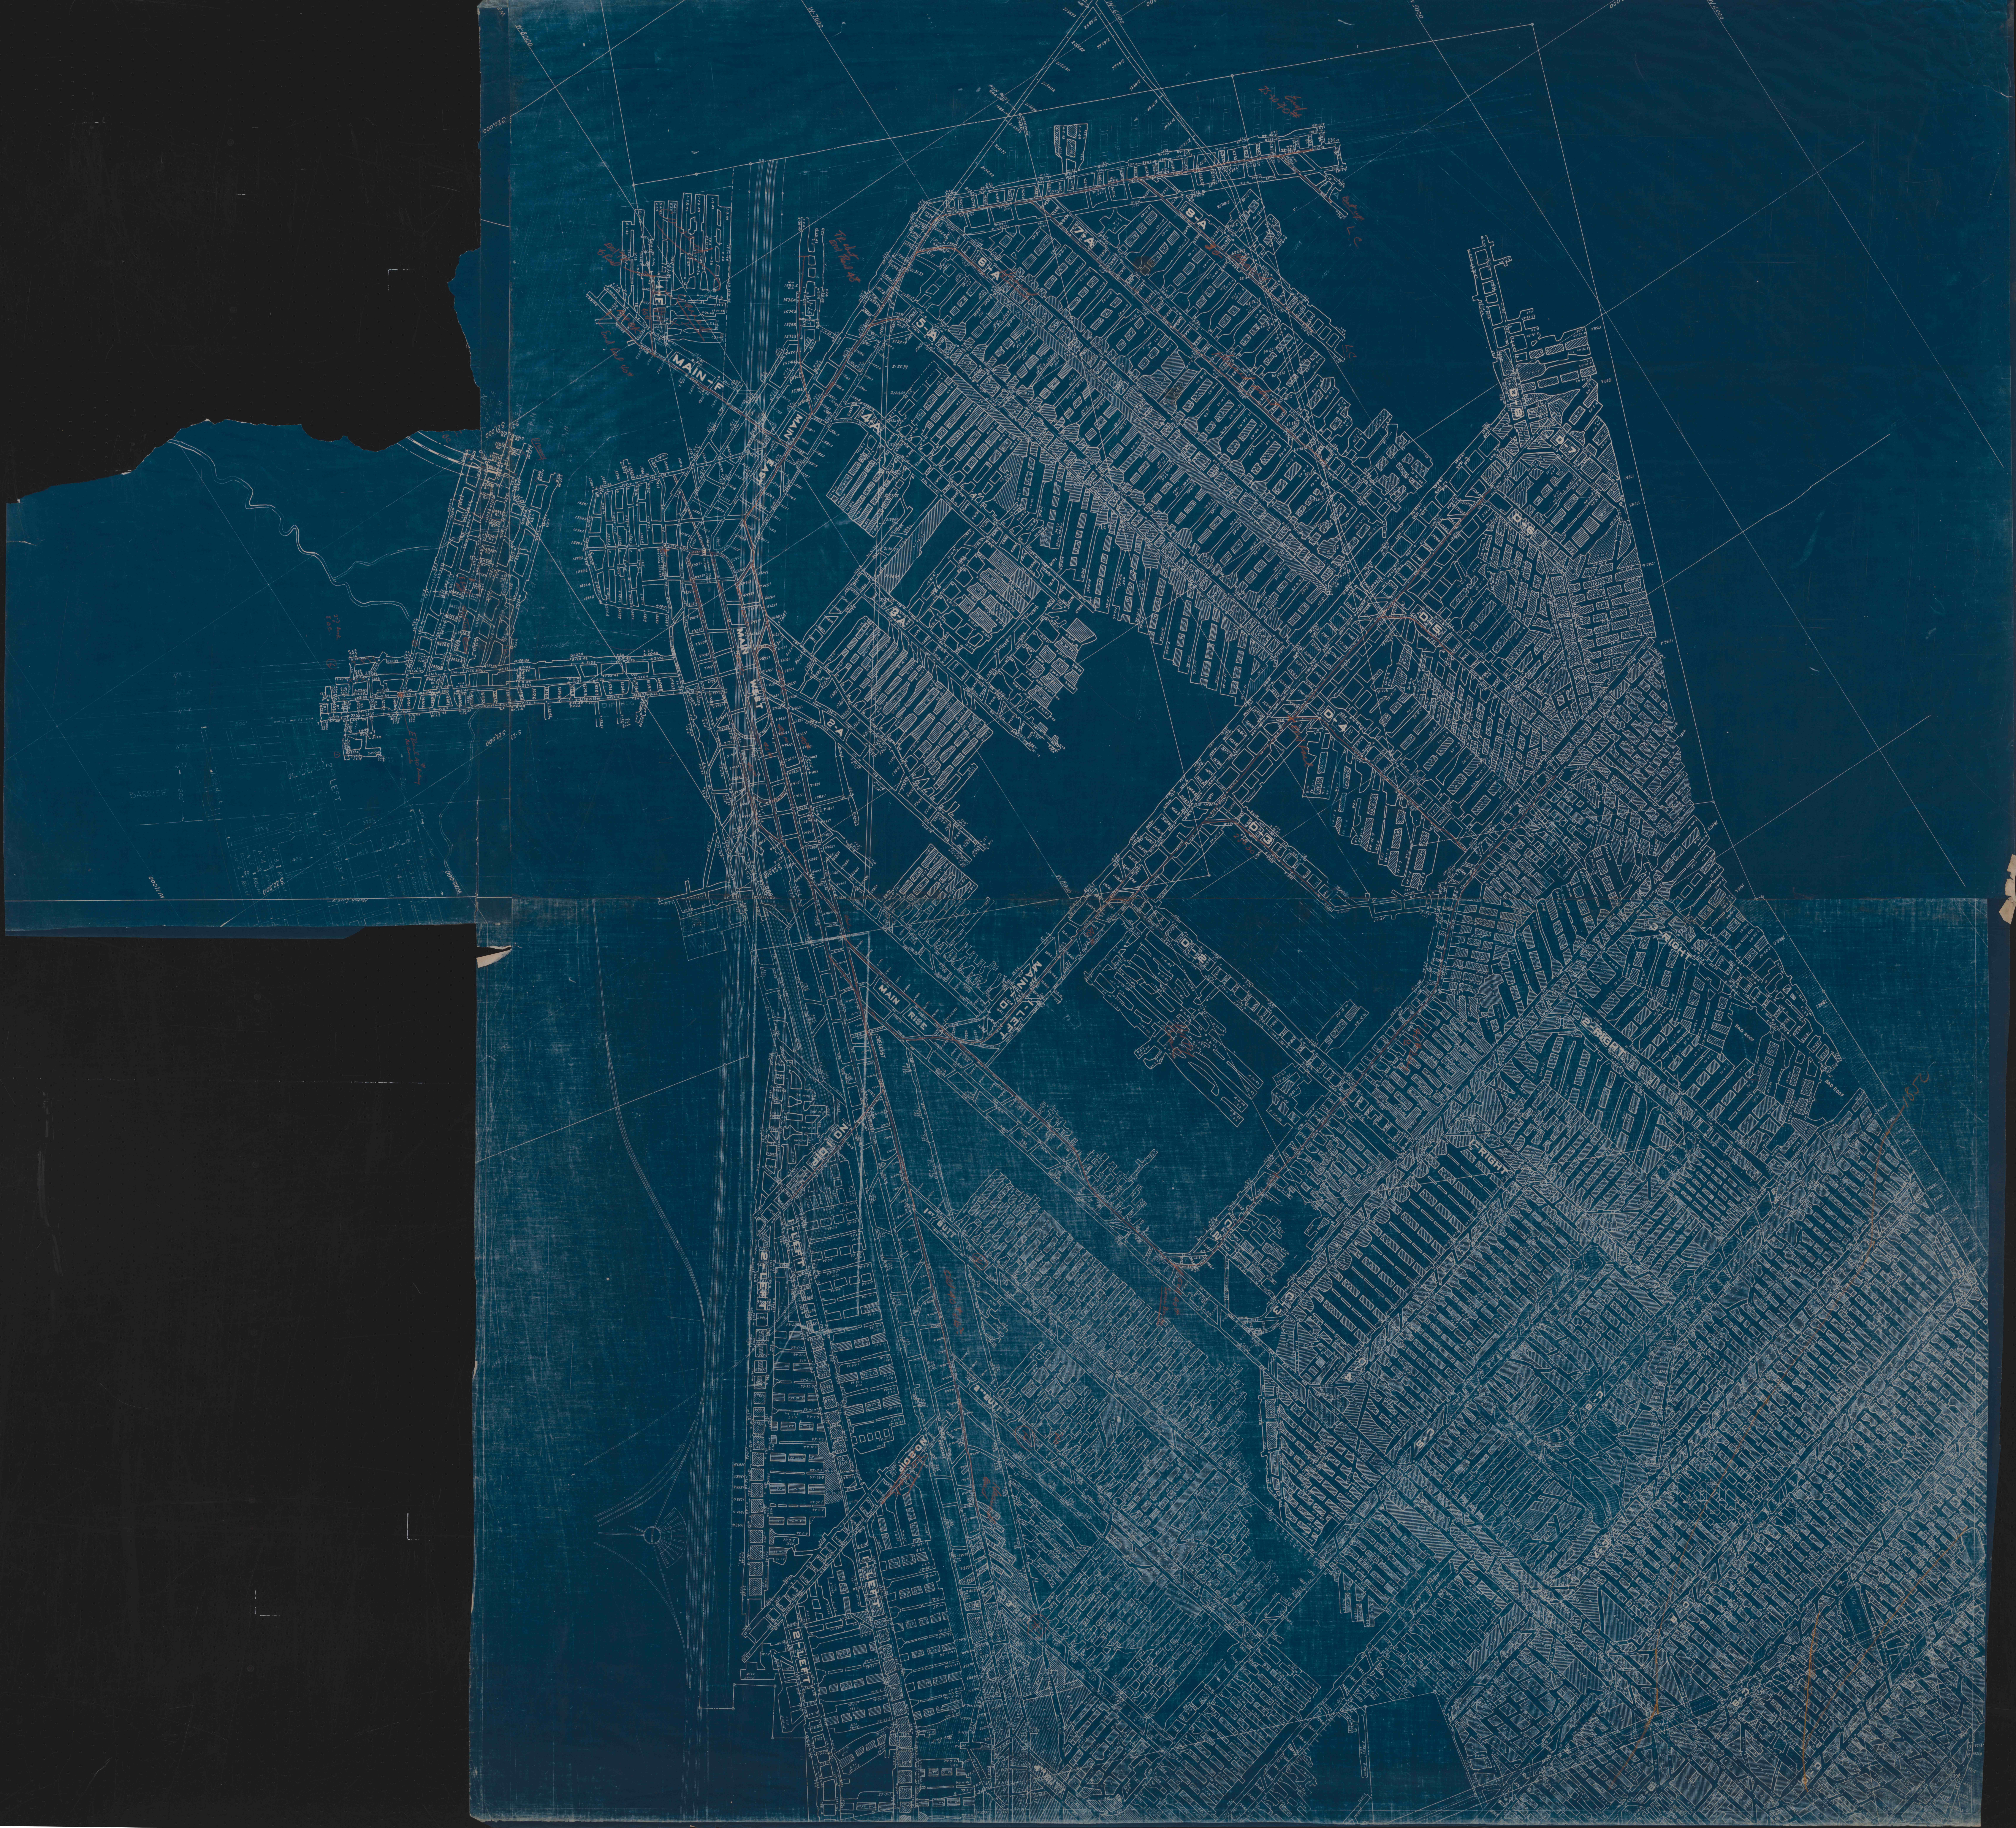
W-8000
W-7000
W-6000
N 5000
N 4000
S 21000
S 22000
W 11000
W 10000
1-F
MAIN-F
MAIN EAST
MAIN WEST
4-A
5-A
6-A
7-A
8-A
3-A
2-A
D-8
D-7
D-6
D-5
D-4
D-3
D-2
MAIN-D
1-LEFT
MAIN RISE
OVERCAST
NO 1 DIP
1st LEFT
2nd LEFT
1st BUTT
2nd BUTT
NO 2 DIP
1-LEFT
2-LEFT
3 RIGHT
2 RIGHT
1 RIGHT
BAD ROOF
C-2
C-3
C-4
C-5
C-6
C-7
C-8
C-9
BARRIER
2nd LEFT
Match Line
DIF HLG
L C
1852