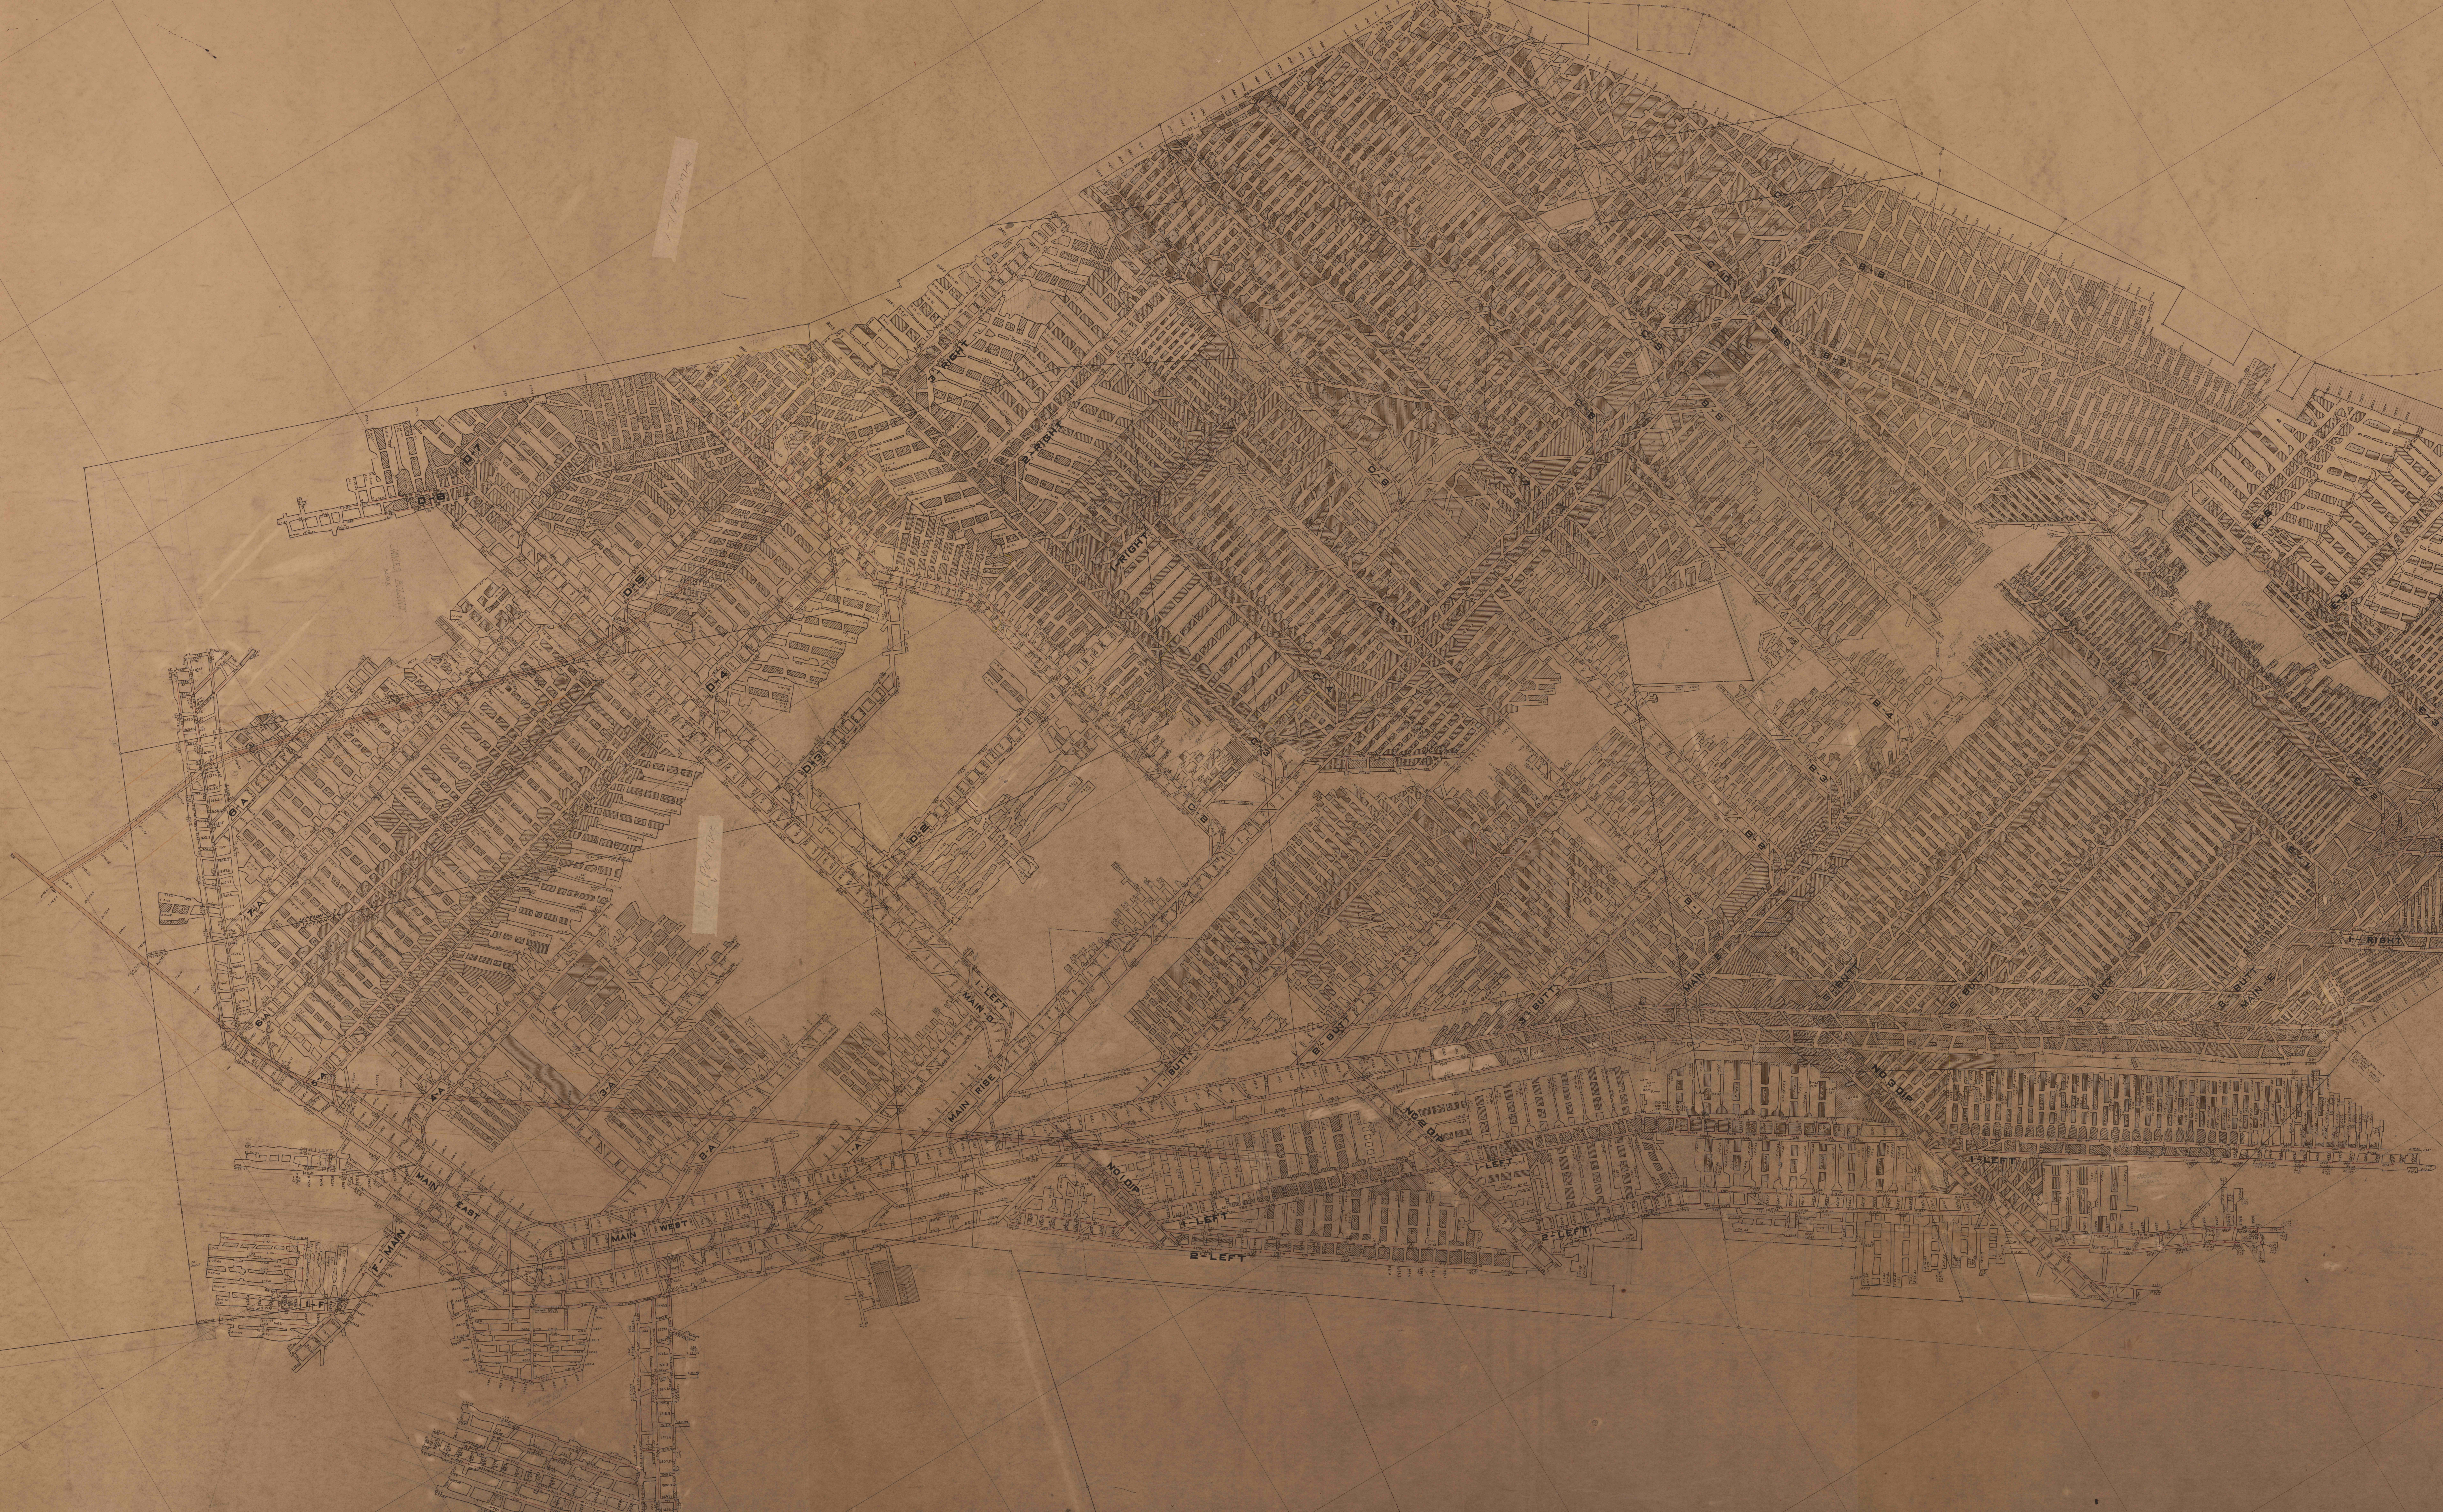

D-8
D-7
D-5
D-4
D-3
D-2
3-RIGHT
2-RIGHT
1-RIGHT
6-A
7-A
SECTION
5-A
4-A
3-A
8-A
1-A
1-LEFT
MAIN-D
MAIN RISE
1-BUTT
MAIN EAST
MAIN WEST
F-MAIN
1-F
NO 1 DIP
NO 2 DIP
NO 3 DIP
1-LEFT
2-LEFT
C-2
C-3
C-4
C-5
C-6
C-7
C-8
C-9
C-10
C-11
B-1
B-2
B-3
B-4
B-5
B-6
B-7
B-8
MAIN-B
3-BUTT
5-BUTT
6-BUTT
7-BUTT
8-BUTT
MAIN-E
E-1
E-2
E-3
E-4
E-5
E-6
E-8
3-RIGHT
2-RIGHT
1-RIGHT
DIRTY COAL
FAULT
BAD ROOF
WATER & BAD ROOF
1-L Positive