


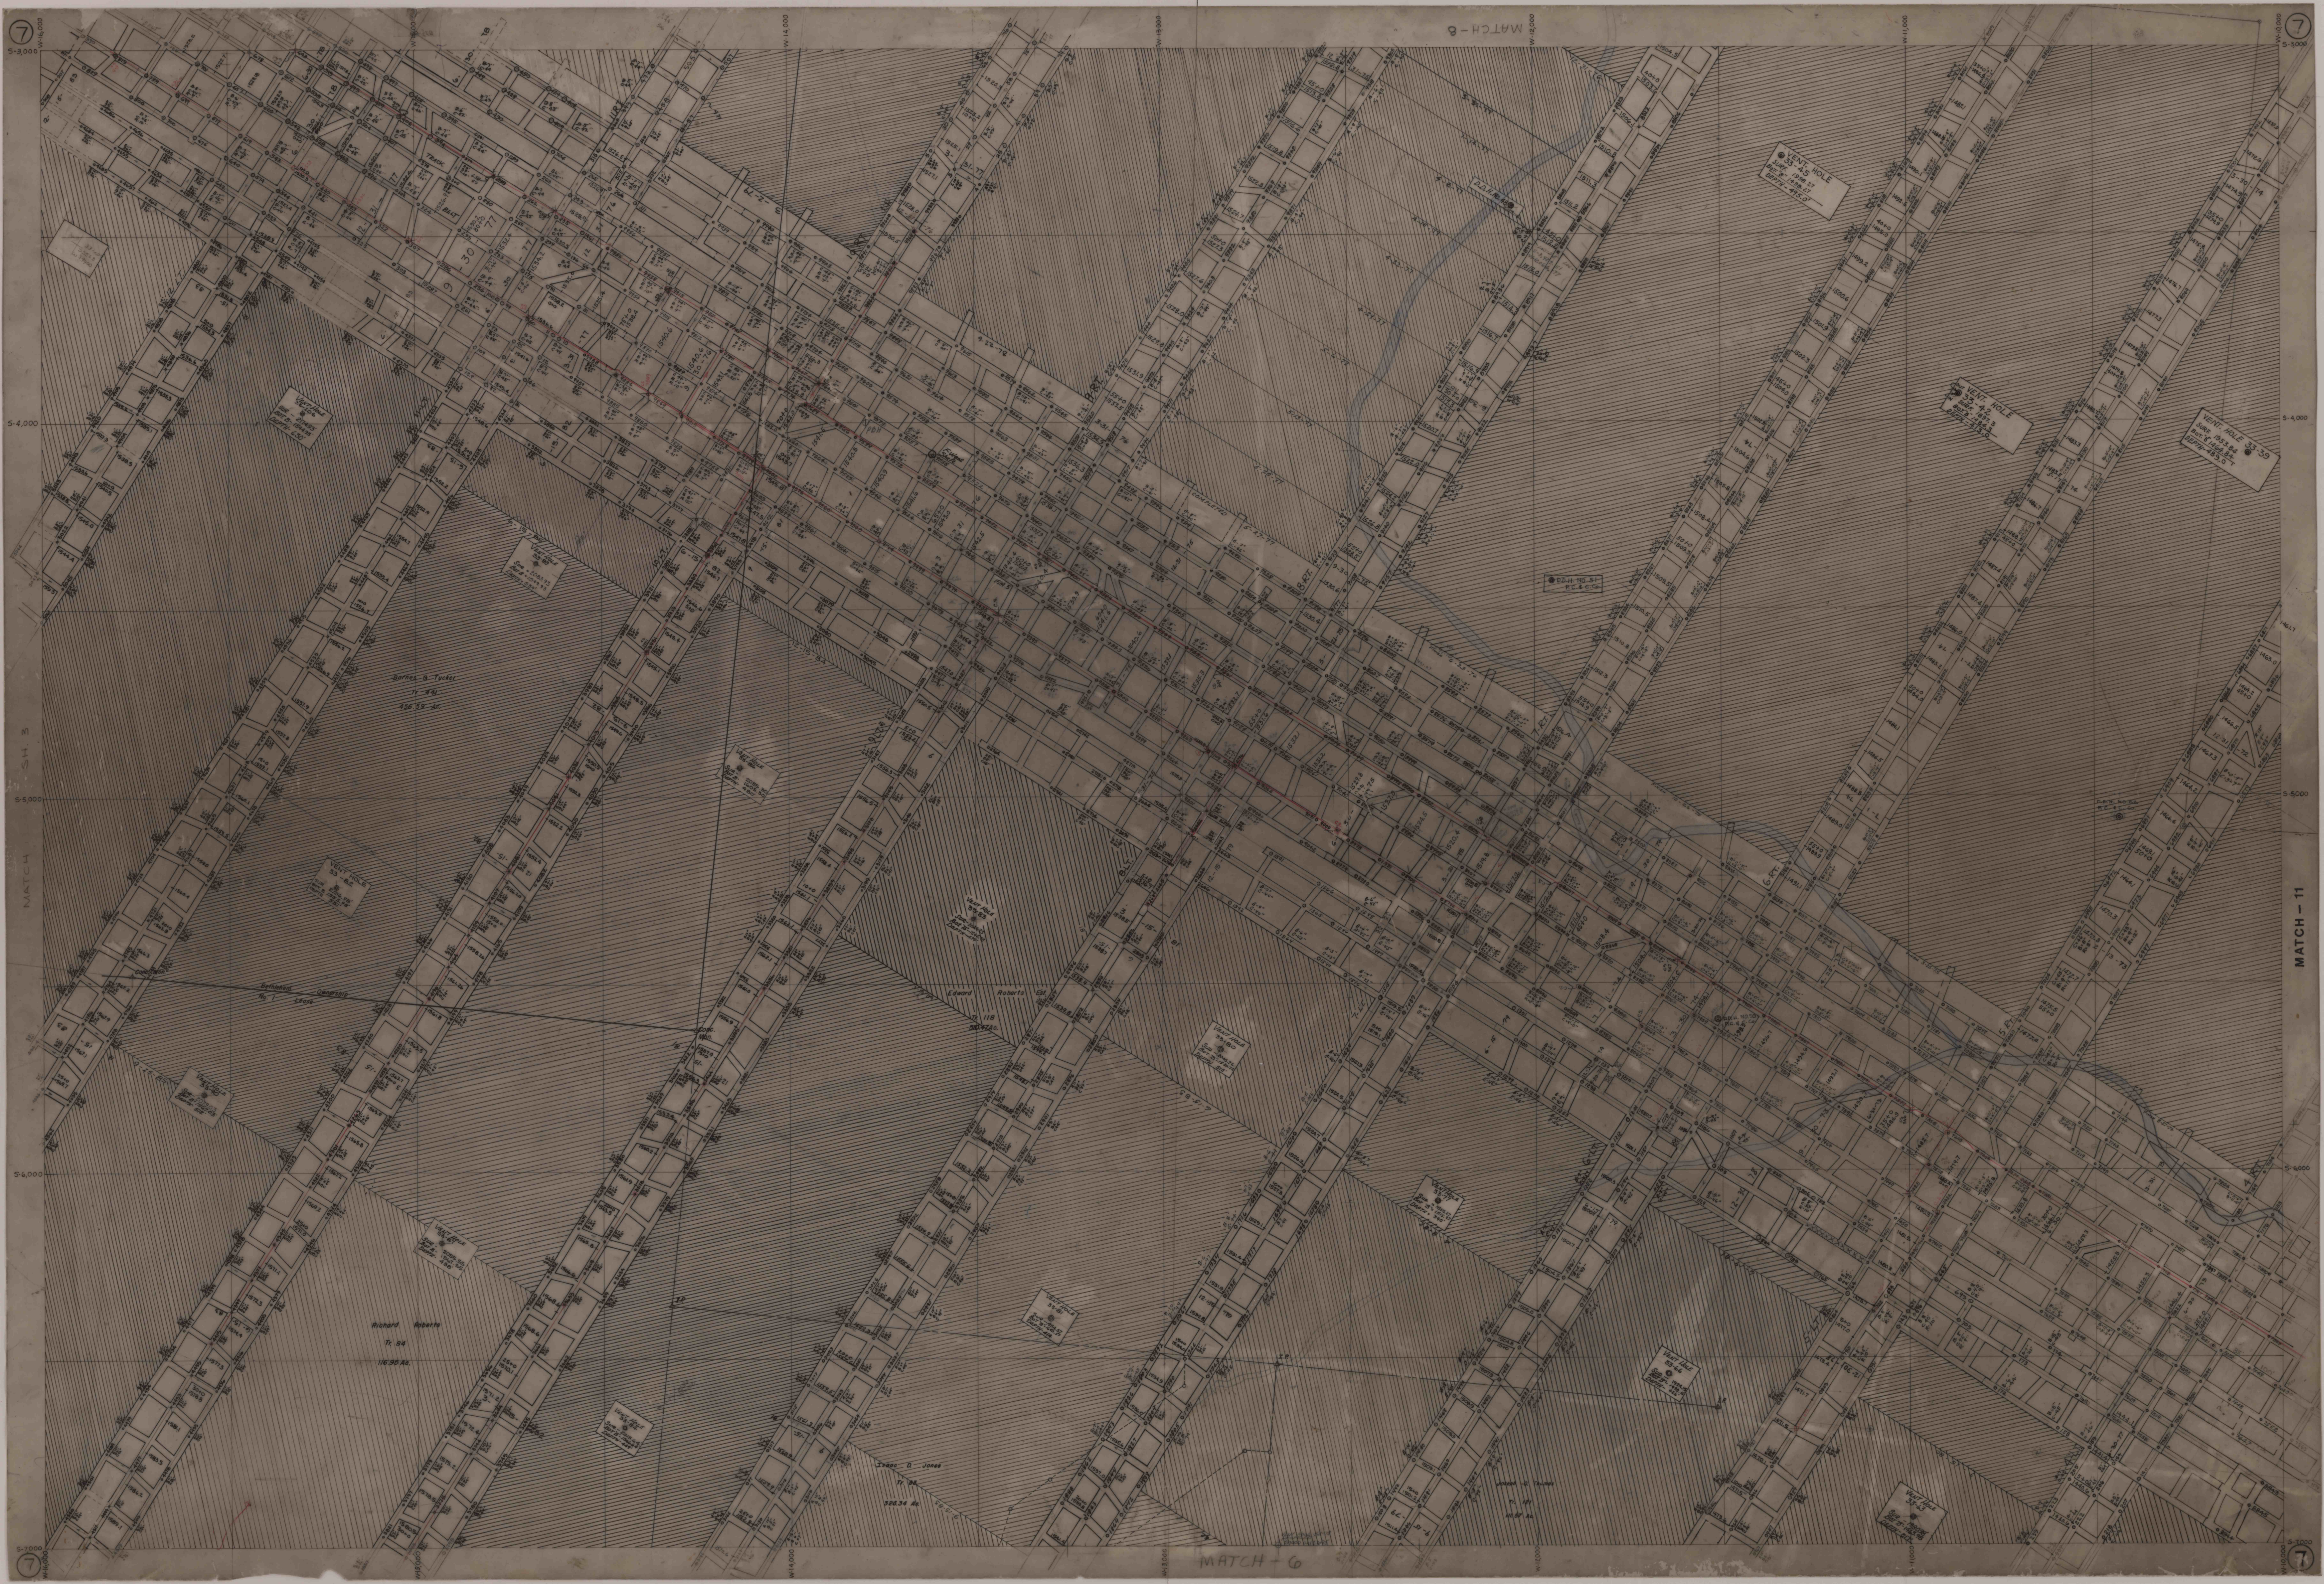

7

5-3,000

5-4,000

5-5,000

5-6,000

5-7,000

MATCH - 10

7


MATCH - 11

7